

# RECORD OF SURVEY MONUMENT RECOVERY

LOCATED IN THE SE 1/4 OF SECTION 7, IN THE SW 1/4 AND IN THE SE 1/4 OF SECTION 8, IN THE SW 1/4 OF SECTION 17, IN THE SE 1/4 OF SECTION 18, AND IN THE NW 1/4 OF SECTION 20, TOWNSHIP 3 SOUTH, RANGE 40 EAST, WILLAMETTE MERIDIAN, UNION COUNTY, OREGON

1000 0 1000 2000 3000

**SCALE:** 1"=1,000' APPROXIMATELY

## BASIS OF BEARINGS

NOT APPLICABLE

## LEGEND

(A) ■ FOUND SURVEY MONUMENT AS DESCRIBED


## REFERENCE MATERIAL

REFERENCE 1: OREGON DEPARTMENT OF TRANSPORTATION DRAWING NUMBER 5B-2-6 "ISLAND CITY-COVE SECTION-PART 2" (OREGON HIGHWAY 237), DATED AUGUST, 1935.

REFERENCE 2: OREGON DEPARTMENT OF TRANSPORTATION DRAWING NUMBER 6B-19-1 "COVE-UNION SECTION, COVE HIGHWAY, PART 1", TRACED FEBRUARY, 1946.

## MONUMENT DESCRIPTIONS

- (A) FOUND 3/4" DIAMETER SMOOTH IRON ROD, FLUSH IN GROUND, 0.4' SOUTH OF NORTH RIGHT-OF-WAY FENCE OF HIGHWAY 237, AT ENGINEER'S STATION 548+73.1 PT-40' LEFT-SEE REFERENCE 1. NOTE: THE CORRESPONDING MONUMENT AT THIS STATION 40' RIGHT WAS SEARCHED FOR AND NOT FOUND.
- (B) FOUND 3/4" SMOOTH IRON ROD, 0.1' ABOVE GROUND, 0.3' SOUTH OF NORTH RIGHT-OF-WAY FENCE OF HIGHWAY 237, WITH 4"X4" WOOD POST MKD: "SHRW POT 570+00.0" STANDING ALONGSIDE, AT ENGINEER'S STATION 570+00 POT-40' LEFT-SEE REFERENCE 1.
- (C) FOUND 3/4" SMOOTH IRON ROD, FLUSH IN GROUND IN SOUTH RIGHT-OF-WAY FENCE OF HIGHWAY 237, WITH 4"X4" WOOD POST MKD: "SHRW" LYING ALONGSIDE, AT ENGINEER'S STATION 570+00 POT-40' RIGHT-SEE REFERENCE 1.
- (D) FOUND 3/4" SMOOTH IRON ROD, 0.3' ABOVE GROUND, 0.5' NORTH OF SOUTH RIGHT-OF-WAY FENCE OF HIGHWAY 237, WITH 4"X4" WOOD POST MKD: "SHRW" STANDING ALONGSIDE, AT ENGINEER'S STATION 590+03.2 PI-40' RIGHT-SEE REFERENCE 1. NOTE: THE CORRESPONDING MONUMENT AT THIS STATION 40' LEFT WAS SEARCHED FOR AND NOT FOUND.
- (E) FOUND 3/4" SMOOTH IRON ROD, 1.3' ABOVE GROUND, IN NORTH RIGHT-OF-WAY FENCE OF HIGHWAY 237, WITH 4"X4" WOOD POST MKD: "POT SHRW" STANDING ALONGSIDE, AT ENGINEER'S STATION 600+00 POT-40' LEFT-SEE REFERENCE 1.
- (F) FOUND 3" DIAMETER BRASS CAP IN CONCRETE POST, BURIED 1.0'; MKD: "STATE HIGHWAY DEPARTMENT 843+29.71 PI"-SEE REFERENCE 2. MONUMENT IS ALONG THE NORTH SIDE OF AN E-W GRAVEL FIELD ACCESS ROAD AND IS DETECTABLE WITH A MAGNETIC LOCATOR.
- (G) FOUND 3" DIAMETER BRASS CAP IN A 0.6' DIAMETER CONCRETE POST, BURIED 0.4'; MKD: "STATE HIGHWAY DEPARTMENT 867+26.37 POST"-SEE REFERENCE 2. MONUMENT IS NORTH OF THE HIGHWAY, EAST OF THE CREEK, AND UNDER THE SOUTHEAST SIDE OF THE MOST SOUTHERLY HAWTHORNE TREE. MONUMENT IS DETECTABLE WITH A MAGNETIC LOCATOR.

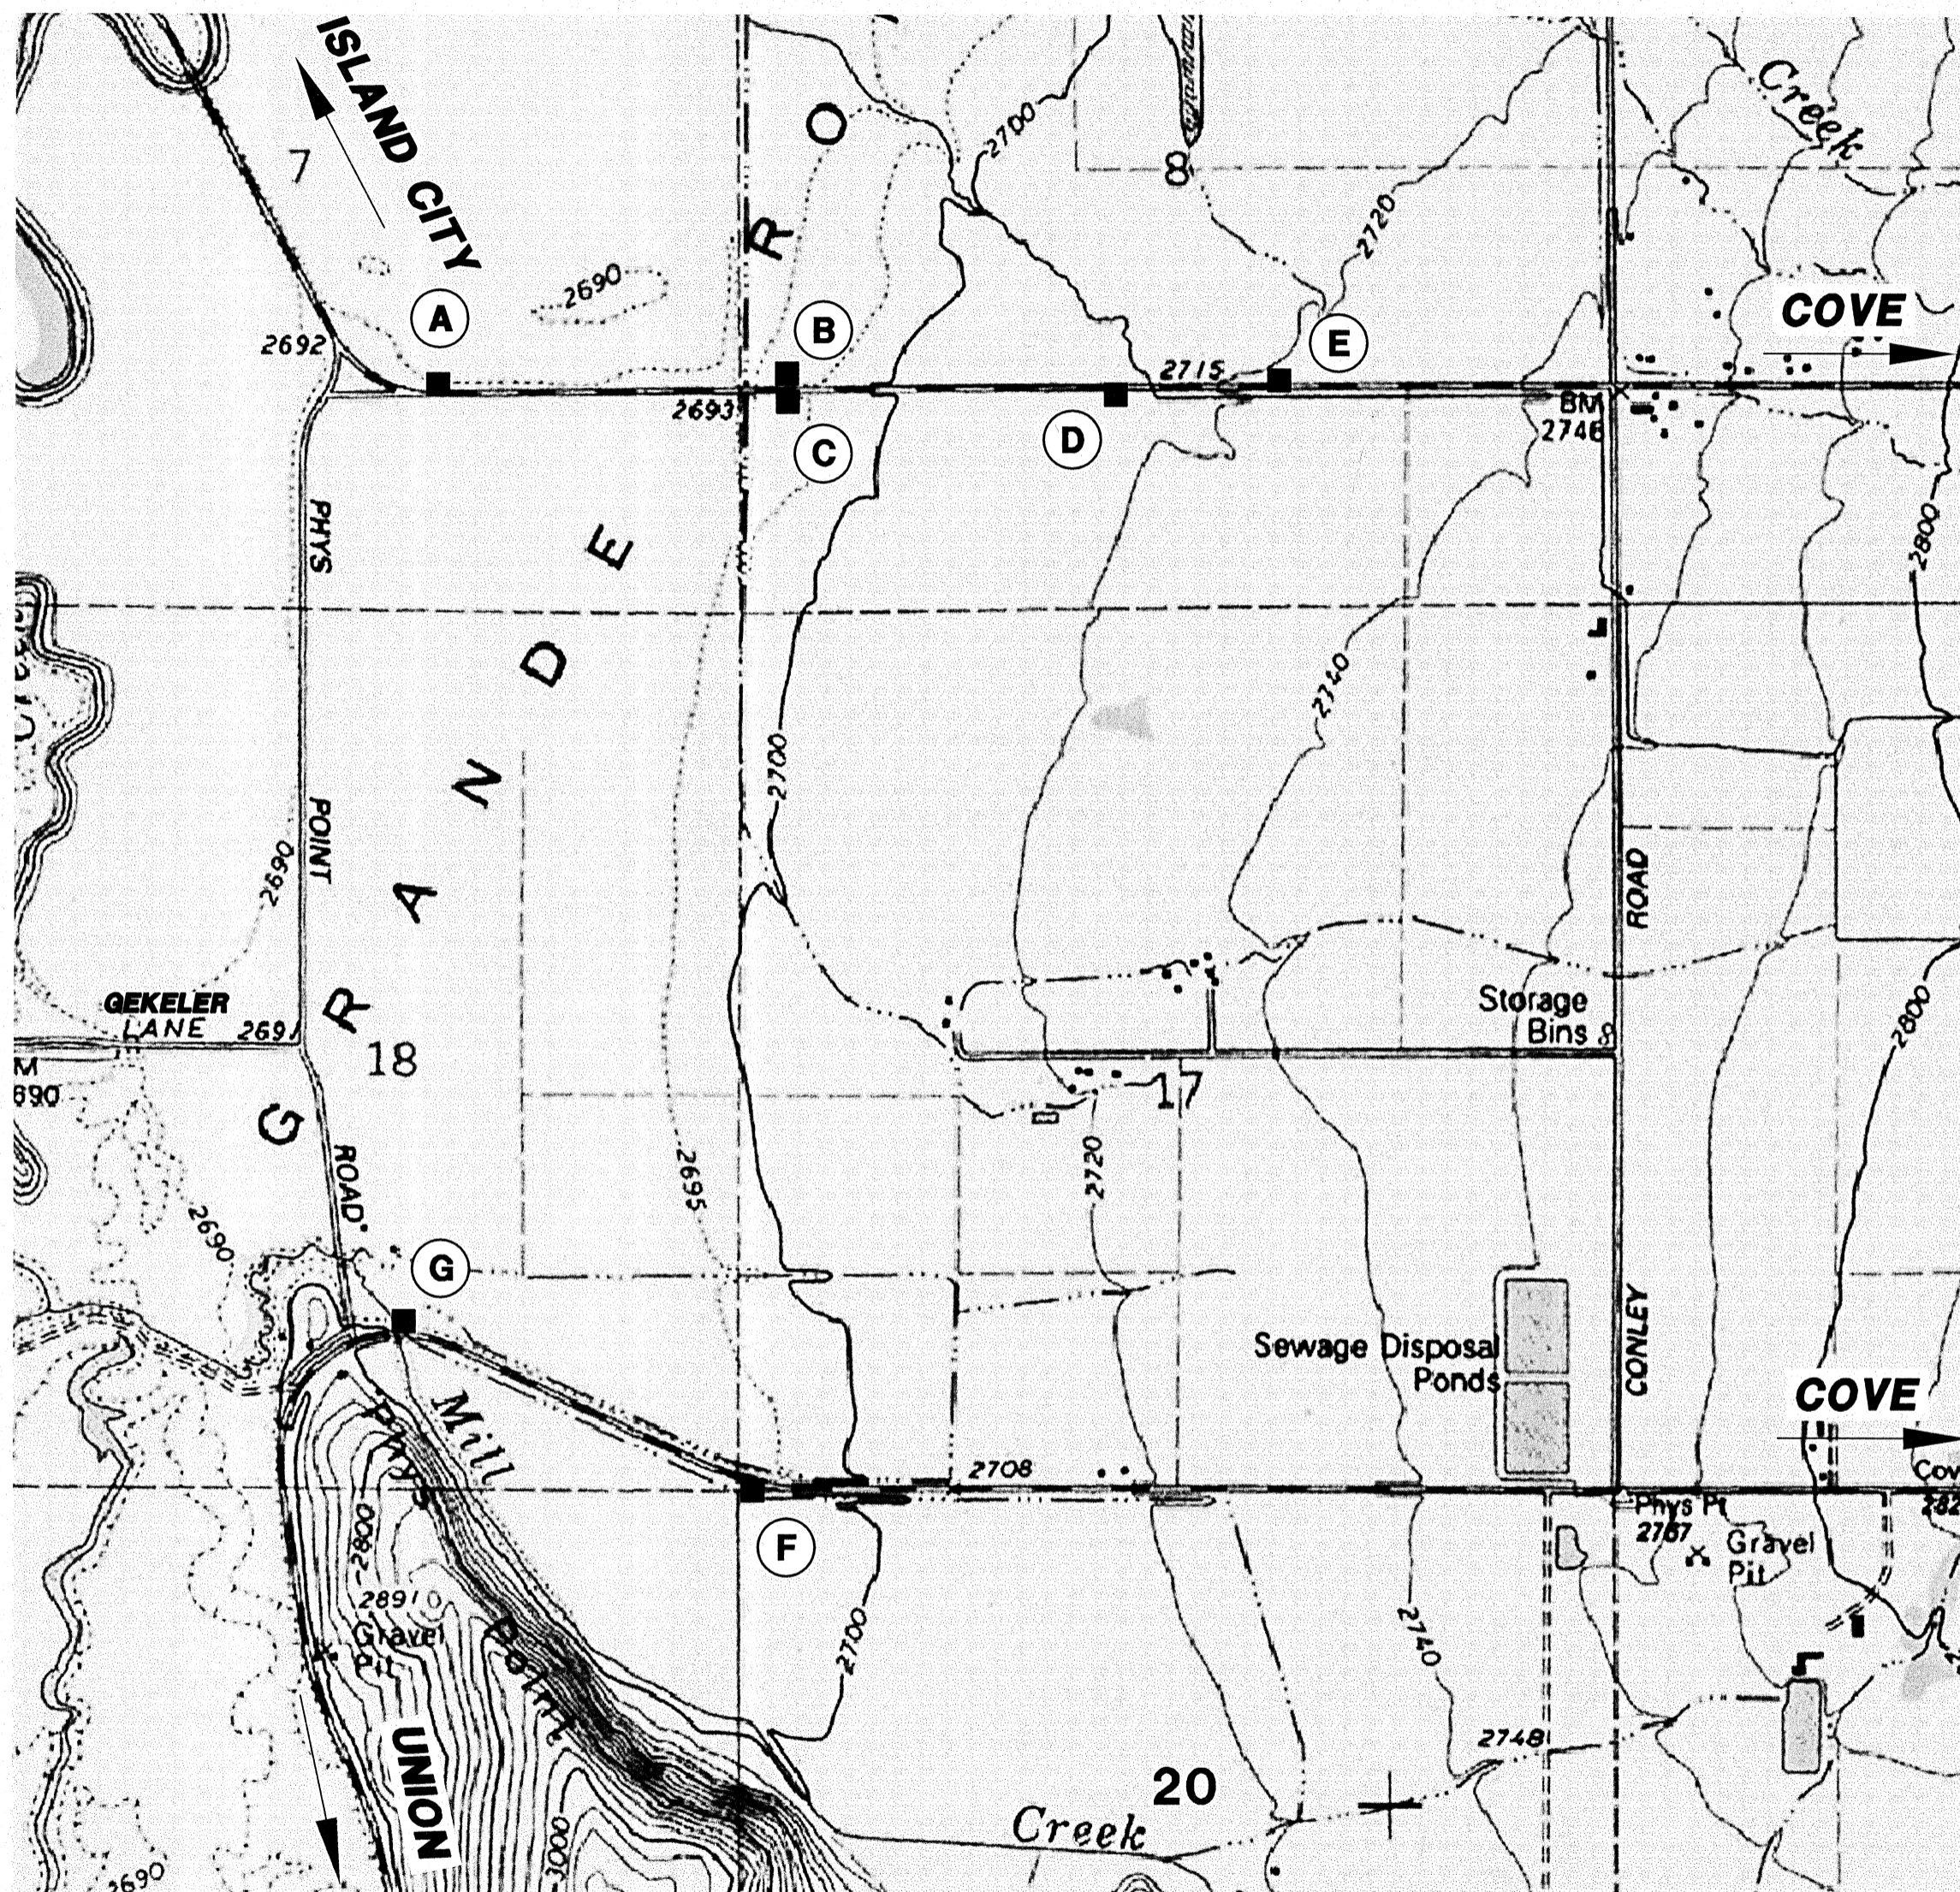

## SURVEY NARRATIVE

THIS SURVEY MAP HAS BEEN PREPARED TO DOCUMENT THE RECOVERY OF SEVERAL SURVEY MONUMENTS LOCATED ALONG THE ISLAND CITY-COVE HIGHWAY AND THE COVE-UNION HIGHWAY. THE RECOVERY OF THESE SURVEY MONUMENTS WAS INCIDENTAL TO AN ENGINEERING SURVEY BEING PERFORMED FOR THE CITY OF COVE FOR PURPOSES OF THE DESIGN OF MUNICIPAL WASTEWATER TREATMENT SYSTEM IMPROVEMENTS AND THE DESCRIPTION AND ACQUISITION OF RELATED UTILITY EASEMENTS. SINCE THIS ENGINEERING SURVEY IS NOT ANTICIPATED TO RESULT IN A SURVEY RECORDING, THIS SURVEY MAP HAS BEEN PREPARED TO PROVIDE A PUBLIC RECORD OF THE EXISTENCE AND CONDITION OF THESE SURVEY MONUMENTS.

THE MONUMENTS DESCRIBED HEREON WERE RECOVERED DURING MAY AND JUNE, 2009. ADDITIONAL SURVEY MONUMENTS MAY EXIST IN THESE AREAS WHICH WERE NOT SEARCHED FOR AS PART OF THIS ENGINEERING SURVEY.

REGISTERED PROFESSIONAL LAND SURVEYOR

OREGON  
JANUARY 20, 1998  
MICHAEL B. POSADA  
02849LS

EXPIRES: 12-31-10

DATED: 09-10-09

UNION COUNTY SURVEYOR

Date Received 9/14/09

Date Filed 9/14/09

By R. Raymond Davis

File No. 022-2009

## RECORD OF SURVEY MONUMENT RECOVERY

LOCATED IN THE SE 1/4 OF SECTION 7, IN THE SW 1/4 AND IN THE SE 1/4 OF SECTION 8, IN THE SW 1/4 OF SECTION 17, IN THE SE 1/4 OF SECTION 18, AND IN THE NW 1/4 OF SECTION 20, TOWNSHIP 3 SOUTH, RANGE 40 EAST, WILLAMETTE MERIDIAN, UNION COUNTY, OREGON

FOR: CITY OF COVE, OREGON

P.O. BOX 8  
COVE, OR 97824

SCALE:  
1"=1000'+-

DATE:  
SEPT. 2009

JOB NO.  
753-40

anderson  
berry  
& associates, inc.  
ENGINEERING · SURVEYING · NATURAL RESOURCES  
LA GRANDE, OR · WALLA WALLA, WA.

SHEET

1/1

1901 N. FIR ST. LA GRANDE, OR 97850 (541) 963-8309

SURVEY NUMBER 022-2009