

## BASIS OF BEARING

Forward bearing as published by the U.S.C.  
and G.S. from  $\Delta$  COLLEGE to  $\Delta$  VALLEY  
Dated 1946.

### SCALE: 1" = 40'

## LEGEND


- Found brass screw in lead plug, set by Survey Number 18-89
- ⊙ Set 1 1/2" brass plaque in concrete
- ( ) Record measurement as per Survey Number 18-89
- [ ] Record measurement as per Survey Number 53-79
- { } Record measurement as per Survey Number 64-77
- [[ ]] Record measurement as per Survey Number 028-2005
- (( )) Record measurement as per Survey Number 007-2009

## REFERENCE MATERIAL

Survey Number 63-77  
Survey Number 64-77  
Survey Number 77-78  
Survey Number 53-79  
Survey Number 24-85  
Survey Number 11-87  
Survey Number 18-89  
Survey Number 028-2005  
Survey Number 007-2009

## NARRATIVE

This survey was done at the request of Norm Paullus, Public Works director for the City of La Grande. Mr. Paullus wanted the monument at the intersection of 3rd Ave and H Street remonumented. The monument was originally a 3/4" iron pipe, set by McLain in the 1922 monumentation survey (18-89). In Survey Number 77-78, Greg Blackman recovers the monument, but notes that it has been disturbed. He again uses the position of the monument in Survey Number 053-79. I recover the monuments along 4th Street, as shown hereon. I run record bearing and distance as per Survey Number 007-2009 to place the position of G Ave and 3rd Street. To place the intersection of Third Street (South) and H Avenue I use a distance-distance intersection, using the distances of Survey Number 53-79. I extend the centerline of H. Ave. 7.00 feet to place the position for Third Street (North) and H Ave. I find no other unusual conditions with this survey.

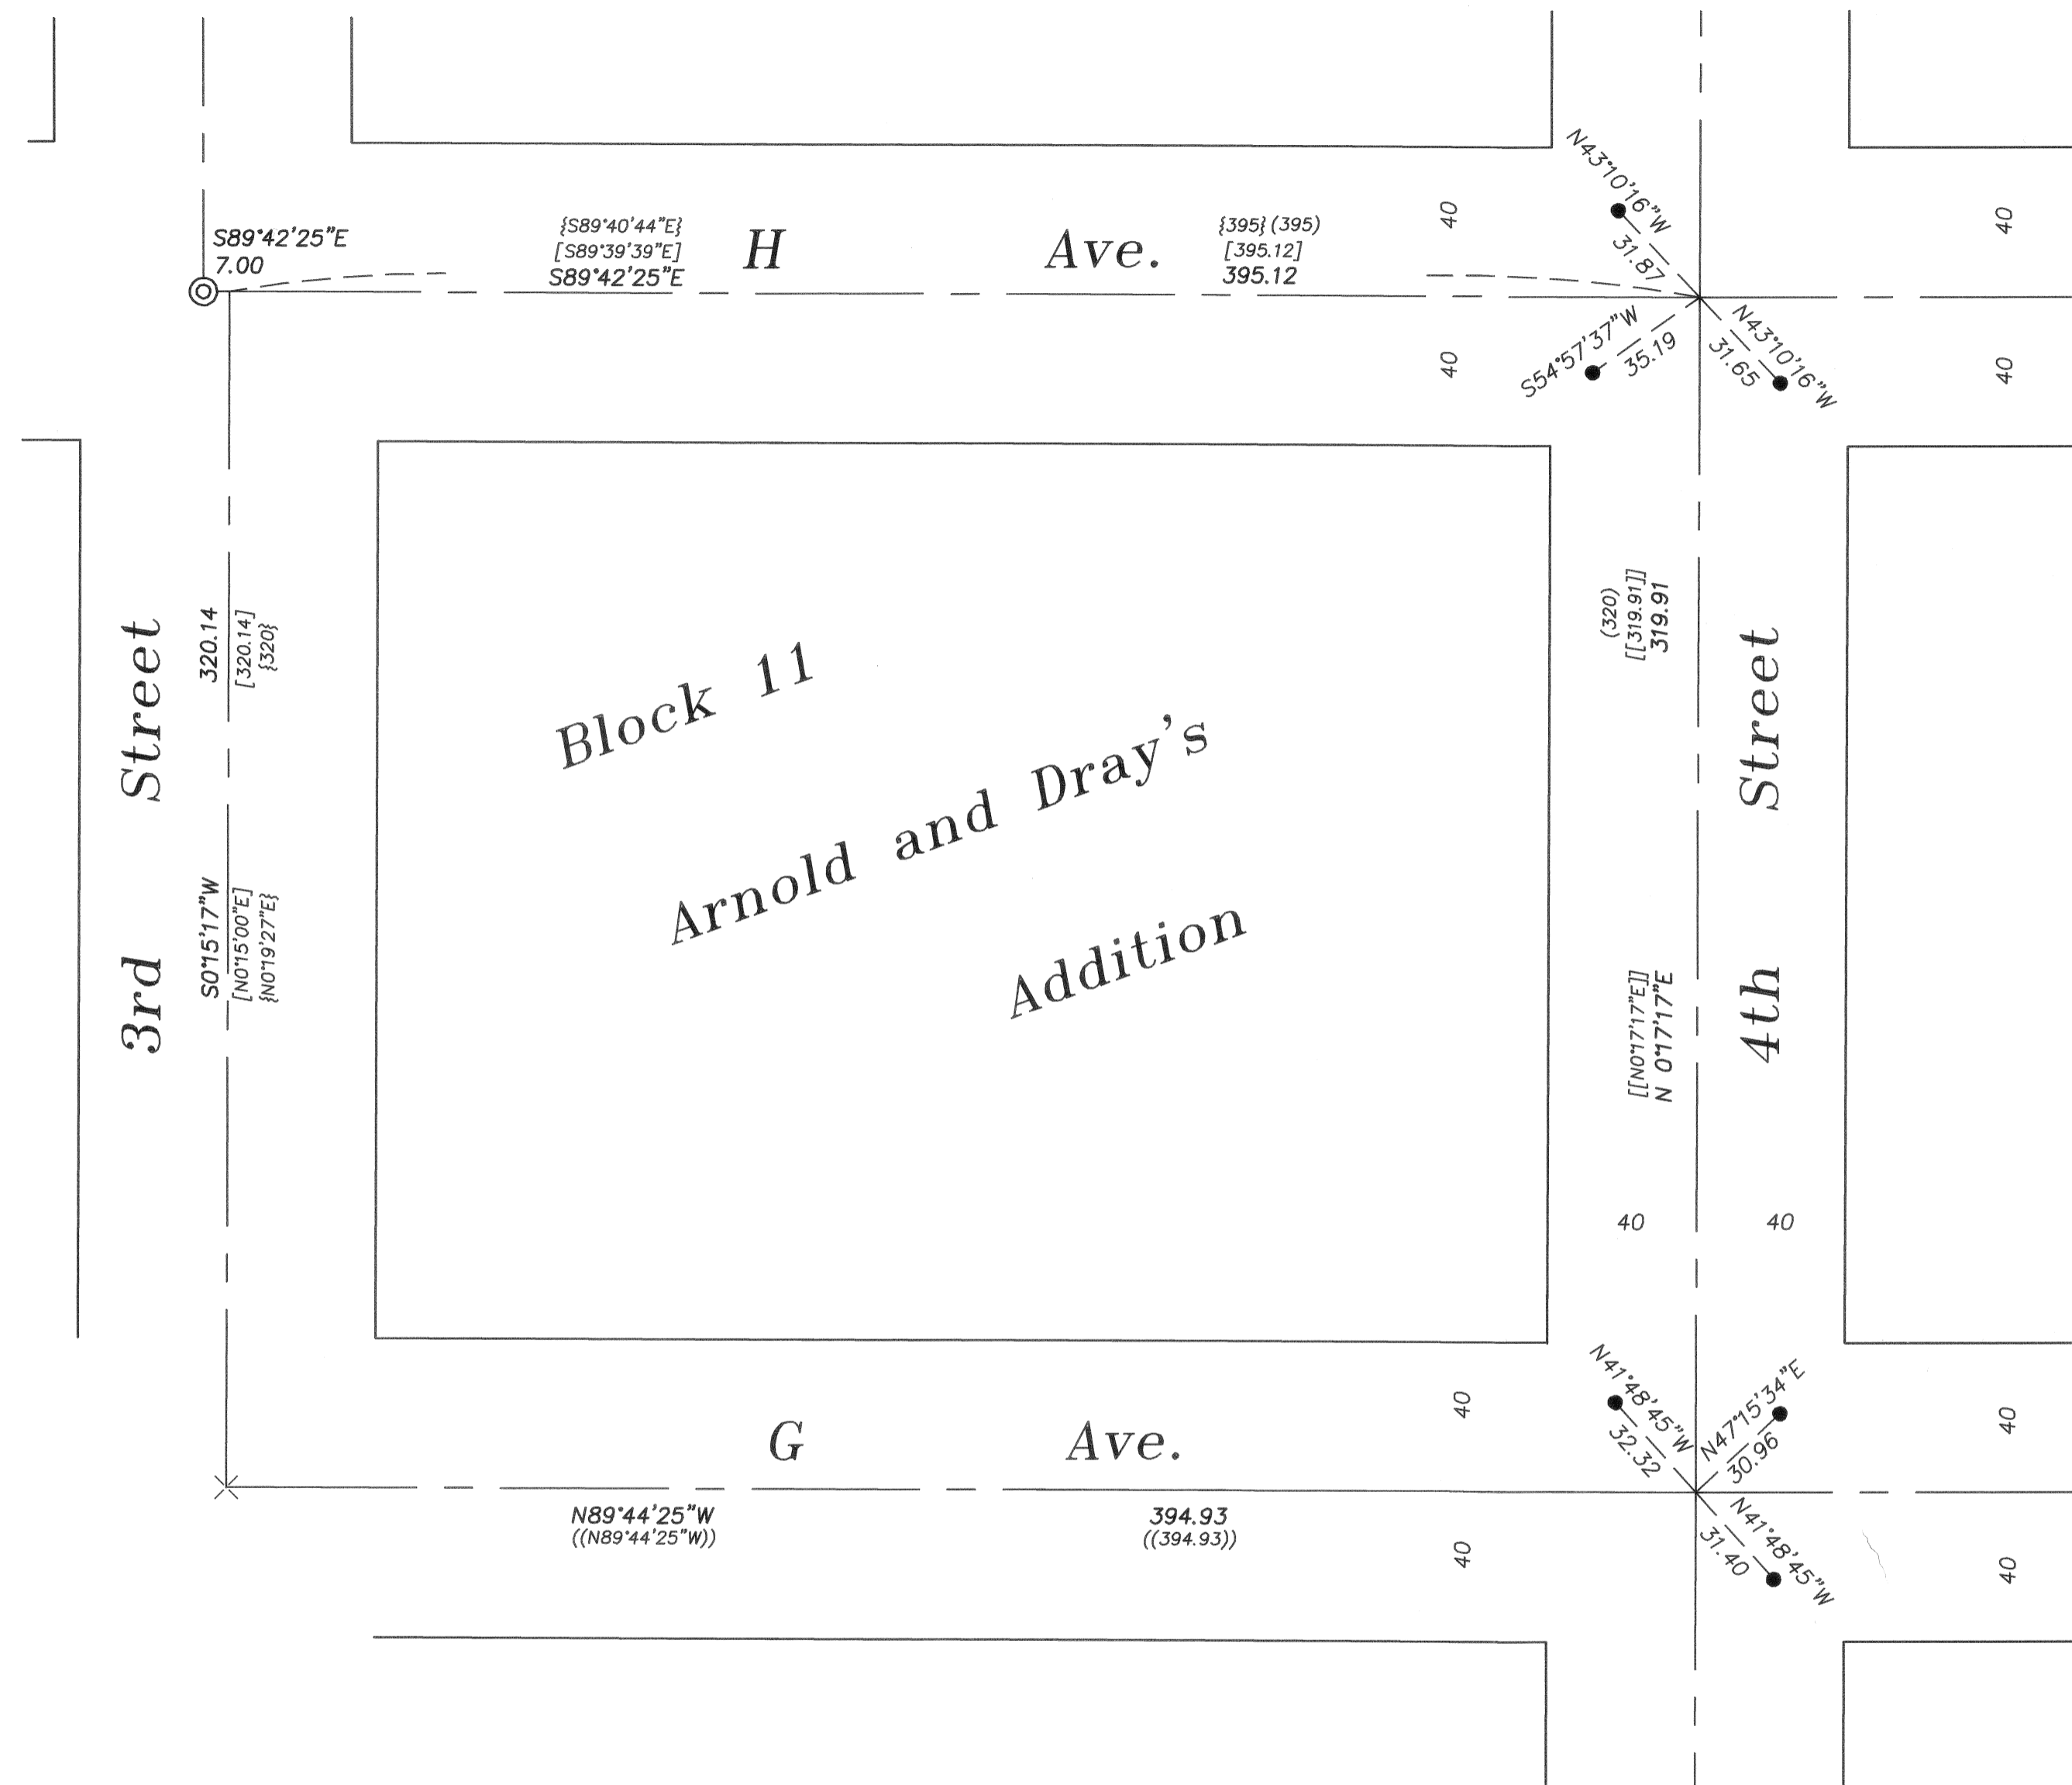

REGISTERED  
PROFESSIONAL  
LAND SURVEYOR

OREGON  
JUNE 2, 2010  
JEFFREY S. HSU  
83571

Renewal Date: June 30, 2011

UNION COUNTY  
SURVEYOR

Date Received 3/31/11

Date Filed 3/31/11

By R. ROBINSON, DCM

File No. 005-2011

BAGETT, GRIFFITH & BLACKMAN  
2006 Adams Avenue, LaGrande, Oregon

Map of Survey  
Remonumentation of intersection of H  
Avenue and 3rd Street, City of La Grande

UNION COUNTY, OREGON

SURVEYED FOR	City of La Grande		
SURVEYED BY	J. S. H.		
Scale: 1" = 40"	Drawn by: J. S. H.	Mar. 2011	

SURVEY NUMBER 005-2011