

BASIS OF BEARING

The North line of the Northwest quarter of Section 22 being South 89°02'50" East, as per Minor Partition Plat Number 20100001T as filed in the office of the Union County Clerk

SCALE: 1"=500'

REFERENCE MATERIAL

Field Notes from GLO Contract Number 320, dated April 1, 1879, executed by H.M. Thatcher


BLM Remonumentation Survey executed by Stephen D. Albright under special instructions dated May 3, 1957, included under Group Number 350

Field Notes from Dependent Resurvey conducted by Phillip G. Griffin, under Special Instructions dated July 13, 1979, June 26, 1990 and Supplemental Special Instructions dated May 14, 1991 included under Group No. 1000 and 1484

Survey Number 051-1994 Survey Number 006-1996 Minor Partition Plat Number 2010-0001T

NARRATIVE

This survey was done at the request of the Union County Surveyor. Minor Partition Plat number 20100001T partitioned a portion of the Southwest quarter of Section 22. In doing that, it was necessary to subdivide the Section. I did the partition for Walter Stephens on behalf of Stephens Forestry LLC. I located the corners previously set in the Southwest quarter of Section 22 and the North and East quarter corner of the Section. In doing that, it was discovered that the monument set for the Center 1/4 corner of the section was significantly out of position. I did not need to set that particular corner for the partition. I contacted Linda Miller, who did the survey that set the monument (Survey No. 006-1996). She was not interested in correcting or resetting the monument. Some time later, the office of the Union County Surveyor was contacted by Larry Davidson, manager for the LDS land also affected by the erroneous corner. It was agreed that the office of the County Surveyor would set a monument in the correct position. That is the purpose of this survey. I have also filed a monumentation sheet documenting the new monument and its' accessories. I find the conditions the same as when I did the partition in 2010. I find no other unusual conditions on this survey.

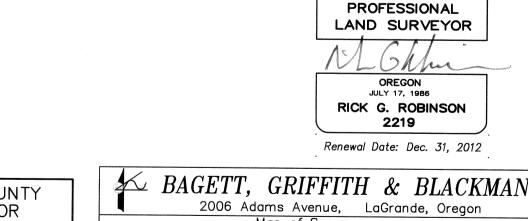

UNION COUNTY
SURVEYOR

Date Received 8/17/2012

Date Filed 8/17/2011

By Hyny T. Blackmen

File No. 029-2012

	Map of Survey Remonumentation of the Center 1/4 corner of Section 22, Township 5 South, Range 41 East of the Willamette Meridian. UNION COUNTY, OREGON			
	SURVEYED FOR	Union County Surveyor		
	SURVEYED BY	R.G.R.		8/2012
	Scale: $1" = 500'$		Drawn by: R.G.R.	8/2012

REGISTERED