
## GALLATIN

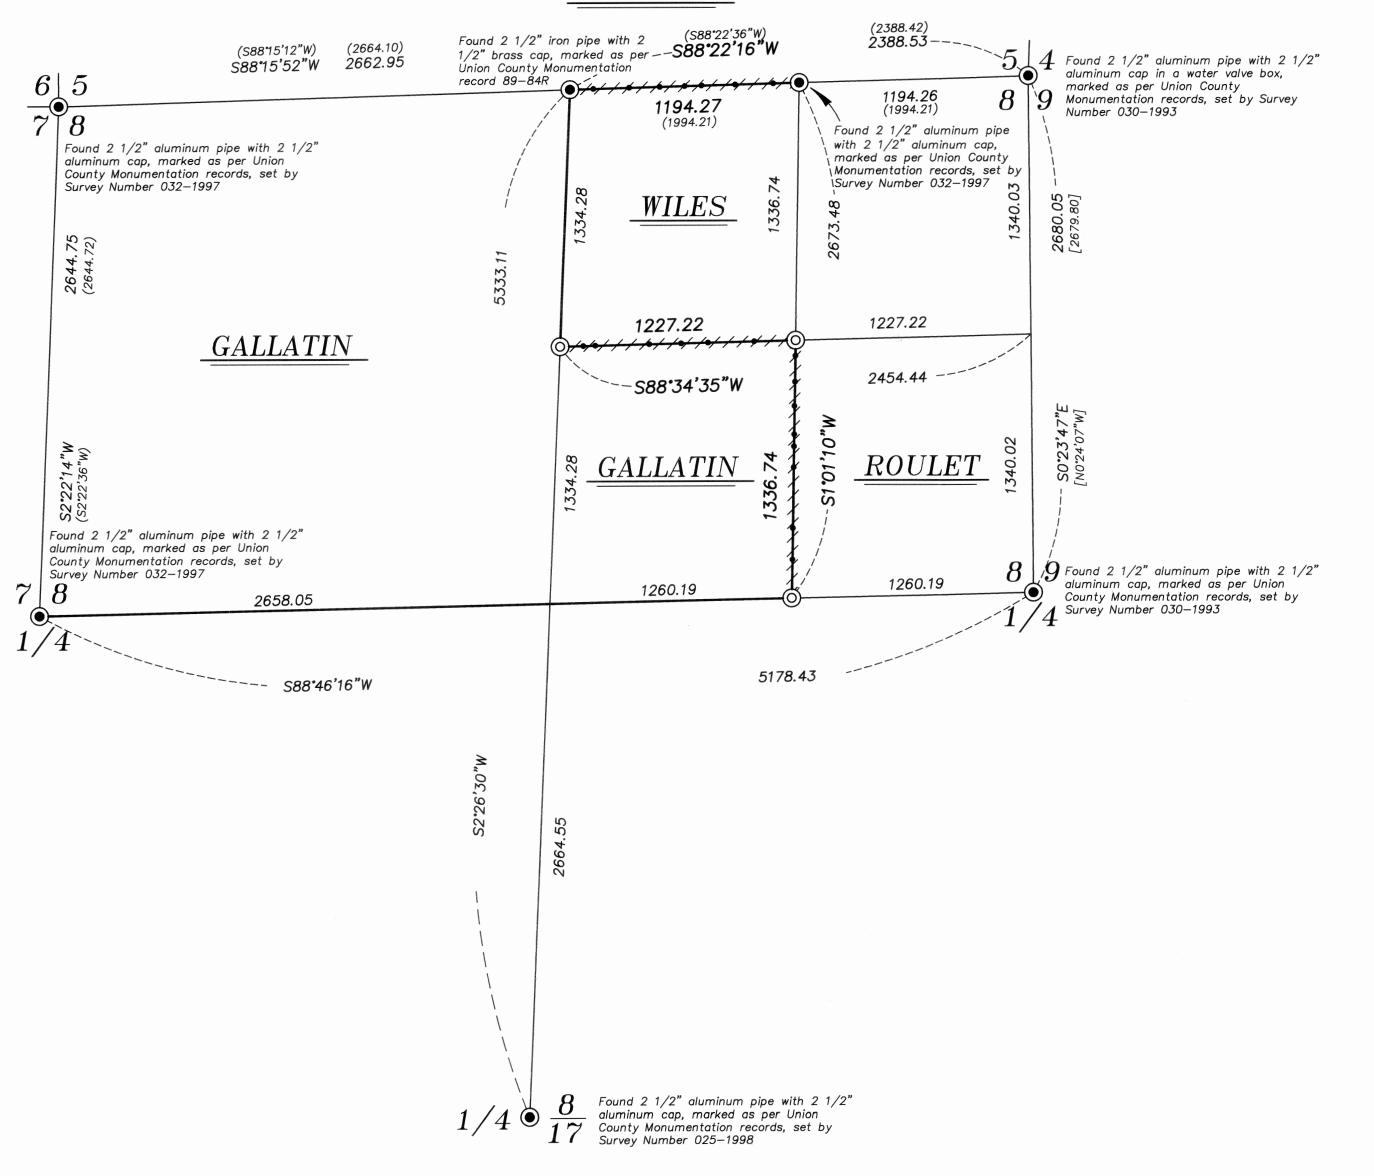

# BASIS OF BEARING

Solar observation taken at the North quarter corner of Section 15, Township 1 North, Range 39 East of the Willamette Meridian.

SCALE: 1"=500'

### LEGEND

Found monument as noted, as per Union County Monumentation Records

Set 5/8" x 30" iron pin with 2 1/2" aluminum cap, marked as per Union County Monumentation Records, filed separately

) Record measurement as per Survey Number 032—1997

Record measurement as per Survey Number 030—1993

Line marked with steel fenceposts

Steel fencepost set on line

 $\odot$ 

#### REFERENCE MATERIAL

Union County Monumentation Records Survey Number 030—1993 Survey Number 032—1997 Survey Number 025—1998

#### DEED REFERENCES

Microfilm Document Number 130551 Microfilm Document Number 20061621 Microfilm Document Number 20083750

#### *NARRATIVE*

This survey was done at the request of Steve McClelland, on behalf of Hancock Forest Management, land manager for property currently vested in Gallatin NE Oregon Land and Timber. Mr. McClelland wanted the line shown hereon surveyed and marked with steel fenceposts. I recover the monuments as shown and subdivide the section as per BLM Manual of Instructions (2009). I find no unusual conditions with this survey.

REGISTERED
PROFESSIONAL
LAND SURVEYOR

OREGON
JUNE 2, 2010
JEFFREY S. HSU
83571

Renewal Date: June 30, 2013

UNION COUNTY
SURVEYOR

Date Received 10/11/17

Date Filed 10/11/12

By R. Rokinson Depoty

File No. 032-7012

# BAGETT, GRIFFITH & BLACKMAN 2006 Adams Avenue, LaGrande, Oregon Map of Survey Situated in Section 8, Township 1 North, Range 39 East of the Willamette Meridian UNION COUNTY, OREGON

SURVEYED FOR Hancock Forest Management

SURVEYED BY J. S. H.

Scale: 1" = 500' Drawn by: J. S. H. Sept.-Oct. 2012