

29 28
32 33

[80.00 chs.]
5361.53

Corner searched for,
not found

[NORTH]
N0°18'59"E

SPOKANE

LONG CANYON

TOWNSHIP 1 SOUTH

32 33
5 4

S89°55'11"W
(N89°58'W)

2680.80
(40.00 chs.)

TOWNSHIP 2 SOUTH

1/4 33
4

1340.54

S89°56'14"W
(N89°58'W)

E 1/16 33
4

2681.09
(40.00 chs.)

1340.55

33 34
4 3

SANDPOINT

REFERENCE MATERIAL

Union County Monumentation Records
Umatilla County Monumentation Records

GLO Field Notes for Contract No. 452, executed by Herman D. Gradon, dated June 16, 1882

GLO Field Notes for Contract No. 201, executed by John A. Hurlburt, dated August 5, 1873

NARRATIVE

This survey was performed at the request of Steve McClelland on behalf of Hancock Forest Management, land manager for the lands within. Mr. McClelland wanted the lines shown hereon marked with paint and flagging for timber sale purposes. The South quarter corner was found by David Dahlstrom in 1973, as is recorded in Union County monumentation record number 173-87R. I found the original GLO evidence in place as described by Dahlstrom with a steel fence post with BLM K-tag attached, and place the monument at the found stone position. The corner evidence at Southeast corner of Section 33 was also found by Dahlstrom in 1973 as is recorded in Union County Monumentation record 174-87R. He finds the Southeast and Southwest bearing accessories alive and in good condition and the Northwest tree dead and downed. Significant logging has occurred in the area and the live bearing trees found by Dahlstrom have since been removed. I find a steel fence post with BLM K-tag and a downed larch tree with bearing tree tag to the Northwest. From the steel fence post, a 30 inch pine stump matches the bearing and distance by GLO records and a depression where a root hole may have been falls at record bearing and distance to the Southwest bearing tree. I place the corner at record bearing and distance from the pine stump.

I make a diligent search for the West quarter corner of Section 33. There has been extensive logging in the area and I find no evidence of the original corner. I place the sixteenth corner as per BLM Manual of Instructions 2009. The names shown hereon are internal divisions within the Hancock Forest Management group.

I find no other unusual conditions with this survey.

BASIS OF BEARING

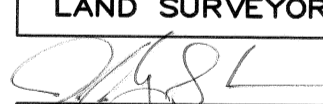
True Geodetic North at the corner common to Section 33 and 34, Township 1 South and Section 3 and 4, Township 2 South, Range 36 East of the Willamette Meridian, as determined by GPS observation (NAD-83 (1991) datum)


SCALE: 1"=500'

LEGEND

- Found 3" brass cap on 2 1/2" iron pipe, set by Douglas Ferguson from original GLO evidence (see Umatilla County monumentation record H-164-R and H-160-R)
- ⊙ Set 2 1/2" aluminum pipe with 2 1/2" aluminum cap from original GLO evidence, marked as per Union County monumentation records, filed separately
- Set 5/8"x30" iron pin with 2 1/2" aluminum cap, marked as per Union County monumentation records, filed separately
- () Record measurement as per GLO Field notes for Contract No. 201, executed by John Hurlburt
- [] Record measurement as per GLO Field notes for Contract No. 452, executed by Herman Gradon
- Set steel fencepost on line
- //// Line marked with flagging and paint on adjacent trees

UNION COUNTY SURVEYOR	
Date Received	11/12/12
Date Filed	11/12/12
By	R. Robinson, Deputy
File No.	036-2012

REGISTERED PROFESSIONAL LAND SURVEYOR

OREGON JUNE 2, 2010
JEFFREY S. HSU 83571
Renewal Date: June 30, 2013

 BAGETT, GRIFFITH & BLACKMAN		
2006 Adams Avenue, LaGrande, Oregon		
Map of Survey		
Sited in Section 33, Township 1 South, Range 36 East of the Willamette Meridian		
UNION/UMATILLA COUNTY		
SURVEYED FOR	Hancock Forest Management	
SURVEYED BY	J. S. H.	
Scale: 1" = 500'	Drawn by: J. S. H.	Oct.-Nov. 2012

SURVEY NUMBER 036-2012