

BASIS OF BEARING

The North line of Section 35, Township 4 South, Range 38 East of the Willamette Meridian being South 89°46'53" West, as per Survey Number 015-2003

SCALE: 1"=600'

LEGEND

- Found monument as described, marked as per Union County Monumentation records
- Found 2 1/2" Aluminum pipe with 2 1/2" aluminum cap, set by Survey Number 015-2003, marked as per Union County monumentation records
- Set 5/8" x 30" iron pin with 2 1/2" aluminum cap, marked as per Union County monumentation records
- Record measurement as per field notes of GLO Contract No. 103
- () Record measurement as per field notes of GLO Contract No. 388

Existing fenceline

(4)

REFERENCE MATERIAL


Union County Monumentation Records Survey Number 015—2003

Field Notes of GLO Contract Number 102, executed by Timothy W. Davenport, dated July 20, 1863

Field Notes of GLO Contract Number 388, executed by W.B. Barr, dated May 7, 1881

NARRATIVE

This survey was done at the request of Steve McClelland, on behalf of Hancock Forest Management, land manager of the lands owned by Tristar NE Oregon Timberlands. Mr. McClelland wanted to monument and mark the exteriors of the property against the Northeast quarter of the Northeast quarter of Section 35. I base this section break on that done by Survey Number 015–2003. I recover the monuments set by said survey and find them in position. I break the section as per BLM Manual of Instructions 2009. The existing fenceline encroaches by a significant amount, as shown hereon. I set steel fenceposts along the South line of the Northeast quarter of the Northeast quarter. I find no other unusual conditions with this survey.

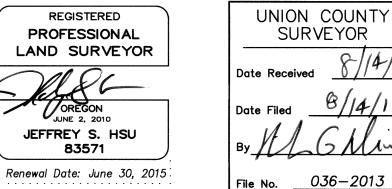

BAGE'	TT,	GRIFFITH & B	LACKMAN
2006 Ádams Avenue, LaGrande, Oregon			
Map of Survey			
Subdivision of Section 35, Township 4 South, Range 38 East of the Willamette Meridian			
UNION COUNTY, OREGON			
SURVEYED FOR	Hancock Forest Management		
SURVEYED BY	J. S. H.		
Scale: 1" = 600'		Drawn by: J. S. H.	Aug. 2013