


MAP
OF
CHAUNCEY WALKER TRACT
Showing Veterans' Basement
And municipal facilities.
Surveyed and platted Dec 1947.
By H.L. Melton Licensed Prof. Engr.
Oregon No. 1337 - Scale 1"=10'
La Grande, Ore.

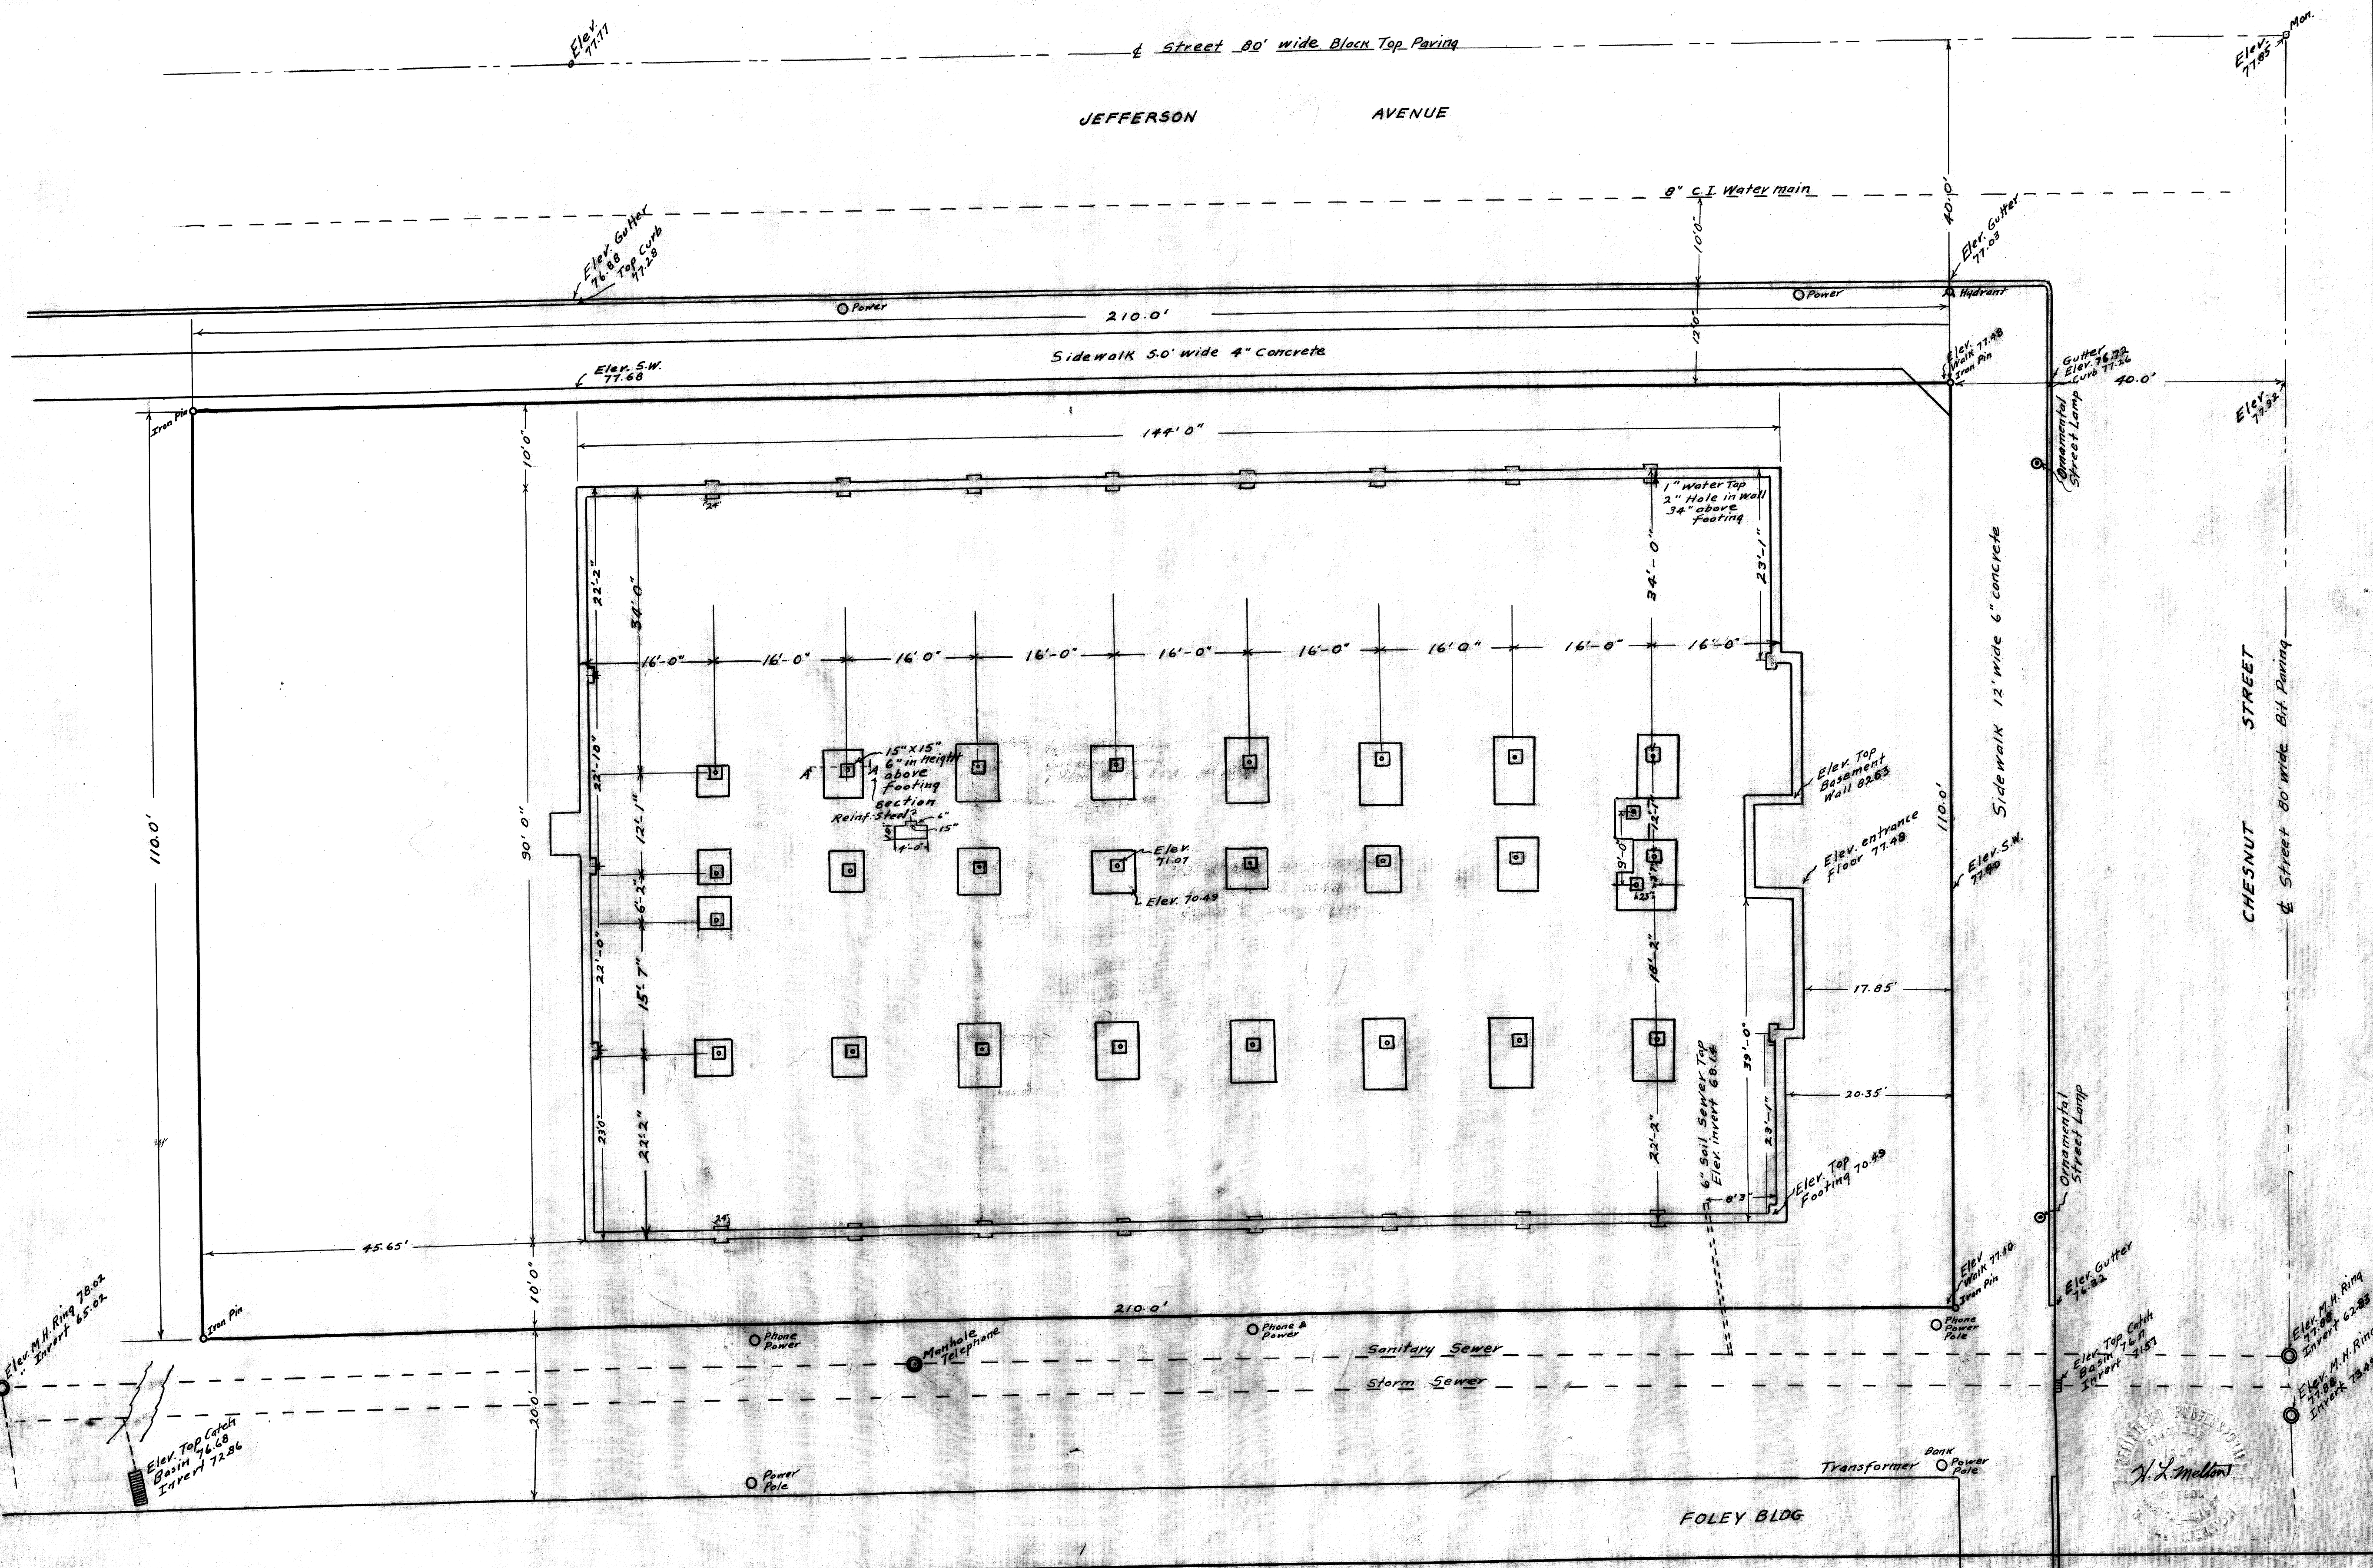

NOTE:
This map was submitted to the Union County Surveyor by a private landowner to include in the Public Records.

UNION COUNTY SURVEYOR	
Date Received	2/9/2015
Date Filed	2/9/2015
By	H.L. Melton
File No.	008-2015