

BASIS OF BEARING

True Geodetic North at the corner common to Sections 5, 6, 7 and 8, Township 4 South, Range 41 East of the Willamette Meridian as determined by GPS observation (NAD-83 (1991) datum) as per Survey Number 030-2014

SCALE: 1" = 600'

LEGEND

- Found 2 1/2" aluminum pipe with 2 1/2" aluminum cap, marked as per Union County Monumentation Record, set by survey noted
- ⊙ Set 5/8" x 30" iron pin with 2 1/2" aluminum cap, marked as per Union County Monumentation Record, filed separately
- () Record measurement as per field notes of GLO Contract No. 320, executed by H.M. Thatcher, dated April 1, 1879

REFERENCE MATERIAL


Union County Monumentation Records
 Survey Number 29-86
 Survey Number 30-86
 Survey Number 29-88
 Survey Number 022-2013
 Survey Number 030-2014A
 Survey Number 034-2015

Field Notes of GLO Contract No. 320, executed by H.M. Thatcher, dated April 1, 1879

DEED REFERENCES
 Microfilm Document Number 20134271
 Microfilm Document Number 20134274

NARRATIVE

This survey was being done at the request of Patrick Marolla on behalf of Hancock Forest Management, land manager of the land within. Mr. Marolla wanted the monuments set along the property lines within Section 7 prior to a timber harvest. I recover the monuments as shown. I find no remaining evidence of the original GLO corner at the North quarter corner position and place this by proportionate measurement. I subdivide the section as per BLM Manual of Instruction 2009. I find no unusual conditions with this survey.

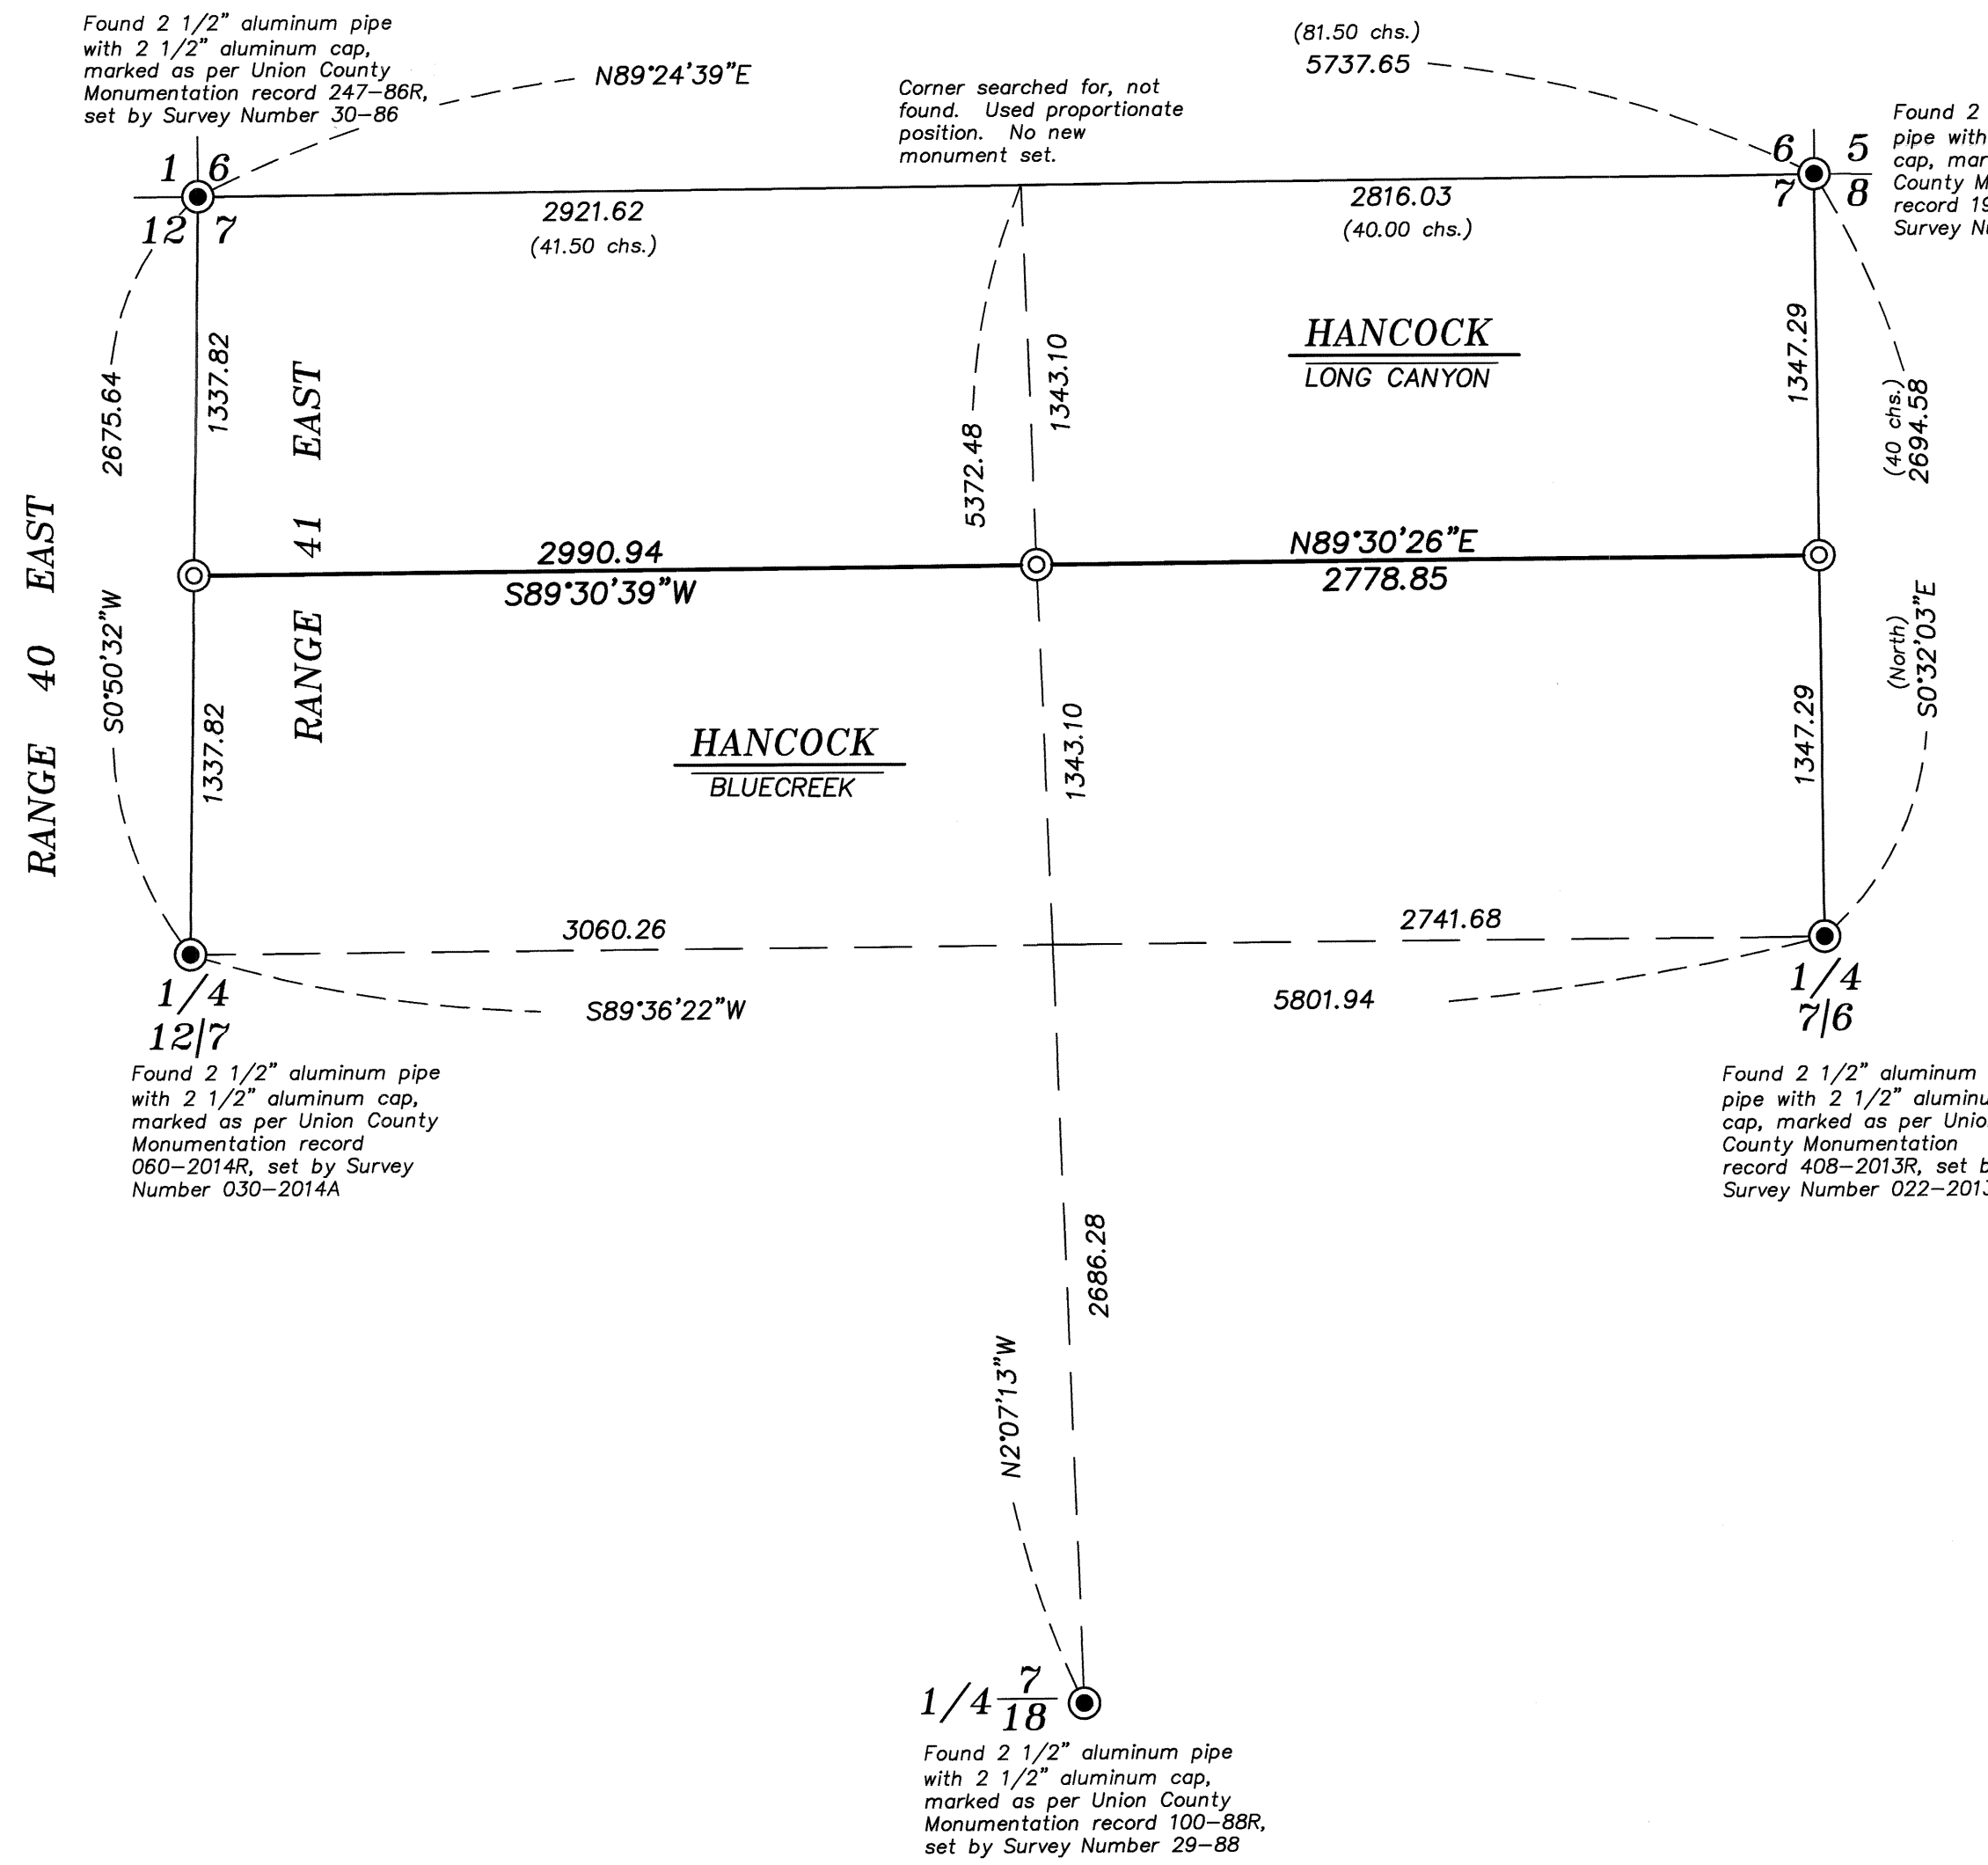

REGISTERED
 PROFESSIONAL
 LAND SURVEYOR

[Signature]

OREGON
 JUNE 2, 2010
 JEFFREY S. HSU
 83571

Renewal Date: June 30, 2017

UNION COUNTY
 SURVEYOR

Date Received 8/28/15

Date Filed 8/28/15

By *[Signature]*

File No. 052-2015

BAGETT, GRIFFITH & BLACKMAN
 2006 Adams Avenue, LaGrande, Oregon
 Map of Survey

Situate in Section 7, Township 4 South,
 Range 41 East of the Willamette Meridian

UNION COUNTY, OREGON

SURVEYED FOR	Hancock Forest Management
SURVEYED BY	J. S. H.
Scale: 1" = 600'	Drawn by: J. S. H. Aug. 2015