# MAP OF SURVEY



(N 87°58'32" W 2546.85' - R3)

(S 89°45' W 39.90 CHS - R2)

FOUND 3-1/4"

ALUMINUM CAP


(R2, R6)



**BASIS FOR BEARINGS** UNION COUNTY SURVEY NO. 28-87 BETWEEN THE EAST 1/4 CORNER AND THE NORTHEAST CORNER OF SECTION 34

#### REFERENCES

- R1 GLO STANDARD PARALLEL SURVEY CONTRACT NO. 102 BY TIMOTHY W. DAVENPORT DATED JULY 20, 1863.
- R2 GLO TOWNSHIP BOUNDARY SURVEY AND SUBDIVISION SURVEY CONTRACT NO. 388 BY W.B. BARR DATED MAY 7, 1881
- R3 SURVEY FOR BOISE CASCADE CORP. UNION COUNTY SURVEY NO. 48-84, BY PLS 1099, FILED NOVEMBER 13, 1984.
- R4 SURVEY FOR BOISE CASCADE CORP. "ACALA GINNING TRACT" UNION COUNTY SURVEY NO. 28-87, BY PLS 645, FILED NOVEMBER 2, 1987.
- R5 SURVEY FOR HANSON NATURAL RESOURCES CO. UNION COUNTY SURVEY NO. 65-91, BY PLS 1206, FILED DECEMBER 20, 1991.
- R6 CERTIFIED RECORD OF LAND CORNER MONUMENTATION 810-84R BY PLS 1099.
- R7 CERTIFIED RECORD OF LAND CORNER MONUMENTATION 1022-84R BY PLS 1099.
- R8 CERTIFIED RECORD OF LAND CORNER MONUMENTATION 1017-84R BY PLS 1099.
- R9 CERTIFIED RECORD OF LAND CORNER MONUMENTATION 707-84R BY PLS 381
- R10 CERTIFIED RECORD OF LAND CORNER MONUMENTATION 148-87R BY PLS 645.
- R11 CERTIFIED RECORD OF LAND CORNER MONUMENTATION 044-1991R BY PLS 1206.
- R12- CERTIFIED RECORD OF LAND CORNER MONUMENTATION 017-1991R BY PLS 1206.

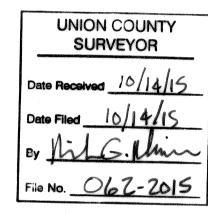

### NARRATIVE


THE PURPOSE OF THIS SURVEY WAS TO DEFINE THE BOUNDARY OF THE NORTH HALF OF THE NORTHEAST QUARTER AND THE EAST HALF OF THE NORTHWEST QUARTER OF SECTION 34, TOWNSHIP 5 SOUTH, RANGE 38 EAST, WILLAMETTE MERIDIAN, UNION COUNTY, OREGON, AS REQUESTED BY CLINT AND GERALDINE DODGE

MONUMENTS WERE FOUND AND HELD, AS SHOWN HEREON. A MONUMENT WAS SET AT THE WEST QUARTER CORNER FROM ORIGINAL EVIDENCE. MONUMENTS WERE SET AT THE CENTER QUARTER, THE CENTER-WEST SIXTEENTH, THE CENTER-NORTH SIXTEENTH, THE WEST SIXTEENTH ON THE NORTH BOUNDARY AND THE NORTH SIXTEENTH ON THE EAST BOUNDARY OF SAID SECTION TO MARK SAID BOUNDARY, AS SHOWN.

NO UNUSUAL CONDITIONS WERE ENCOUNTERED DURING THE COURSE OF THIS SURVEY.

# CERTIFICATION

I, LELAND LEE MYERS, A PROFESSIONAL LAND SURVEYOR REGISTERED IN THE STATE OF OREGON, 587 E AUBURN STREET, PO BOX 99, SUMPTER, OREGON 97877, COMPLETED THIS SURVEY ON AUGUST 1, 2015, AND DO HEREBY CERTIFY THAT I HAVE CORRECTLY SURVEYED AND MARKED WITH PROPER MONUMENTS THE LAND SHOWN HEREON, AND THAT THE INFORMATION SHOWN ON THIS PLAT IS IN ACCORDANCE WITH ORS CHAPTER 92, AND IS CORRECT TO THE BEST OF MY KNOWLEDGE.

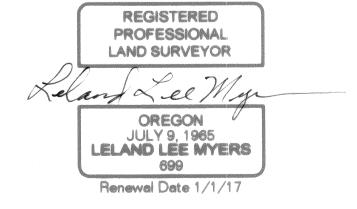

# LEGEND

FOUND MONUMENT AS DESCRIBED FOUND ORIGINAL EVIDENCE AS DESCRIBED SET 30" LONG NO. 5 REBAR WITH YELLOW PLS 699 PLASTIC CAP

SET 30" LONG NO. 5 REBAR WITH YELLOW PLS 699 PLASTIC CAP

RECORD DISTANCE & BEARINGS PER REFERENCES

(S 89°45' W 39.90 CHS - R2) FOUND 2-1/2" BRASS CAP S87°33'50'E 2719.60' N87°36'30"E 2552.87" (A3, A7) 1359.80 1359.80 FOUND 3" BRASS CAP WEST 1/16 CORNER (R4, R8) REFERENCE TREES CREATED: 6" LODGEPOLE PINE - N61°E, 5.47 8" DOUGLAS FIR - \$20°E, 13.50' N1/2NE1/4 NORTH 1/16 CORNER CENTER-NORTH 1/16 CORNER REFERENCE TREES CREATED: REFERENCE TREES CREATED: 18" DOUGLAS FIR - N84°E, 14.40" W1/2NW1/4 E1/2NW1/4 8" PONDEROSA PINE - N29°E. 4.05" 12" PONDEROSA PINE - \$40°W, 7.65' 6" PONDEROSA PINE - S00°E, 12.25" S88°48'23"W 2562.48' S1/2NE1/4 CENTER 1/4 CORNER REFERENCE TREES CREATED: CENTER-WEST 1/16 CORNER 8" PONDEROSA PINE - N54°W, 11.68" REFERENCE TREES CREATED: 10" PONDEROSA PINE - N37°E, 26.05" 13" PONDEROSA PINE - N32°W, 51.70" 7" WESTERN LARCH - S42°E, 26.60" 11" PONDEROSA PINE - S61°W, 13.50" 6" WHITE FIR - \$17W, 15.03" 1352.47 1352.47 2573.21 2704.95 S89°59'40"W 5278.16 1/4 CORNER FOUND 3" BRASS CAP 1/4 CORNER (R4, R9) FOUND ORIGINAL ROCK AND STUMPS (R2) REFERENCE TREES CREATED: 8" PONDEROSA PINE - N18°E, 69.00" 1.1" PONDEROSA PINE - N88°E, 16.10" 6" PONDEROSA PINE - \$27°E, 21.10" 8" PONDEROSA PINE - \$72°W, 22.90' SE1/4 SW1/4 1/4 CORNER FOUND 2-1/2" FOUND 2-1/2" FOUND 2-1/2" (S 89°44'48" E 2654.38' - R5) (N 99°44'43" E 2642.81' - R5) BRASS CAP ALUMINUM CAP BRASS CAP (WEST 40.00 CHS - R1) (WEST 40.00 CHS - R1) (R4, R10) (A5, R12) (A5, A11) N89°53'25"W 2653.96' S89°36'19"W 2642.09" NOTE: ALL REFERENCE TREES HAVE A 60d NAIL & ALUMINUM WASHER STAMPED "PLS 699" IN BASE SIDE CENTER OF TREE 1000 500 1500 GRAPHIC SCALE - FEET

1'' = 500'

1/4 CORNER

(S 88°44'43" W 2724.06' - R3)