


BASIS OF BEARING

Forward bearing as published by the U.S.C. and G.S. from Δ COLLEGE to Δ VALLEY
Dated 1946.

SCALE: 1" = 100'

LEGEND

- Found 2" brass cap in concrete, marked BAGETT, GRIFFITH AND BLACKMAN set by Survey Number 005-2014
- Intersection position determined by found lead plug references
- Found 5/8" iron pin with plastic cap set by Minor Partition Plat No. 1994-04
- Found 5/8" iron pin, set by Survey Number 036-1993
- Found 2" brass cap in concrete marked BAGETT GRIFFITH AND BLACKMAN set by Survey Number 031-2015
- Record information as per Survey Number 18-89 (1922 monumentation)
- Record information as per Survey Number 031-2001
- Record information as per Survey Number 036-1993
- INCORRECT record information as per Survey Number 031-2015 - measurement revised by this survey
- Revised measurement
- Centerline

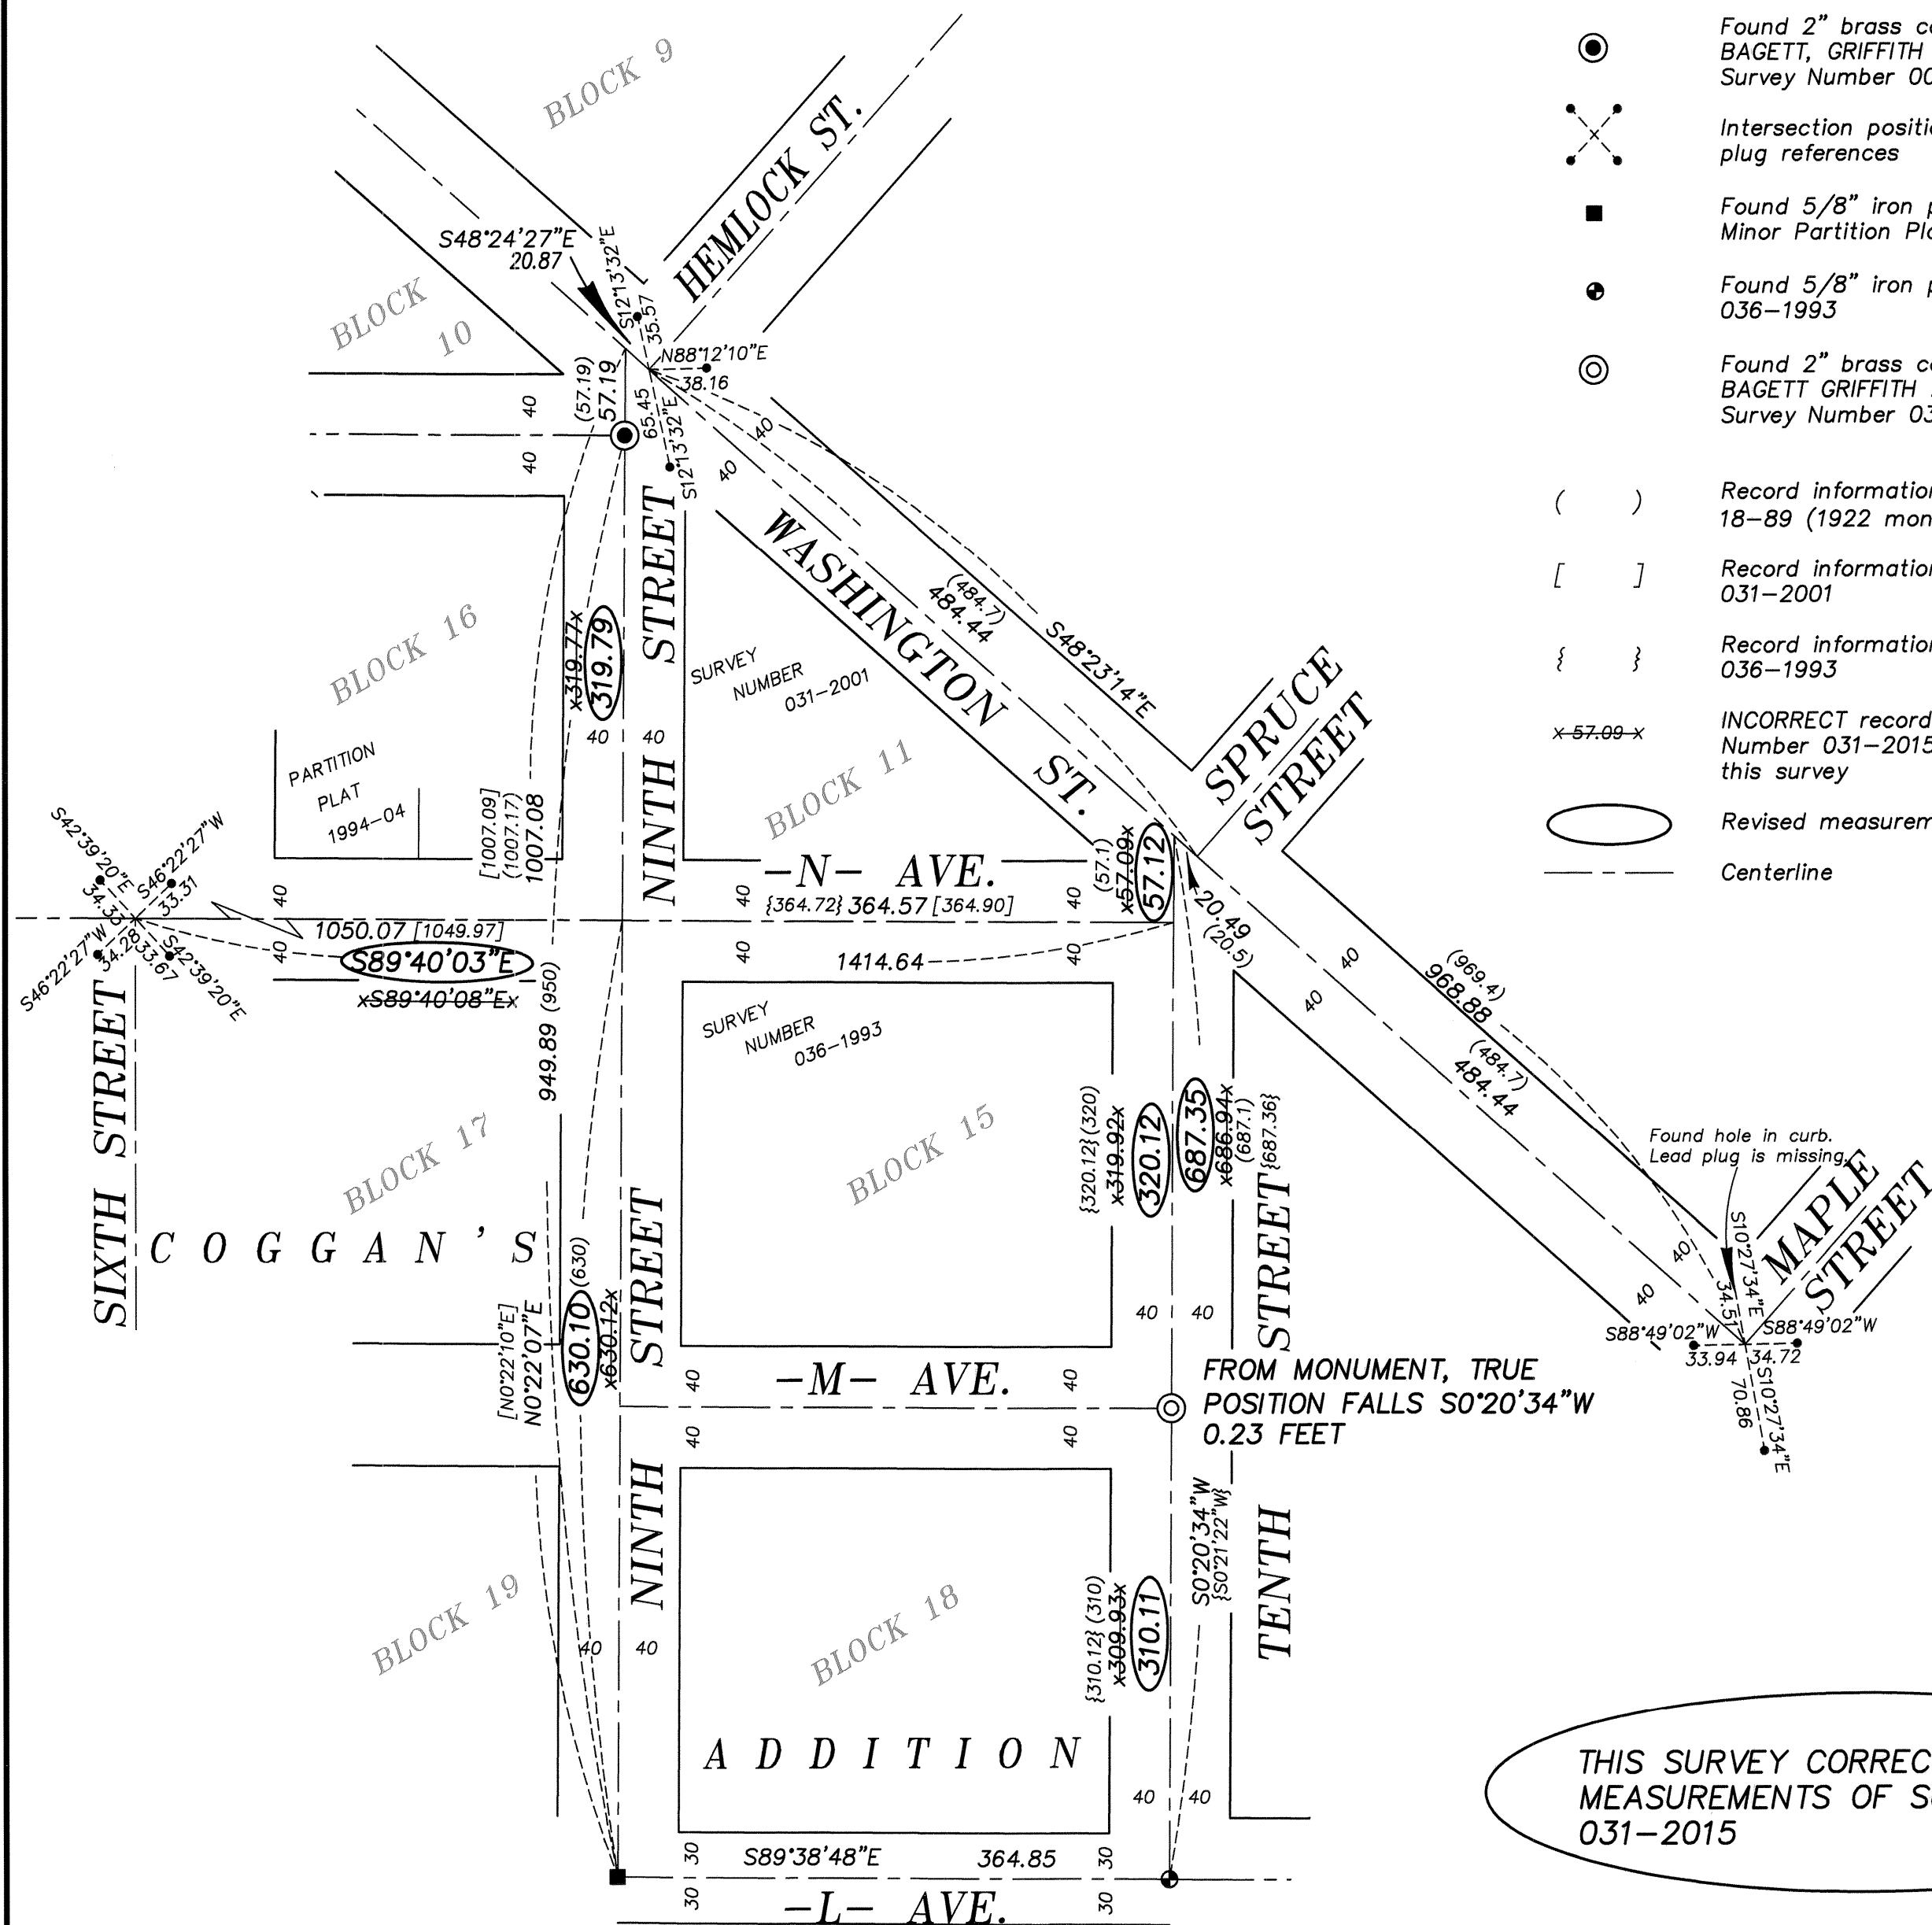

THIS SURVEY CORRECTS ERRONEOUS MEASUREMENTS OF SURVEY NUMBER 031-2015

REFERENCE MATERIAL

Survey Number 63-73
 Survey Number 036-1993
 Survey Number 031-2001
 Survey Number 005-2014
 Survey Number 031-2015
 Survey Number 18-89 (1922 monumentation of La Grande)
 Minor Partiton Plat No. 1994-04

NARRATIVE

This survey was done at the request of myself. During an internal audit, it was discovered that an improper coordinate was used for the intersection of L and 10th Street that did not reflect the position of the actual survey monument. This insight lengthens the overall distance of 10th Street between Washington and L Street by approximately 0.4 feet. This thus affects the proportionate measurements along 10th Street. The monument set at the intersection of 10th and M Avenue is therefore 0.23 feet too far to the North. I do not reset this monument, as it would fall in the concrete portion of the monument, but note it here for future use. It also affects the position of N Avenue and 10th Street, moving it South approximately 0.04 ft. I show the affected measurements from this revision as well.

REGISTERED PROFESSIONAL LAND SURVEYOR
 JEFFREY S. HSU
 83571
 Renewal Date: June 30, 2017

UNION COUNTY SURVEYOR
 Date Received 1/29/17
 Date Filed 1/29/17
 By [Signature]
 File No. 002-2017

BAGETT, GRIFFITH & BLACKMAN 2006 Adams Avenue, LaGrande, Oregon Map of Survey	
REVISION OF SURVEY NUMBER 031-2015 Monumentation of centerline intersection of 10th Street and M Avenue	
UNION COUNTY, OREGON	
SURVEYED FOR	Jeff Hsu
SURVEYED BY	J. S. H.
Scale: 1" = 100'	Drawn by: J. S. H. January 2017