LEGEND

REFERENCE LIST

NETWORK POINT

RIGHT-OF-WAY

PROPERTY LINE

EDGE OF PAVEMENT

FOUND MONUMENT


(XX) X RECORD DATA PER

SURVEY NARRATIVE

THE PURPOSE OF THIS SURVEY IS TO RESOLVE A PORTION OF THE UKIAH - HILGARD HIGHWAY AS PART OF THE OR244: WHISKEY CREEK CULVERT PROJECT.


THE NORTHEAST CORNER OF SECTION 12 WAS LOCATED IN THE FIELD. THE RECORD DISTANCES FROM BOOK 122, PAGE 464 CALL FOR ENGINEER'S CENTER LINE STATION 140+75 TO BE 1160 FEET SOUTH AND 1285 FEET WEST OF SAID CORNER. THESE DISTANCES WERE APPLIED AND ROTATED TO INTERSECT THE CENTER OF THE HIGHWAY. THOSE CALLS APPEAR TO BE APPROXIMATE DISTANCES AND DO NOT MATCH WITH THE STATIONING RUN BACK ON LINE FROM OREGON DEPARTMENT OF TRANSPORTATION (ODOT) DRAWING 11B-9-35, SO THEY WERE NOT HELD.

THE EXISTING RIGHT OF WAY (RW) ALIGNMENT WAS DEVELOPED AS FOLLOWS: THE CENTER LINE ALIGNMENT FROM ODOT DRAWING 11B-9-35 WAS EXTENDED EASTERLY HOLDING THE RECORD DELTA ANGLES FROM ODOT DRAWING 5B-36-6 OF 40°02'10" AND 55°39'20" AND PASSED THROUGH A SPLIT OF THE PAVEMENT AT STATION 153+92.46. THIS CENTER LINE ALIGNMENT TANGENT WAS THEN EXTENDED EASTERLY ON LINE AND INTERSECTED A TANGENT BEARING PRODUCED FORWARD FROM STATION 124+94.73 USING THE RECORD DELTA ANGLE OF 63°25'30" FROM SAID DRAWING. OF: D = $3^{\circ}00'$; 300 FOOT SPIRAL LENGTHS; AND S = $4^{\circ}30'$ FROM SAID DRAWING WERE USED TO GENERATE THE CURVE. THE RECORD STATION OF 125+14.18 P.S. FROM DRAWING 5B-36-6 WAS ESTABLISHED USING THE RECORD SEMI-TANGENT DISTANCE OF 1331.31' FROM THE SAID P.I.

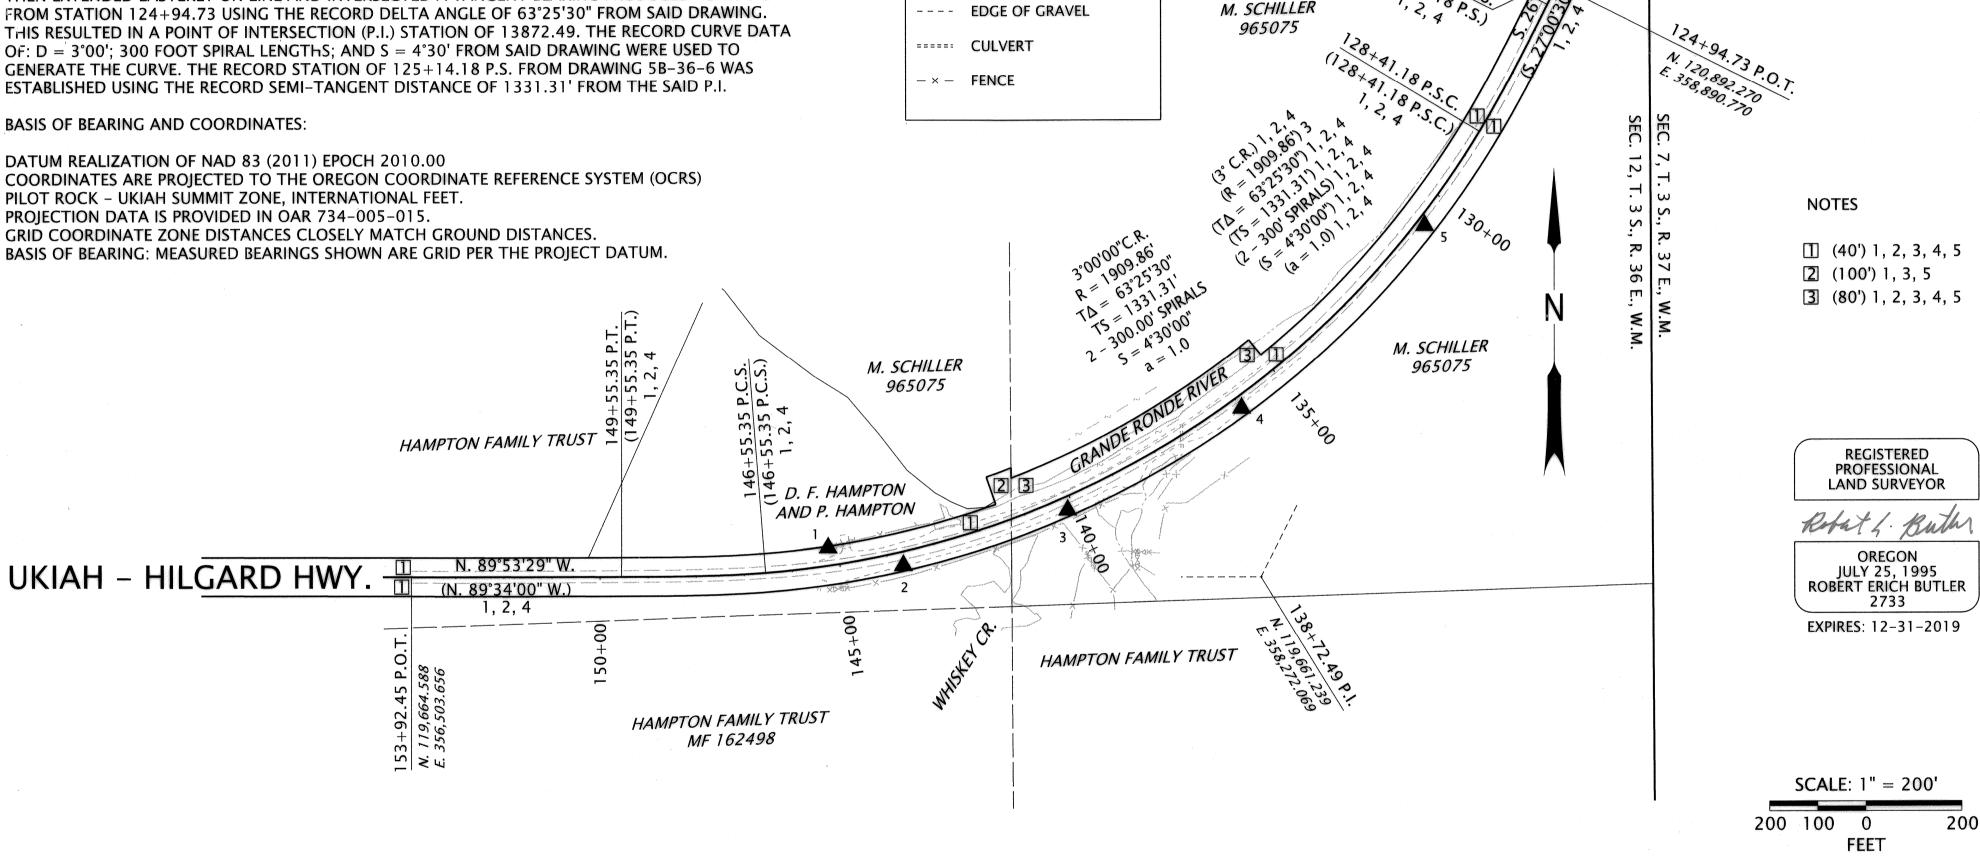

REFERENCES:

- OREGON DEPARTMENT OF TRANSPORTATION DRAWING 5B-36-6; APRIL, 1950
- 2. OREGON DEPARTMENT OF TRANSPORTATION CONSTRUCTION PLANS 4V-144, JUNE, 1950
- 3. UNION COUNTY RECORD OF DEEDS: BOOK 122, PAGE 464: AUGUST 10, 1950
- 4. OREGON DEPARTMENT OF TRANSPORTATION DRAWING 7B-3-11; SEPTEMBER, 1950
- 5. UNION COUNTY RECORD OF DEEDS: BOOK 124, PAGE 12; JANUARY 11, 1951
- 6. UNION COUNTY SURVEY 028–1992; NOVEMBER 27, 1992
- 7. UNION COUNTY SURVEY 027–1996; JULY 10, 1996 8. UNION COUNTY SURVEY 036–2006; NOVEMBER 3, 2006
- OREGON DEPARTMENT OF TRANSPORTATION DRAWING 11B-9-35; MAY, 2018

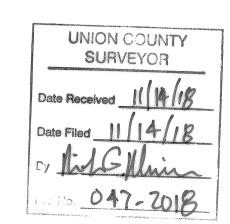

OREGON DEPARTMENT OF TRANSPORTATION

HORIZONTAL CONTROL, RECOVERY AND RETRACEMENT MAP OR244: WHISKEY CREEK CULVERT REPLACEMENT UKIAH - HILGARD HIGHWAY



UNION COUNTY

FOR ODOT REGION 5 3012 ISLAND AVENUE LA GRANDE, OREGON 97850 KEY NO. 20456

T3S R36E R37E

S1 S6

S12 S7

OPLS 644

FD. 2½" ALUM. CAP ON 2½" ALUMINUM PIPE

12 7

MARKED AS SHOWN

(08/29/2018)

N. 121,002.340

E. 359,081.070

(CS 036-2006)

M. SCHILLER

965075

SEC. 12

NOVEMBER 6, 2018 SCALE: 1'' = 200'SHEET 1 OF 1

SURVEY NUMBER 047-2018

NETWORK POINT COORDINATE TABLE

DATE DESCRIPTION **EASTING** NO. NORTHING SET %" IRON ROD W/RPC MKD. "ODOT CONTROL" 119,722.99 357,370.74 08/29/2018 SET %" IRON ROD W/RPC MKD. "ODOT CONTROL" 357,527.41 08/29/2018 2 119,686.47 SET %" IRON ROD W/RPC MKD. "ODOT CONTROL" 119,801.07 357,870.13 08/29/2018 3 SET %" IRON ROD W/RPC MKD. "ODOT CONTROL" 120,012.18 358,232.26 08/29/2018 4 08/29/2018 SET %" IRON ROD W/RPC MKD. "ODOT CONTROL" 358,613.51 5 | 120,390.65

W/RPC = WITH RED PLASTIC CAP

MKD. = MARKED