SHEET INDEX

SHEET INDEX & NARRATIVE

NARRATIVE CONTINUED, REFERENCES 2.

STREET CENTER LINE DIAGRAM 3. CONTROL NETWORK SCHEMATIC &

SHEET LAYOUT DIAGRAM

5.-15. SURVEY

NARRATIVE

REGISTERED **PROFESSIONAL** LAND SURVEYOR

BAER

OREGON JANUARY 14, 2003 BRET N. ELITHORP 63148

RENEWS: 12-31-2025

THE PURPOSE OF THIS SURVEY IS TO RESOLVE THE EXISTING CENTER LINE AND RIGHT OF WAY FOR A PORTION OF LA GRANDE - BAKER HIGHWAY (ADAMS AVENUE) FROM ALDER STREET SOUTHEASTERLY TO "H" AVENUE. THIS SURVEY PERPETUATES THOSE SURVEY MONUMENTS WITHIN THE PROJECT LIMITS IN JEOPARDY OF BEING DESTROYED BY A FUTURE SIDEWALK/CURB RAMP REPLACEMENT PROJECT. THIS SURVEY MEETS THE REQUIREMENT FOR A RECOVERY SURVEY AS OUTLINED IN THE OREGON REVISED STATUTES SECTION 209.155.

IT IS NOT THE INTENT OF THIS SURVEY TO RECOVER EVERY MONUMENT ALONG THE LA GRANDE - BAKER HIGHWAY FROM ALDER STREET TO "H" AVENUE, JUST THOSE MONUMENTS NEEDED TO RESOLVE THE RIGHT OF WAY AND THOSE MONUMENTS IN JEOPARDY OF BEING DESTROYED BY THE PROJECT.

THIS SURVEY WAS PERFORMED IN INTERNATIONAL FEET UNITS.

THIS SURVEY WAS PERFORMED BETWEEN THE MONTHS OF JUNE 2023 AND FEBRUARY 2024. THE SURVEY EQUIPMENT CONSISTED OF LEICA GS14 RECEIVERS. LEICA TS-16 TOTAL STATIONS, A LEICA DIGITAL LEVEL, AND CS 20 DATA COLLECTORS.

CONTROL NARRATIVE

PRIMARY CONTROL WAS ESTABLISHED ON THIS PROJECT USING THE OREGON REALTIME GNSS NETWORK (ORGN) TO ESTABLISH POSITIONS ON CONTROL POINTS 50 THROUGH 112, 100A AND 101A, AND 200 THROUGH 213 BY INCORPORATING THE AVERAGE OF TWO SEPARATE GNSS OBSERVATIONS OF AT LEAST 180 EPOCHS OBSERVED UNDER DIFFERENT SATELLITE GEOMETRY. THE HORIZONTAL DATUM FOR THIS PROJECT IS THE OREGON COORDINATE REFERENCE SYSTEM (OCRS) LA GRANDE ZONE, NAD83 (2011) EPOCH 2010. THE BASIS OF BEARINGS ARE GRID BEARINGS PER THE PROJECT DATAM.

VERTICAL CONTROL WAS ESTABLISHED ON THIS PROJECT BY HOLDING GNSS DERIVED NAVD 88 ELEVATION OF 2756.70 FEET ON A BENCHMARK ESTABLISHED IN 2015 BY ODOT ON THE STATE OF OREGON DEPARTMENT OF TRANSPORATION CAMPUS USING THE ONLINE USER POSITIONING SERVICE (OPUS), AND RUNNING A CLOSED LEVEL CIRCUIT THROUGH THE CONTROL POINTS SHOWN ON THIS SURVEY WITH A LEICA DIGITAL LEVEL.

LA GRANDE - BAKER HWY. (US30) (ADAMS AVENUE) "RW" LINE

THE RIGHT OF WAY FOR ADAMS AVENUE WAS ESTABLISHED AT A WIDTH OF 80.00 FEET. 40.00 FEET ON EACH SIDE OF CENTER LINE BY THE FOLLOWING PLATS:

- ADAMS AVENUE BETWEEN ALDER STREET AND FIRST STREET WAS ESTABLISHED PER THE SUPPLEMENTAL PLAT OF GRANDY'S 2ND ADDITION
- ADAMS AVENUE BETWEEN FIRST STREET AND FOURTH STREET WAS ESTABLISHED PER THE PLAT OF GRANDY'S ADDITION.
- ADAMS AVENUE BETWEEN FOURTH STREET AND GREENWOOD WAS ESTABLISHED PER THE SUPPLEMENTAL PLAT OF CHAPLINS ADDITION.
- 4. ADAMS AVENUE BETWEEN GREENWOOD STREET AND MAPLE STREET WAS ESTABLISHED PER COGGANS ADDITION.
- ADAMS AVENUE BETWEEN MAPLE STREET AND WILLOW STREET WAS ESTABLISHED PER COGGANS SECOND ADDITION.
- ADAMS AVENUE BETWEEN WILLOW STREET AND "H" AVENUE (FORMERLY "K STREET) WAS ESTABLISHED PER HONANS ADDITION, THE PORTION NORTHEASTERLY OF ADAMS AVENUE BETWEEN WILLOW STREET AND "H" STREET WAS REPLATTED AS CARR'S SUBDIVISION OF BLOCKS 13 & 14 HONANS ADDITION.

COUNTY SURVEY 044-2017 WAS HELD TO ESTABLISH THE CENTER LINE FOR LA GRANDE BAKER HIGHWAY WESTERLY OF ALDER STREET. CENTER LINE MONUMENTS WERE ORIGINALLY SET BY BAGETT GRIFFITH AND ASSOCIATES FOR THE CITY OF LA GRANDE AT EACH STREET INTERSECTING ADAMS AVENUE BETWEEN ALDER STREET AND EIGHTEENTH STREET (FORMERLY HIGHWAY AVENUE) SHOWN ON COUNTY SURVEY 013-1988 THAT WERE FOUND AND ACCEPTED TO ESTABLISH THE CENTER LINE FOR ADAMS AVENUE. THE PORTION OF ADAMS AVENUE FROM EIGHTEENTH STREET TO EAST "H" AVENUE WAS ESTABLISHED BY RECREATING RECORD SHAPE OF THE CENTER LINE ALIGNMENT SHOWN ON OREGON STATE HIGHWAY DEPARTMENT DRAWING 6B-35-9 AND POSITIONED IN THE EAST-WEST DIRECTION PARALLEL AND 92.5 FEET FROM THE CENTER LINE OF THE UNION PACIFIC RAILROAD. WHICH WAS ESTABLISHED BY MAPPING THE TOP OF EACH RAIL AT ALL OF THE ROAD CROSSINGS BETWEEN FIR STREET AND MCALISTER ROAD, SAID RECORD SHAPE WAS POSITIONED IN THE NORTH-SOUTH DIRECTION BY HOLDING RECORD DISTANCE OF 40.00 FEET FROM THE MONUMENT AT POINT 1878 SET ON COUNTY SURVEY 005-1984. THE TANGENT BETWEEN "RW" 0+00.000 P.O.T. AND "RW" 8+26.90 P.I. WAS ADJUSTED TO HOLD THE CENTER LINE MONUMENTS AT POINTS 1523 AND 1528. BECAUSE SAID TANGENT WAS ADJUSTED, A STATION EQUATION WAS ADDED AT STATION "RW"9+89.41 P.T. BK. = "RW"9+90.38 P.O.T. AH TO GET BACK ON RECORD STATIONING AT "RW"12+39.80 P.C. STATIONING ALONG ADAMS AVENUE FROM ALDER STREET TO WILLOW STREET WAS ESTABLISHED BY EXTENDING RECORD STATIONING HELD FROM SURVEY 044-2017.

SE 1/4 SECTION 6 T3S R38E WM SW 1/4 SECTION 5, T3S R38E WM NW 1/4 SECTION 8 T3S R38E WM NE 1/4 SECTION 8 T3S R38E WM NW 1/4 SECTION 9 T3S R38E WM SE 1/4 SECTION 8 T3S R38E WM

SW 1/4 SECTION 9 T3S R38E WM

ALDER STREET

THE CENTER LINE FOR ALDER STREET WAS ESTABLISHED BY HOLDING THE MONUMENT AT POINT 1836 AND HOLDING MONUMENTS FOUND ON ADAMS AVENUE AT POINTS 1519 & 1520. THEN EXTENDING A LINE BETWEEN SAID MONUMENTS WESTERLY RECORD DISTANCE OF 299.53 FEET PER COUNTY SURVEY 031-2017. THE RIGHT OF WAY WIDTH FOR ALDER STREET SOUTH OF ADAMS WAS ESTABLISHED AT A WIDTH OF 80.00 FEET BY PLAT OF GRANDY'S SECOND ADDITION.

WALNUT STREET

THE CENTER LINE FOR WALNUT STREET NORTHERLY OF ADAMS WAS ESTABLISHED PER COUNTY SURVEY 007-2023 BY RECREATING RECORD SHAPE AND ROTATING TO HOLD THE BEARING OF THE CENTER LINE OF ADAMS AVENUE. RECORD WIDTH OF 80.00 FEET WAS HELD PER THE PLAT OF GRANDY'S SECOND ADDITION. THE PORTION OF WALNUT STREET SOUTHERLY OF ADAMS AVENUE WAS ESTABLISHED BY HOLDING THE CENTER LINE MONUMENTS AT POINTS 1519 AND 1841.

OAK STREET

THE CENTER LINE FOR OAK STREET NORTHERLY OF ADAMS AVENUE WAS ESTABLISHED BY HOLDING THE CENTER LINE MONUMENTS FOUND AT THE INTERSECTION OF OAK STREET WITH ADAMS AVENUE (POINT 1520) AND WITH PALMER AVENUE (POINT 1558). THE PORTION OF OAK STREET SOUTHERLY OF ADAMS AVENUE WAS ESTABLISHED BY HOLDING PRORATED DISTANCE BETWEEN THE MONUMENT FOUND AT THE INTERSECTION OF WASHINGTON AVENUE WITH ALDER STREET (POINT 1836) AND THE CALCULATED INTERSECTION OF WASHINGTON AVENUE WITH FIRST STREET BY USING REFERENCE MONUMENTS. TOGETHER WITH THE CENTER LINE MONUMENT FOUND AT THE INTERSECTION OF OAK STREET WITH ADAMS AVENUE (POINT 1520). RECORD WIDTH FOR OAK STREET OF 80.00 FEET WAS HELD PER GRANDY'S SECOND ADDITION.

CEDAR STREET

THE CENTER LINE FOR CEDAR STREET NORTHERLY OF ADAMS AVENUE WAS ESTABLISHED BY HOLDING THE CENTER LINE MONUMENTS FOUND AT THE INTERSECTION OF CEDAR STREET WITH ADAMS AVENUE (POINT 1513) AND WITH PALMER AVENUE (POINT 1559). THE PORTION OF ADAMS AVENUE SOUTHERLY OF ADAMS AVENUE WAS ESTABLISHED BY HOLDING PRORATED DISTANCE BETWEEN THE MONUMENT FOUND AT THE INTERSECTION OF WASHINGTON AVENUE WITH ALDER STREET (POINT 1836) AND THE CALCULATED INTERSECTION OF WASHINGTON AVENUE WITH FIRST STREET BY USING REFERENCE MONUMENTS, TOGETHER WITH THE CENTER LINE MONUMENT FOUND AT THE INTERSECTION OF CEDAR STREET WITH ADAMS AVENUE (POINT 1513). RECORD WIDTH FOR CEDAR STREET OF 80.00 FEET WAS HELD PER GRANDY'S SECOND ADDITION.

FIRST STREET

MONUMENTS FOUND AT POINTS 1559 AND 1513 ON CEDAR STREET WERE HELD TO PRORATE THE CENTER LINE INTERSECTIONS WITH JEFFERSON AVENUE AND GRANDY AVENUE. SAID PRORATED INTERSECTION OF GRANDY AVENUE WITH CEDAR STREET WAS HELD ALONG WITH THE CALCULATED CENTER LINE INTERSECTION OF GRANDY AVENUE WITH SECOND STREET TO PRORATE IN THE CENTER LINE INTERSECTION OF FIRST STREET WITH GRANDY AVENUE. THE POSITION OF THE CONCRETE NAIL REFERENCED BY COUNTY SURVEYS 046-1993, 020-2017 AND 014-2021 AT THE CENTER LINE INTERSECTION OF SECOND STREET WITH GRANDY AVENUE WAS RE-ESTABLISHED BY USING COUNTY SURVEY 014-2021. RECREATING THE RECORD SHAPE, HOLDING THE CENTER LINE MONUMENT AT THE INTERSECTION OF ADAMS AVENUE AND SECOND STREET, THEN ROTATING RECORD SHAPE TO THE CENTER LINE MONUMENT AT THE INTERSECTION OF CEDAR STREET WITH ADAMS AVENUE. THE RESULTING POSITION FOR THE CENTER LINE INTERSECTION OF FIRST STREET WITH GRANDY AVENUE WAS HELD ALONG WITH THE CENTER LINE MONUMENT AT THE INTERSECTION OF ADAMS AVENUE WITH FIRST STREET TO ESTABLISH THE CENTER LINE OF FIRST STREET NORTHERLY OF ADAMS AVENUE. THE CENTER LINE OF FIRST STREET SOUTHERLY OF ADAMS AVENUE WAS ESTABLISHED BY HOLDING SAID CENTER LINE MONUMENT AT FIRST STREET WITH ADAMS AVENUE AND THE CENTER LINE INTERSECTION OF FIRST STREET WITH WASHINGTON AVENUE, WHICH WAS CALCULATED BY HOLDING REFERENCE MONUMENTS. RECORD WIDTH FOR FIRST STREET OF 80.00 FEET WAS HELD PER GRANDY'S SECOND ADDITION AND GRANDY'S ADDITION.

SECOND STREET

THE CALCULATED POSITION FOR THE CONCRETE NAIL SHOWN ON COUNTY SURVEY 046-1993 AT THE INTERSECTION OF GRANDY AVENUE WITH SECOND STREET AS DESCRIBED IN THE NARRATIVE FOR FIRST STREET WAS HELD ALONG WITH THE CENTER LINE MONUMENT AT THE INTERSECTION OF ADAMS AVENUE WITH SECOND STREET (POINT 1505). THE PORTION OF SECOND STREET SOUTHERLY OF ADAMS AVENUE WAS ESTABLISHED BY HOLDING SAID CENTER LINE MONUMENT AT POINT 1505 AND THE CENTER LINE MONUMENT AT THE INTERSECTION OF SECOND STREET WITH WASHINGTON STREET (POINT 1514). THE RECORD WIDTH OF 80.00 FEET WAS HELD AS SHOWN ON GRANDYS ADDITION.

THIRD STREET

THE CENTER LINE MONUMENTS AT THE INTERSECTION OF THIRD STREET WITH GRANDY AVENUE (POINT 1867) AND WITH ADAMS AVENUE (POINT 1504) WERE HELD TO ESTABLISH THE CENTER LINE OF THIRD STREET. THE PORTION OF THIRD STREET SOUTHERLY OF ADAMS AVENUE WAS ESTABLISHED BY HOLDING THE CENTER LINE MONUMENT AT THE INTERSECTION OF THIRD STREET WITH ADAMS (POINT 1504) AND THE CALCULATED POSITION OF THE CENTER LINE INTERSECTION OF THIRD STREET WITH WASHINGTON STREET BY HOLDING REFERENCE MONUMENTS. RECORD RIGHT OF WAY WIDTH OF 80.00 WAS HELD PER GRANDY'S ADDITION.

FOURTH STREET

THE CENTER LINE MONUMENT AT POINT 1842 AND THE CENTER LINE MONUMENT AT THE INTERSECTION OF FOURTH STREET WITH ADAMS AVENUE (POINT 1503) WERE HELD TO ESTABLISH THE CENTER LINE FOR FOURTH STREET NORTHERLY OF ADAMS AVENUE. SAID POINT 1503 AND THE CENTER LINE MONUMENT AT THE INTERSECTION OF FOURTH STREET WITH WASHINGTON AVENUE (POINT 1552) WERE HELD TO ESTABLISH THE CENTER LINE FOR FOURTH STREET SOUTHERLY OF ADAMS AVENUE. RECORD RIGHT OF WAY WIDTH OF 80.00 FEET WAS ESTABLISHED PER GRANDY'S ADDITION AND CHAPLIN'S ADDITION.

CHESTNUT STREET

THE CENTER LINE FOR CHESTNUT STREET WAS ESTABLISHED BY HOLDING PRORATED DISTANCE BETWEEN THE MONUMENT FOUND AT THE INTERSECTION OF JEFFERSON AVENUE WITH DEPOT STREET AND RECORD DISTANCE OF 146.18 FEET SOUTHERLY ALONG THE CENTER LINE OF FOURTH STREET FROM THE MONUMENT AT POINT 1842, TOGETHER WITH THE CENTER LINE MONUMENT AT THE INTERSECTION OF CHESTNUT WITH ADAMS AVENUE (POINT 1526). SAID RESOLUTION MATCHES WITH THE DISTANCES SHOWN ON COUNTY SURVEY 063-1973. RECORD RIGHT OF WAY WIDTH OF 80.00 FEET WAS HELD PER CHAPLIN'S ADDITION.

DEPOT STREET

DEPOT STREET NORTHERLY OF ADAMS WAS ESTABLISHED BY HOLDING CENTER LINE MONUMENTS AT THE INTERSECTION OF DEPOT STREET WITH JEFFERSON AVENUE AND ADAMS AVENUE. THE PORTION OF DEPOT STREET SOUTHERLY OF ADAMS AVENUE WAS ESTABLISHED BY RECREATING THE RECORD SHAPE OF DEPOT STREET SHOWN ON COUNTY SURVEY 008-2004, AND ROTATING SAID RECORD SHAPE BY HOLDING THE CENTER LINE MONUMENTS ON ADAMS AVENUE AT POINTS 1512 AND 1511 TO ESTABLISH THE CENTER LINE INTERSECTION OF DEPOT STREET WITH WASHINGTON AVENUE. RECORD RIGHT OF WAY WIDTH OF 80.00 FEET WAS HELD PER CHAPLINS ADDITION.

ELM STREET, FIR STREET & GREENWOOD STREET

THE CENTER LINES FOR ELM STREET, FIR STREET AND GREENWOOD STREET WERE ALL ESTABLISHED BY HOLDING CENTER LINE MONUMENTS FOUND AT THE INTERSECTIONS OF SAID STREETS WITH WASHINGTON AVENUE, ADAMS AVENUE, AND JEFFERSON AVENUE. RECORD RIGHT OF WAY WIDTH OF 80.00 FEET WAS HELD PER CHAPLIN'S ADDITION.

HEMLOCK STREET

THE CENTER LINE INTERSECTION OF WASHINGTON AVENUE WITH HEMLOCK STREET WAS RE-ESTABLISHED BY REFERENCES. SAID INTERSECTION WAS HELD TOGETHER WITH THE CENTER LINE MONUMENT AT THE INTERSECTION OF HEMLOCK WITH ADAMS (POINT 1507). AND THE CENTER LINE MONUMENT AT POINT 1524 TO ESTABLISH THE CENTER LINE OF HEMLOCK STREET. RECORD RIGHT OF WIDTH OF 80.00 FEET WAS HELD PER COGGAN'S ADDITION.

SPRUCE STREET

THE CENTER LINE INTERSECTION OF WASHINGTON AVENUE WITH SPRUCE STREET WAS RE-ESTABLISHED BY REFERENCE MONUMENTS. SAID INTERSECTION WAS HELD TOGETHER WITH THE CENTER LINE MONUMENT AT THE INTERSECTION OF SPRUCE STREET WITH ADAMS AVENUE (POINT 1522) TO ESTABLISH SPRUCE STREET SOUTHWESTERLY OF ADAMS AVENUE. THE PORTION OF SPRUCE STREET NORTHEASTERLY OF ADAMS AVENUE WAS ESTABLISHED BY RECREATING RECORD SHAPE OF COUNTY SURVEY 008-1998 AND POSITIONED BY HOLDING THE CENTER LINE MONUMENT AT THE INTERSECTION OF ADAMS AVENUE WITH SPRUCE STREET (POINT 1522) AND ROTATING TO HOLD THE MONUMENT AT THE INTERSECTION OF ADAMS AVENUE WITH MAPLE STREET (POINT 1515). RECORD RIGHT OF WAY WIDTH WAS HELD PER COGGANS ADDITION. ADDITIONAL RIGHT OF WAY WAS ACQUIRED PER OREGON STATE HIGHWAY DRAWING 9B-8-4.

UNION COUNTY SURVEYOR

Date Received: 31/2/24 Date Filed: 3/15/24

OREGON DEPARTMENT OF TRANSPORTATION

HORIZONTAL CONTROL, RECOVERY AND RETRACEMENT MAP US30 (ADAMS AVE): ALDER ST. TO "H" AVE., LA GRANDE LA GRANDE – BAKER HIGHWAY (US30) UNION COUNTY, OREGON

ODOT REGION 5 TECH CENTER **3012 ISLAND AVENUE** LA GRANDE, OR 97850

KEY NO. 22754/N00042 MARCH 11, 2024 NO SCALE SHEET 1 OF 15

013-2024

SE 1/4 SECTION 6 T3S R38E WM SW 1/4 SECTION 5, T3S R38E WM NW 1/4 SECTION 8 T3S R38E WM NE 1/4 SECTION 8 T3S R38E WM NW 1/4 SECTION 9 T3S R38E WM SE 1/4 SECTION 8 T3S R38E WM SW 1/4 SECTION 9 T3S R38E WM

MAPLE STREET

THE PORTION OF MAPLE STREET NORTHEASTERLY OF ADAMS AVENUE WAS ESTABLISHED BY RECREATING RECORD SHAPE OF COUNTY SURVEY 008-1998 AND POSITIONED BY HOLDING THE CENTER LINE MONUMENT AT THE INTERSECTION OF ADAMS AVENUE WITH SPRUCE STREET (POINT 1522) AND ROTATING TO HOLD THE MONUMENT AT THE INTERSECTION OF ADAMS AVENUE WITH MAPLE STREET (POINT 1515). RECORD RIGHT OF WAY WIDTH OF 57.00 FEET, 40.00 NORTHERLY OF CENTER LINE AND 17.00 SOUTHERLY OF CENTER LINE WAS HELD FOR THIS PORTION OF MAPLE STREET PER COUNTY SURVEY 008-1998. THIS RIGHT OF WAY APPEARS TO HAVE BEEN CREATED BY DEED OMISSION. THE PORTION OF MAPLE STREET SOUTHWESTERLY OF ADAMS AVENUE WAS ESTABLISHED BY HOLDING REFERENCE MONUMENTS TO CALCULATE THE CENTER LINE INTERSECTION OF MAPLE STREET WITH WASHINGTON AVENUE, WHICH WAS HELD ALONG WITH THE MONUMENT FOUND AT THE INTERSECTION OF MAPLE STREET WITH ADAMS AVENUE (POINT 1515). RECORD RIGHT OF WAY WIDTH OF 80.00 FEET WAS HELD FOR THIS PORTION OF MAPLE STREET PER COGGANS ADDITION.

CHERRY STREET

THE PORTION OF CHERRY STREET NORTHEASTERLY OF ADAMS AVENUE WAS ESTABLISHED BY HOLDING RECORD ANGLE OF 90°01'41" FROM THE CENTER LINE OF ADAMS AVENUE PER COUNTY SURVEY 020-2021. THE SOUTHWESTERLY PORTION OF CHERRY STREET WAS ESTABLISHED BY CALCULATING THE INTERSECTION OF CHERRY STREET WITH WASHINGTON AVENUE USING REFERENCE MONUMENTS, AND HOLDING THE MONUMENT FOUND IN THE INTERSECTION OF CHERRY STREET WITH ADAMS AVENUE (POINT 1516). RECORD RIGHT OF WAY WIDTH OF 60.00 FEET FOR CHERRY STREET WAS HELD PER COGGAN'S SECOND ADDITION.

BOX ELDER STREET

BOX ELDER STREET WAS ORIGINALLY ESTABLISHED PER YOUNG'S SUBDIVISION OF R.S.&T., COGGAN'S SECOND ADDITION AT A WIDTH OF 43.00 FEET. THE CENTER LINE OF SAID STREET WAS LOCATED BY HOLDING THE MONUMENT IN THE INTERSECTION OF BOX ELDER STREET WITH ADAMS AVENUE (POINT 1517), TOGETHER WITH RECORD ANGLE OF 90°00'00" FROM THE CENTER LINE OF ADAMS AVENUE PER COUNTY SURVEYS 041-1982, 026-2001, 039-2001, AND 040-2006. ADDITIONAL RIGHT OF WAY WAS ACQUIRED ON THE SOUTHEASTERLY SIDE OF THE CENTER LINE SHOWN ON COUNTY SURVEY 039-2001.

BALM STREET

BALM STREET WAS CREATED BY COGGAN'S SECOND ADDITION AT A WIDTH OF 60.00 FEET. THE CENTER LINE FOR BALM STREET WAS ESTABLISHED BY HOLDING THE CENTER LINE MONUMENTS AT THE INTERSECTION OF BALM STREET WITH ADAMS AVENUE (1518) AND WITH WASHINGTON AVENUE (1546).

WILLOW STREET

THE RIGHT OF WAY FOR THE PORTION OF WILLOW STREET NORTHERLY OF ADAMS AVENUE WAS CREATED PER THE PLAT OF HONAN'S ADDITION AT A WIDTH OF 60.00 FEET. THE ORIGINAL CENTER LINE FOR THIS PORTION OF WILLOW STREET WAS LOCATED BY CREATING RECORD SHAPE OF CENTER LINES FOR WILLOW STREET, HALL STREET, AND JEFFERSON STREET SHOWN ON COUNTY SURVEY 026-2003 AND POSITIONED BY HOLDING THE CENTER LINE MONUMENT AT THE INTERSECTION OF WILLOW STREET WITH ADAMS AVENUE (POINT 1523) AND ROTATING TO THE MONUMENT FOUND AT THE INTERSECTION OF 18TH STREET WITH ADAMS AVENUE (POINT 1528). OREGON DEPARTMENT OF TRANSPORTATION (ODOT) DRAWING 10B-19-7 CREATES A RELOCATED CENTER LINE FOR WILLOW STREET ON BOTH SIDES OF ADAMS AVENUE THAT WAS POSITIONED BY HOLDING THE MONUMENT AT POINT 1548. AND ROTATING RECORD SHAPE TO HOLD THE MONUMENT FOUND AT POINT 1528. ADDITIONAL RIGHT OF WAY WAS ACQUIRED FROM THE "W" AND THE "WE" ALIGNMENT AS SHOWN ON ODOT DRAWING 10B-19-7 AND ALSO SHOWN ON COUNTY SURVEY 036-2014. STATIONING AND RECORD DATA SHOWN ON SAID MAPS WAS CONVERTED FROM METRIC TO INTERNATIONAL FEET. THE PORTION OF WILLOW STREET SOUTHERLY OF ADAMS AVENUE WAS CREATED BY RIGHT OF WAY DEED TO THE CITY OF LA GRANDE PER DOCUMENT NUMBER 113988.

HALL STREET

HALL STREET WAS CREATED AT A WIDTH OF 60.00 FEET PER THE PLAT OF HONAN'S ADDITION, THE CENTER LINE FOR HALL STREET WAS LOCATED BY CREATING RECORD SHAPE OF THE CENTER LINE FOR HALL STREET SHOWN ON COUNTY SURVEY 026-2003 AND POSITIONED BY HOLDING THE CENTER LINE MONUMENT AT THE INTERSECTION OF WILLOW STREET WITH ADAMS AVENUE (POINT 1523) AND ROTATING TO THE MONUMENT FOUND AT THE INTERSECTION OF 18TH STREET WITH ADAMS AVENUE (POINT 1528).

JEFFERSON AVENUE

THE RIGHT OF WAY FOR JEFFERSON AVENUE WAS CREATED BY CARR'S SUBDIVISION OF BLOCKS 13 AND 14 OF HONAN'S ADDITION AT A WIDTH OF 60.00 FEET. THE CENTER LINE FOR JEFFERSON AVENUE WAS LOCATED BY CREATING RECORD SHAPE OF THE CENTER LINE FOR JEFFERSON AVENUE SHOWN ON COUNTY SURVEY 026-2003 AND POSITIONED BY HOLDING THE CENTER LINE MONUMENT AT THE INTERSECTION OF WILLOW STREET WITH ADAMS AVENUE (POINT 1523) AND ROTATING TO THE MONUMENT FOUND AT THE INTERSECTION OF 18TH STREET WITH ADAMS AVENUE (POINT 1528). SAID CENTER LINE WAS EXTENDED TO INTERSECT THE CENTER LINE FOR ADAMS AVENUE.

EIGHTEENTH STREET

THE RIGHT OF WAY FOR EIGHTEENTH STREET WAS ESTABLISHED BY THE PLAT OF HIGHWAY ACRES AT A WIDTH OF 40.00 FEET. THE CENTER LINE FOR EIGHTEENTH STREET WAS ESTABLISEDD BY HOLDING THE CENTER LINE MONUMENT AT THE INTERSECTION OF EIGHTEENTH STREET WITH ADAMS AVENUE (POINT 1528) AND HOLDING RECORD DISTANCE OF 20.00 FROM THE RIGHT OF WAY MONUMENT FOUND AT POINT 1809.

TWENTIETH STREET

THE CENTER LINE FOR TWENTIETH STREET WAS ORIGINALLY ESTABLISHED BY HIGHWAY ACRES SUBDIVISION SHOWN AS A PORTION OF ADAMS AVENUE. A WIDTH WAS NOT FOUND ON SAID SUBDIVISION PLAT, HOWEVER COUNTY SURVEYS 005-1984 AND 043-2013 SHOW A WIDTH OF 80.00 FEET. THE PLATTED CENTER LINE FOR TWENTIETH STREET WAS ESTABLISHED BY RECREATING RECORD SHAPE SHOWN ON SURVEY 043-2013 AND POSITIONED BY HOLDING THE QUARTER CORNER AT POINT 1549 AND ROTATING TO HOLD THE MONUMENT FOUND AT POINT 1869. THE CENTER LINE FOR TWENTIETH STREET WAS RELOCATED PER COUNTY SURVEY 004-2016 AND SAID CENTER LINE WAS RECREATED AND POSITIONED BY HOLDING THE QUARTER CORNER AT POINT 1549. AND ROTATED TO THE MONUMENT AT POINT 1869. STATIONING WAS HELD PER SAID SURVEY 004-2016.

REFERENCE LIST

- GRANDY ADDITION 1884-0003, DATED NOV. 13, 1884
- 2. CHAPLIN'S ADDITION 1884-0004, DATED JULY 14, 1884
- 3. COGGAN'S ADDITION 1886-0002, FILED APR. 2, 1886
- 4. COGGANS' SECOND ADDITION 1889-0002, FILED JAN. 21, 1889
- 5. HONAN'S ADDITION 1890-0005, FILED MAR. 28, 1890
- 6. KAMMERER'S SUBDIVISION 1904-0004, FILED SEPT. 10, 1904
- 7. SUPPLEMENTAL PLAT OF GRANDY'S SECOND ADDITION, 1905-0001, FILED APR. 24, 1905
- 8. LYMANS SUBDIVISION, 1906-0002, FILED NOV. 9, 1906
- 9. CARR'S SUBDIVISON OF BLOCKS 13&14 OF HONAL'S ADDITION FILED MAR. 21, 1911
- 10. YOUNG'S SUB. OF BLKS R.S.& T. OF COGGANS SECOND ADD., 1923-0001, DATED 1923
- 11. HIGHWAY ACRES SUBDIVISION, 1924-0002, FILED MAY 21, 1924
- 12. OREGON STATE HWY. DEPT. DRG. 4B-12-3, DATED JUNE 1932
- 13. OREGON STATE HWY. DEPT. DRG. 6B-35-9, DATED NOV. 1949 14. COUNTY SURVEY NO. 032-1965 BY JAMES VOELZ, DATED SEPT. 23, 1965
- 15. COUNTY SURVEY NO. 038A-1971 BY DUANE I. GRIFFITH, DATED AUG. 1971
- 16. COUNTY SURVEY NO. 043-1971 BY DUANE I. GRIFFITH, DATED AUG. 1971
- 17. COUNTY SURVEY NO. 095-1971 BY DUANE I. GRIFFITH, DATED DEC. 1971
- 18. COUNTY SURVEY NO. 101-1972 BY JAMES VOELZ, DATD NOV. 12, 1971
- 19. COUNTY SURVEY NO. 089-1972 BY DUANE I. GRIFFITH, DATED OCT. 1972
- 20. COUNTY SURVEY NO. 063-1973 BY DUANE I. GRIFFITH, DATED MAY 1, 1973
- 21. COUNTY SURVEY NO. 107-1973, SURVEYOR UNKNOWN, DATED OCT. 23, 1973 22. COUNTY SURVEY NO. 035-1974 BY DUANE I. GRIFFITH, DATED AUG. 1974
- 23. COUNTY SURVEY NO. 010-1975 BY DUANE I. GRIFFITH, DATED APR. 1975
- 24. COUNTY SURVEY NO. 058-1975 BY JAMES VOLEZ, DATED SEPT. 1975
- 25. COUNTY SURVEY NO. 016-1976 BY DUANE I. GRIFFITH. DATED MAR. 1976
- 26. COUNTY SURVEY NO. 019-1981 BY DUANE I. GRIFFITH. DATED MAR. 1981
- 27. COUNTY SURVEY NO. 028-1982, BY GREGORY T. BLACKMAN, FILED AUG. 9, 1982
- 28. COUNTY SURVEY NO. 030-1982 BY GREGORY T. BLACKMAN, FILED AUG. 9. 1982
- 29. COUNTY SURVEY NO. 041-1982 BY GREGORY T. BLACKMAN, FILED NOV. 15, 1982
- 30. COUNTY SURVEY NO. 006-1983 BY GARY L. LANGLITZ, FILED FEB. 10, 1983
- 31. COUNTY SURVEY NO. 006-1984 BY GREGORY T. BLACKMAN, FILED MAR. 31, 1984 32. COUNTY SURVEY NO. 032-1986 BY GREGORY T. BLACKMAN. FILED OCT. 13. 1986
- 33. COUNTY SURVEY NO. 024-1987 BY GREGORY T. BLACKMAN, FILED SEPT. 14, 1987
- 34. COUNTY SURVEY NO. 013-1988 BY DUANE I. GRIFFITH AND NORMAN J. PAULLUS JR., FILED JUNE 3, 1988

REGISTERED **PROFESSIONAL** LAND SURVEYOR

BAER OREGON JANUARY 14, 2003 BRET N. ELITHORP 63148

RENEWS: 12-31-2025

UNION COUNTY SURVEYOR

86. R/W DEED 113998

Date Received: 3/12/24 Date Filed: 3/13/24

013-2024

OREGON DEPARTMENT OF TRANSPORTATION

HORIZONTAL CONTROL, RECOVERY AND RETRACEMENT MAP US30 (ADAMS AVE): ALDER ST. TO "H" AVE., LA GRANDE LA GRANDE – BAKER HIGHWAY (US30)

UNION COUNTY, OREGON

ODOT REGION 5 TECH CENTER 3012 ISLAND AVENUE LA GRANDE, OR 97850

35. COUNTY SURVEY NO. 018-1989 BY A.H. McLAIN, DATED 1922

36. COUNTY SURVEY NO. 034-1990 BY GREGORY T. BLACKMAN, FILED OCT. 15, 1990

37. COUNTY SURVEY NO. 002-1992 BY NORMAN J. PAULLUS JR., FILED FEB. 3, 1992

39. COUNTY SURVEY NO. 010-1992 BY NORMAN J. PAULLUS JR. FILED APR. 16, 1992

40. COUNTY SURVEY NO. 024-1992 BY NORMAN J. PAULLUS JR., FILED OCT. 17, 1992

38. COUNTY SURVEY NO. 004-1992 BY DUANE I. GRIFFITH, FILED FEB. 10, 1992

41. COUNTY SURVEY NO. 001-1993 BY DUANE I. GRIFFITH FILED JAN. 30, 1993

42. COUNTY SURVEY NO. 046-1993 BY DUANE I. GRIFFITH FILED DEC. 14, 1993

44. PARTITION PLAT NO. 1995-007T BY JEFFREY S. HSU FILED APR. 7, 1995

45. COUNTY SURVEY NO. 012-1996 BY RICK G. ROBINSON, FILED MAR. 6, 1996

48. COUNTY SURVEY NO. 008-1998 BY RICK G. ROBINSON, FILED MAR. 17, 1998

51. COUNTY SURVEY NO. 039-2001 BY RICK G. ROBINSON, FILED NOV. 19, 2001

54. OREGON DEPT. OF TRANS. 10B-19-07 DATED APR. 2004

50. COUNTY SURVEY NO. 026-2001 BY GARY R. ANDERSON, FILED SEPT. 10, 2001

52. COUNTY SURVEY NO. 026-2003 BY RICK G. ROBINSON, FILED SEPT. 12, 2003

55. COUNTY SURVEY NO. 005-2004 BY ROBERT E. BUTLER, FILED APR. 05, 2004

56. COUNTY SURVEY NO. 008-2004 BY RICK G. ROBINSON, FILED APR. 20, 2004

57. COUNTY SURVEY NO. 035-2004 BY PETER C. ELDER, FILED NOV. 10, 2004

53. COUNTY SURVEY NO. 031-2003 BY GREGORY T. BLACKMAN, FILED OCT. 31, 2003

58. COUNTY SURVEY NO. 003-2005 BY NORMAN J. PAULLUS JR., FILED APR. 2, 2005

59. COUNTY SURVEY NO. 020-2005 BY HARMON E. MCLENDON, FILED OCT. 15, 2005 60. COUNTY SURVEY NO. 022-2005 BY MICHAEL B. POSADA, FILED OCT. 22, 2005

61. COUNTY SURVEY NO. 040-2006 BY RICK G. BLACKMAN, FILED NOV. 27, 2006

62. COUNTY SURVEY NO. 015-2007 BY RICK G. ROBINSON, FILED SEPT. 6, 2007

63. COUNTY SURVEY NO. 026-2007 BY RICK G. ROBINSON FILED OCT. 1, 2007

64. COUNTY SURVEY NO. 043-2013 BY RICK G. ROBINSON, FILED SEPT. 5, 2013

65. COUNTY SURVEY NO. 005-2014 BY JEFFREY S. HSU, FILED FEB. 28, 2014

66. COUNTY SURVEY NO. 013-2014 BY RICK G. ROBINSON, FILED MAY 7, 2014

67. COUNTY SURVEY NO. 036-2014 BY ROBERT E. BUTLER, FILED NOV. 18, 2014

68. COUNTY SURVEY NO. 002-2016 BY BRET N. ELITHORP, FILED JAN. 14, 2016

69. COUNTY SURVEY NO. 004-2016 BY JEFFREY A. MADSEN, FILED JAN. 8, 2016

70. COUNTY SURVEY NO. 019-2016 BY RICK G. ROBINSON, FILED JULY 18, 2016

72. COUNTY SURVEY NO. 013-2017 BY JEFFREY S. HSU, FILED MAY 10, 2017

73. COUNTY SURVEY NO. 020-2017 BY JEFFREY S. HSU, FILED JUNE 6, 2017

74. COUNTY SURVEY NO. 031-2017 BY JEFFREY S. HSU, FILED AUG. 23, 2017

76. COUNTY SURVEY NO. 014-2018 BY JEFFREY S. HSU, FILED APR. 25, 2018

77. COUNTY SURVEY NO. 041-2018 BY JEFFERY S. HSU, FILED OCT. 24, 2018

78. COUNTY SURVEY NO. 007-2019 BY JEFFREY S. HSU, FILED MAY 10, 2019

79. COUNTY SURVEY NO. 001-2020 BY JEFFREY S. HSU, FILED FEB. 11, 2020

80. COUNTY SURVEY NO. 014-2021 BY JEFFREY S. HSU, FILED MAY 3, 2021

81. COUNTY SURVEY NO. 017-2021 BY JEFFERY S. HSU, FILED MAY 6, 2021

82. COUNTY SURVEY NO. 020-2021 BY JEFFREY S. HSU, FILED MAY 20, 2021

83. COUNTY SURVEY NO. 004-2022 BY JEFFREY S. HSU, FILED FEB. 28, 2022

84. COUNTY SURVEY NO. 033-2022 BY JEFFREY S. HSU, FILED NOV. 30, 2022

85. COUNTY SURVEY NO. 007-2023 BY JEFFREY S. HSU, FILED MAR. 16, 2023

75. COUNTY SURVEY NO. 044-2017 BY BRET. N. ELITHORP, FILED NOV. 7, 2017

71. COUNTY SURVEY NO. 029-2016 BY RICK G. ROBINSON, FILED SEPT. 28, 2016


43. PARTITION PLAT 1994-0019T, BY GREGORY T. BLACKMAN FILED OCT 13, 1994


46. COUNTY SURVEY NO. 011-1997 BY GREGORY T. BLACKMAN, FILED APR. 15, 1997


47. COUNTY SURVEY NO. 006-1998 BY GREGORY R. BLACKMAN, FILED MAR. 4, 1998


49. COUNTY SURVEY NO. 002-2000 BY GREGORY T. BLACKMAN, FILED APR. 15, 2000


KEY NO. 22754/N00042 MARCH 11, 2024 NO SCALE SHEET 2 OF 15

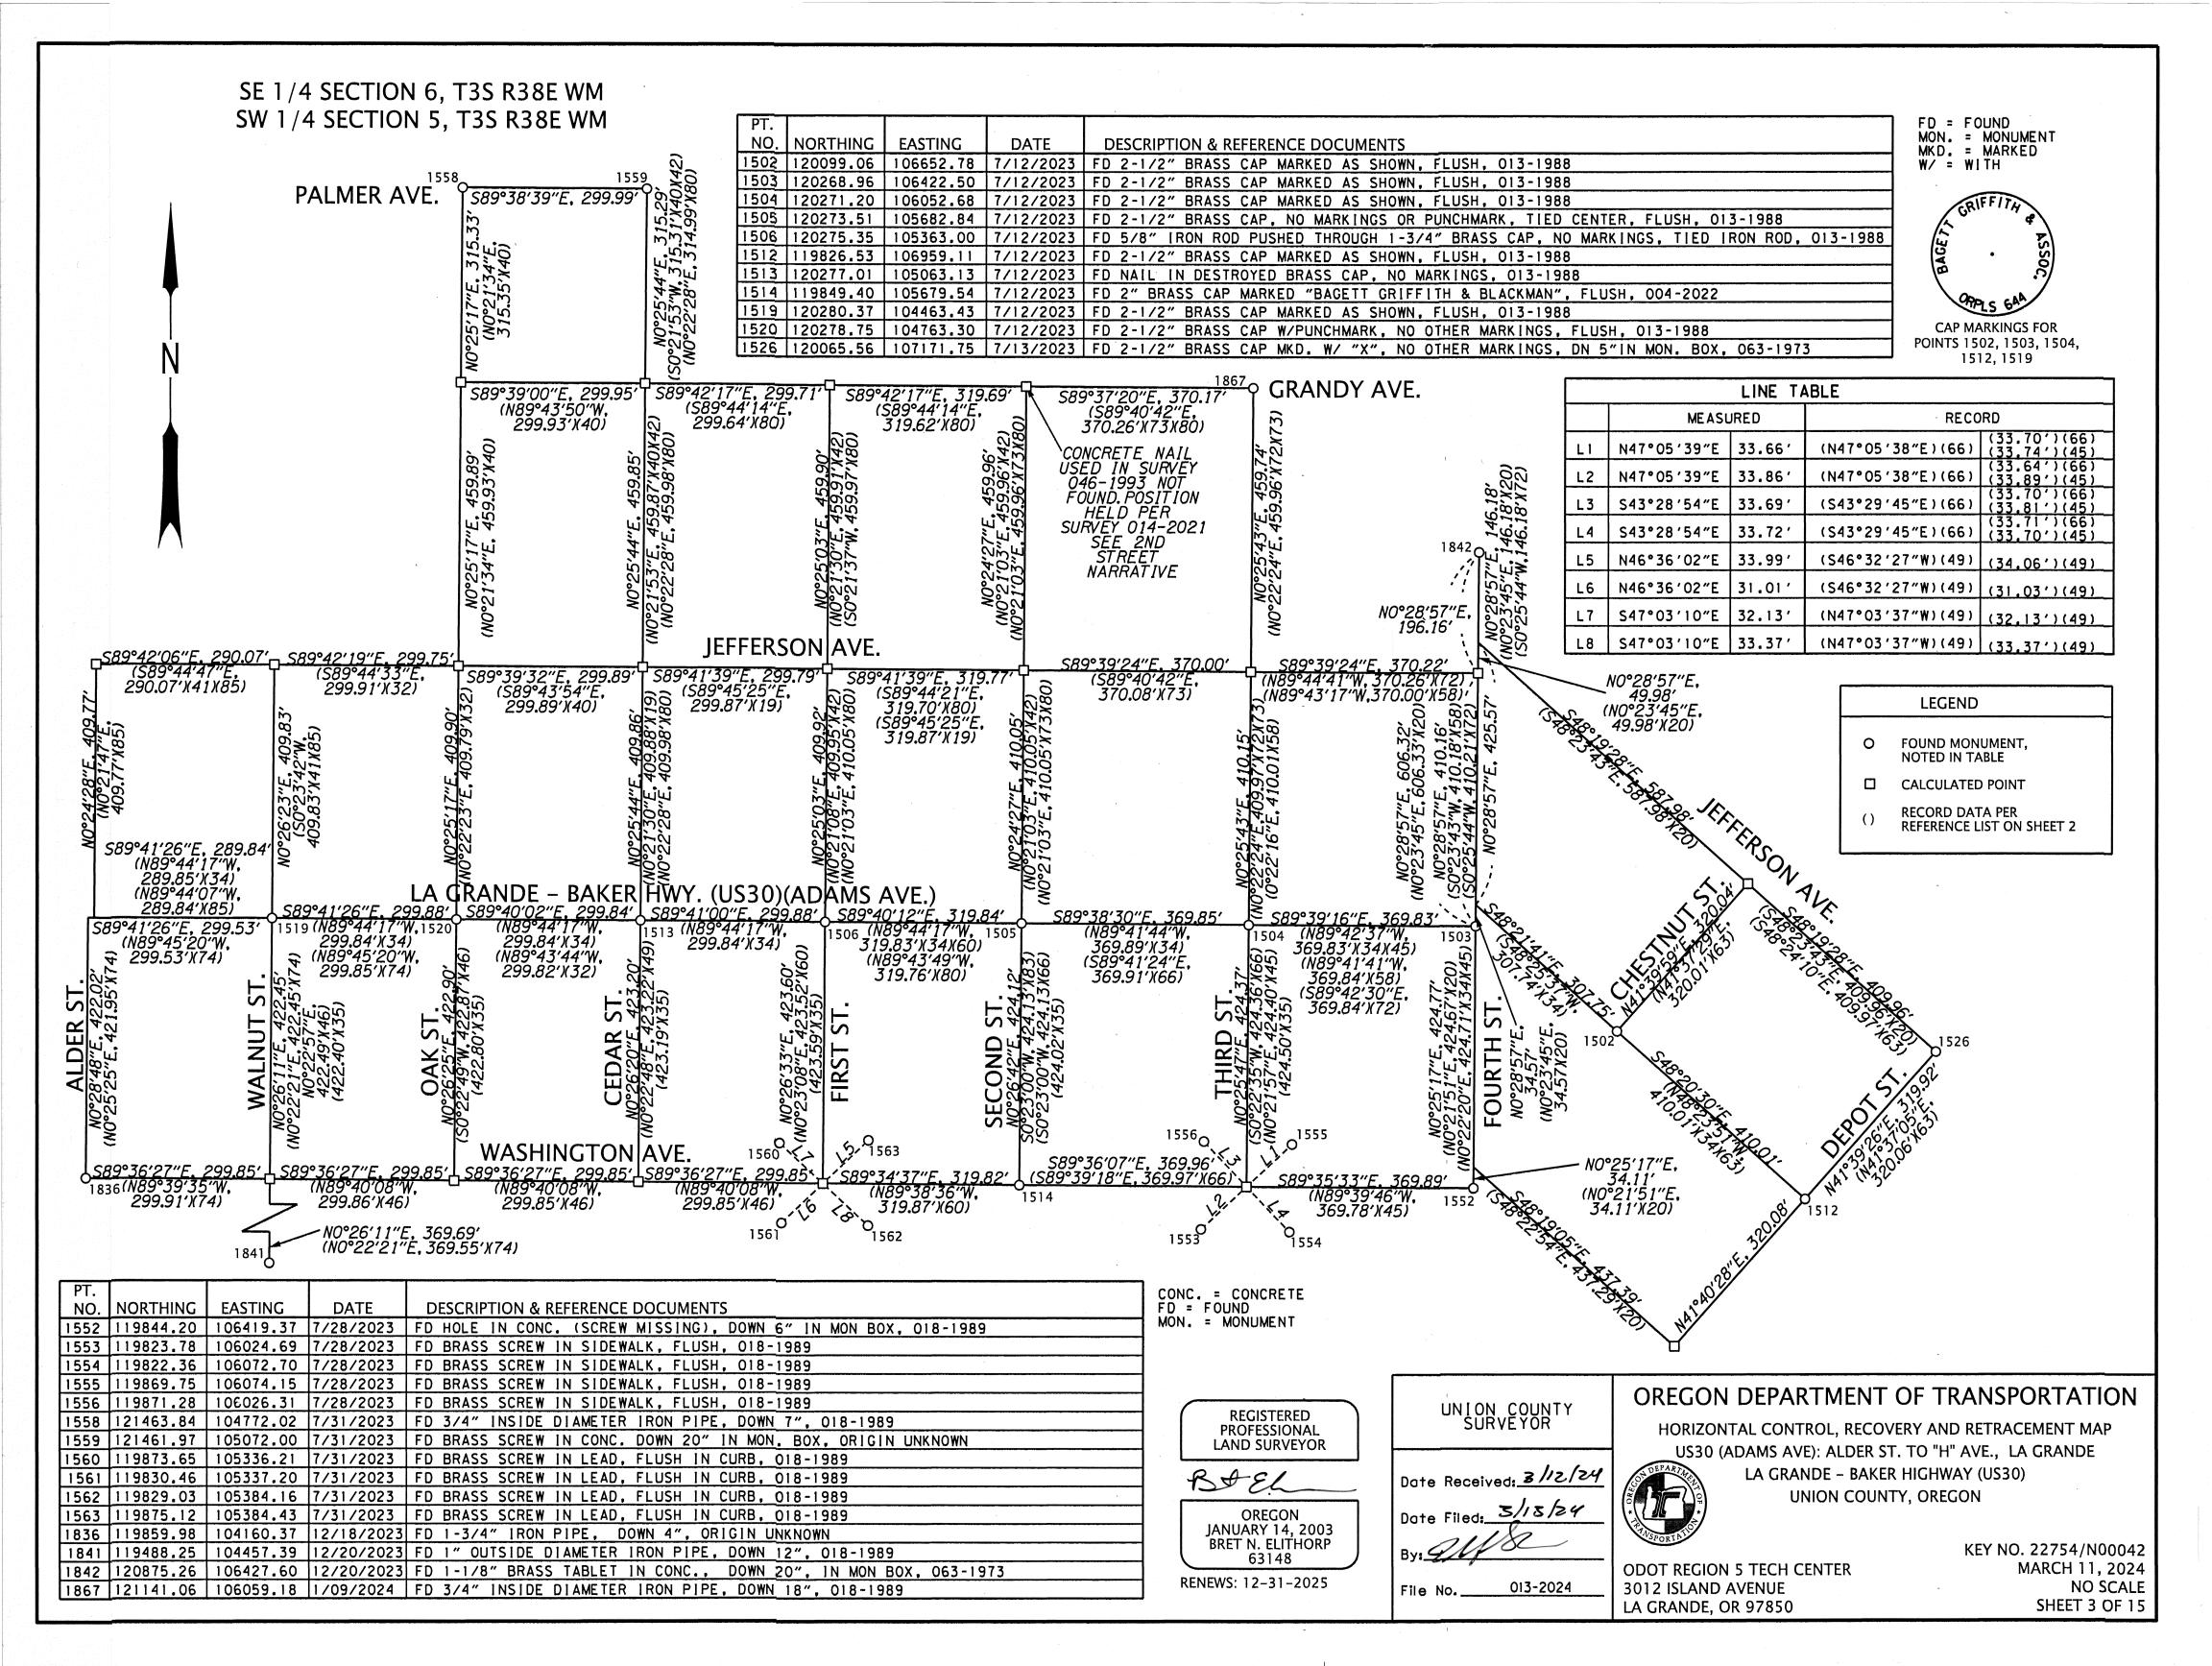


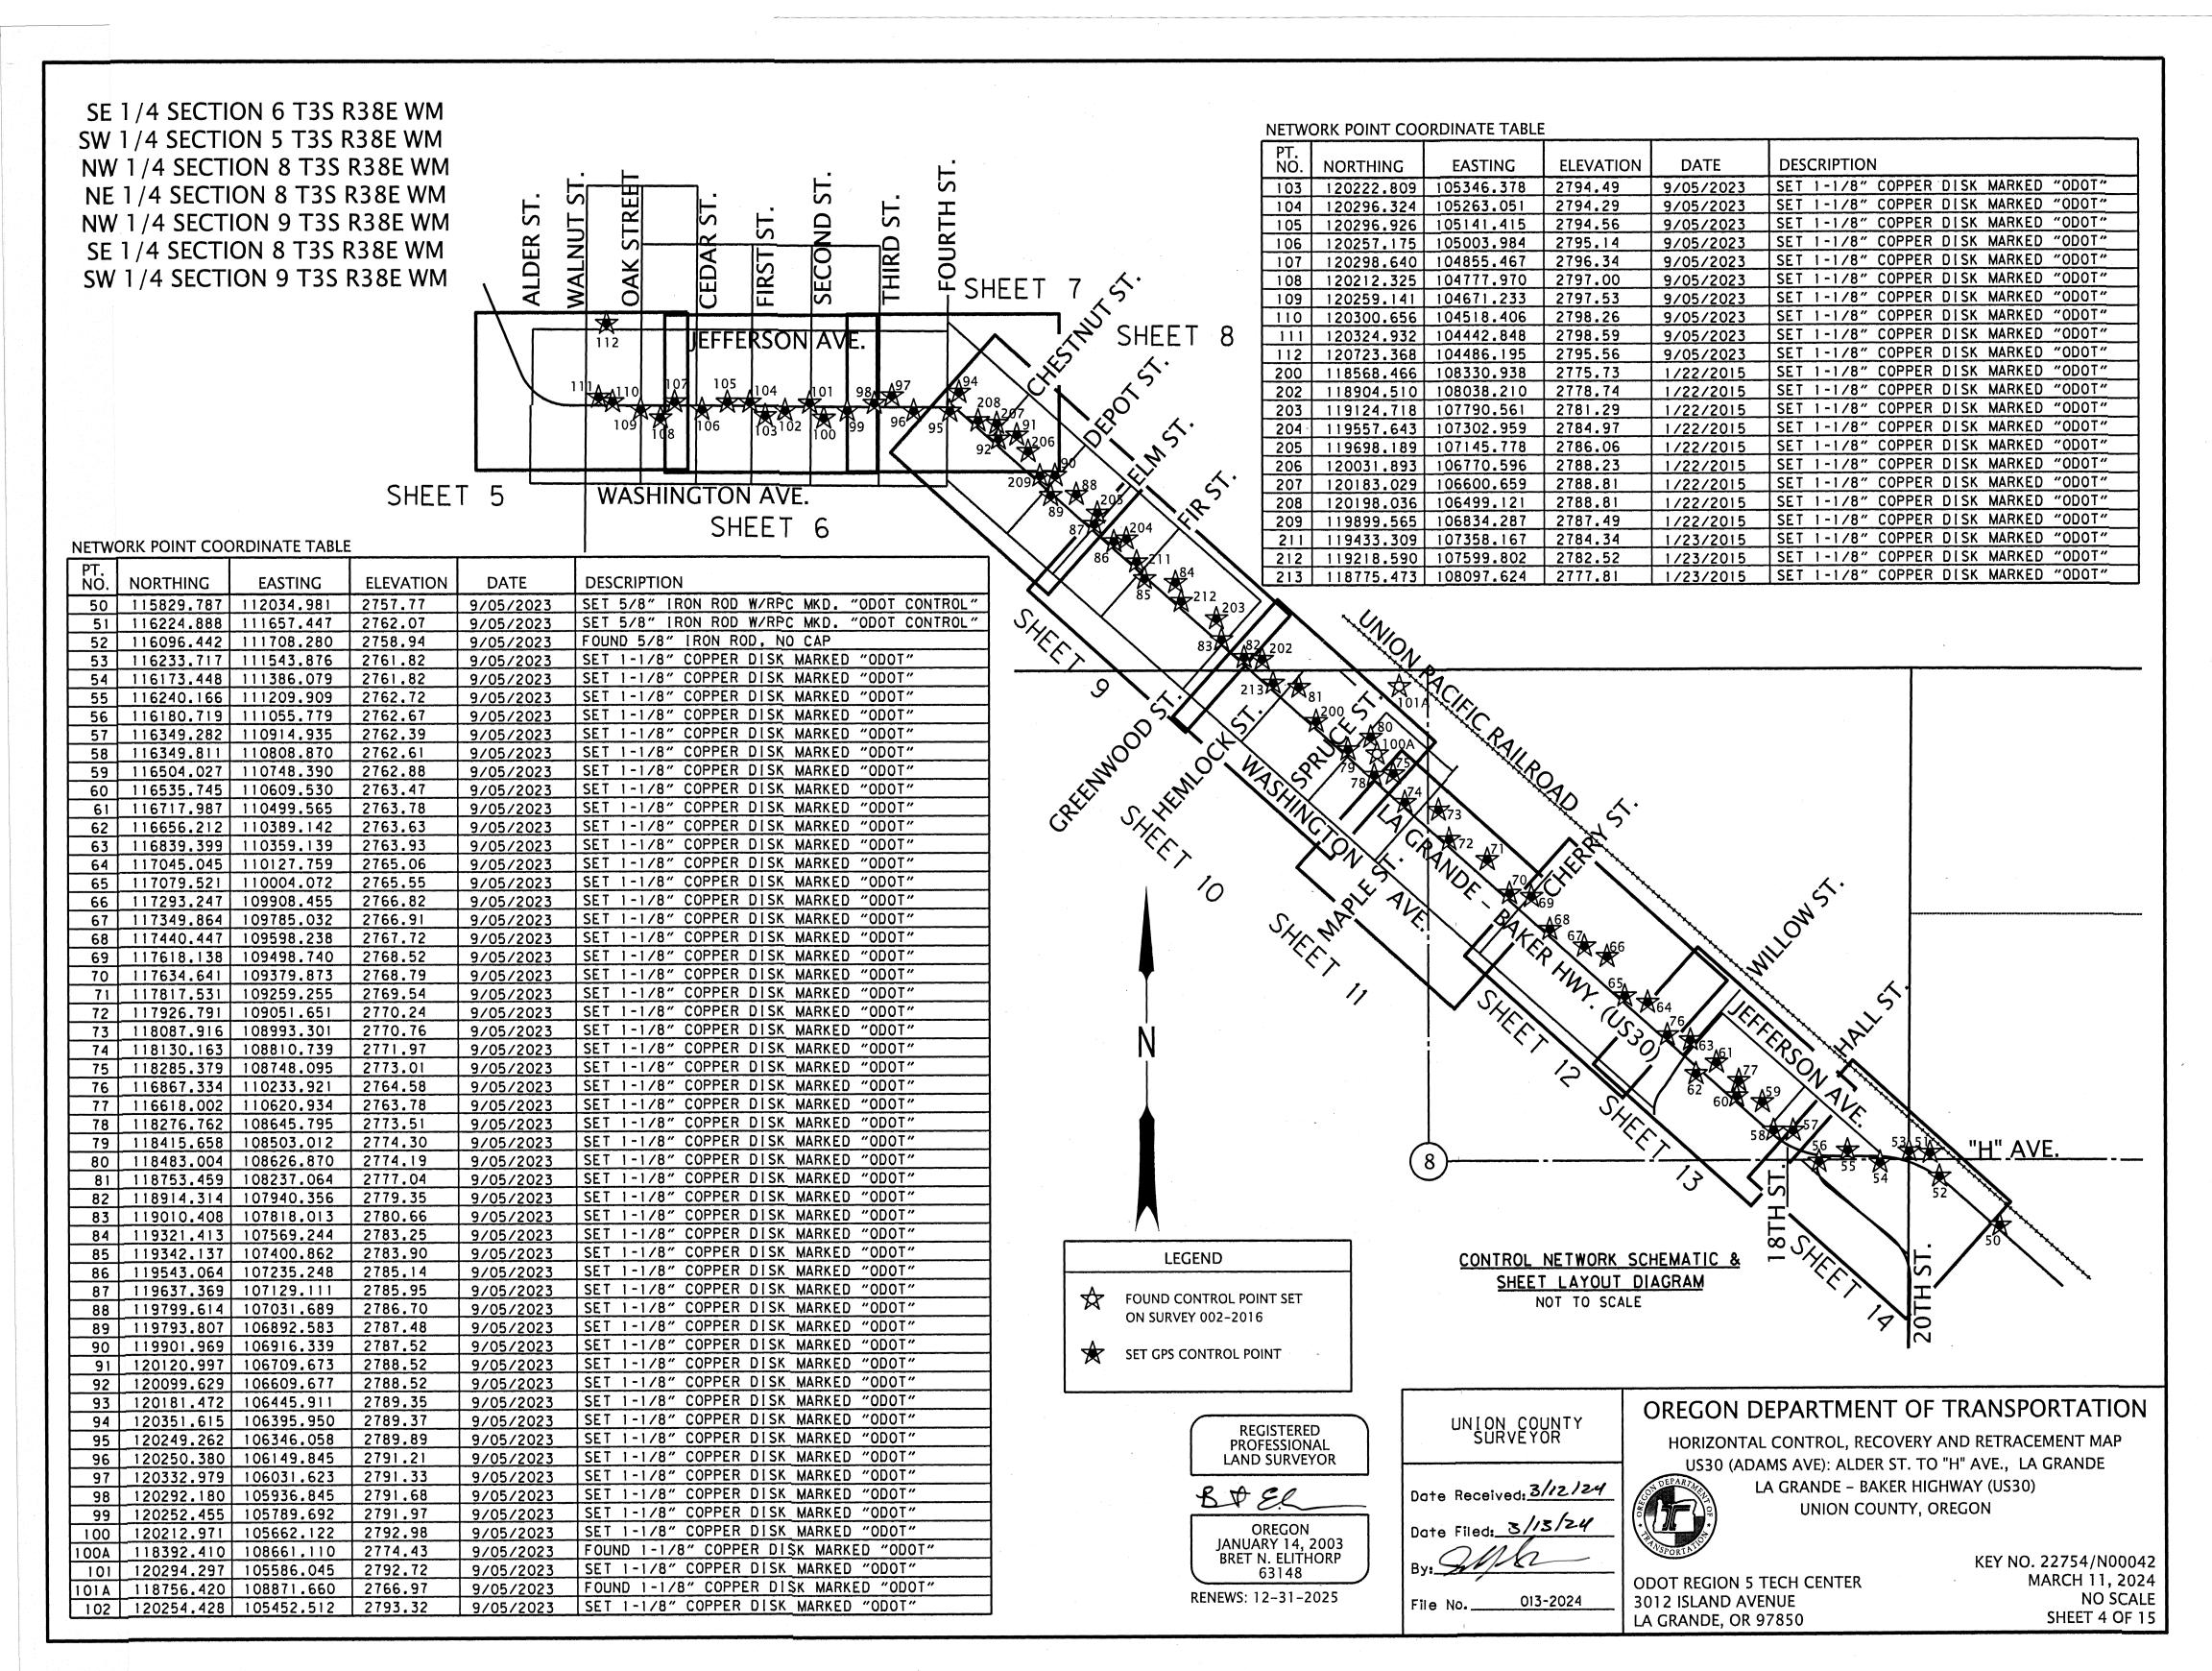


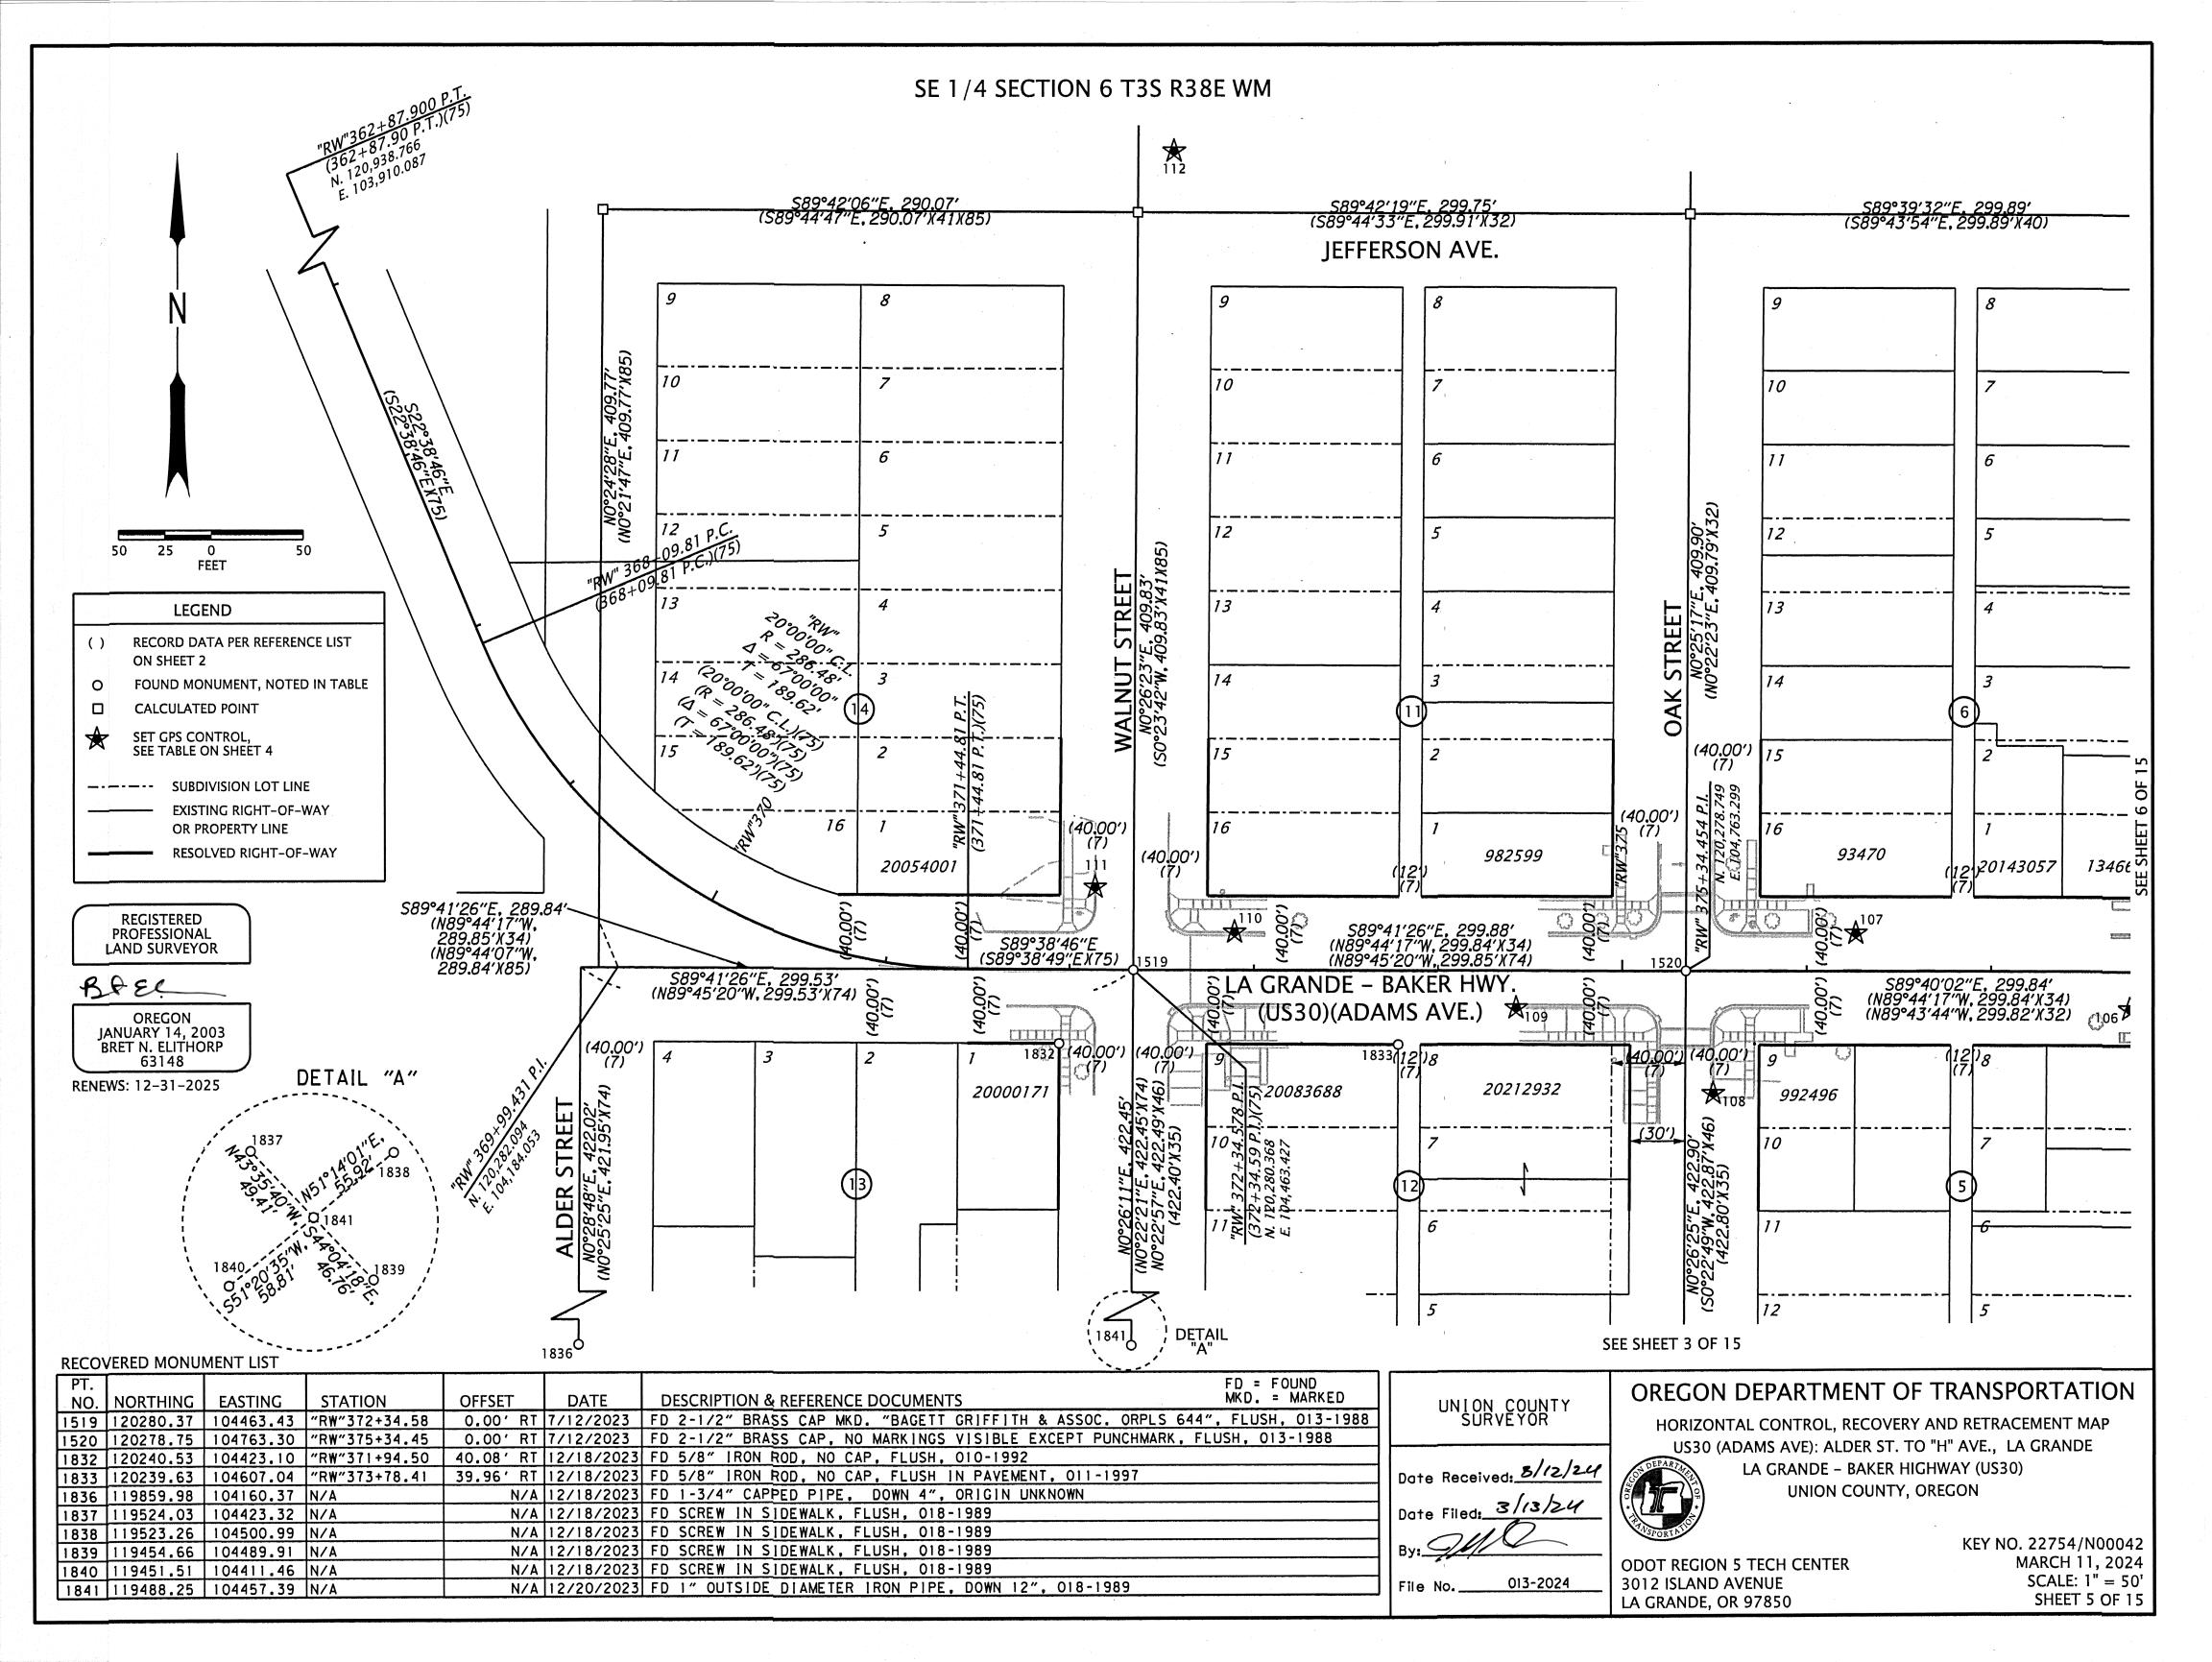


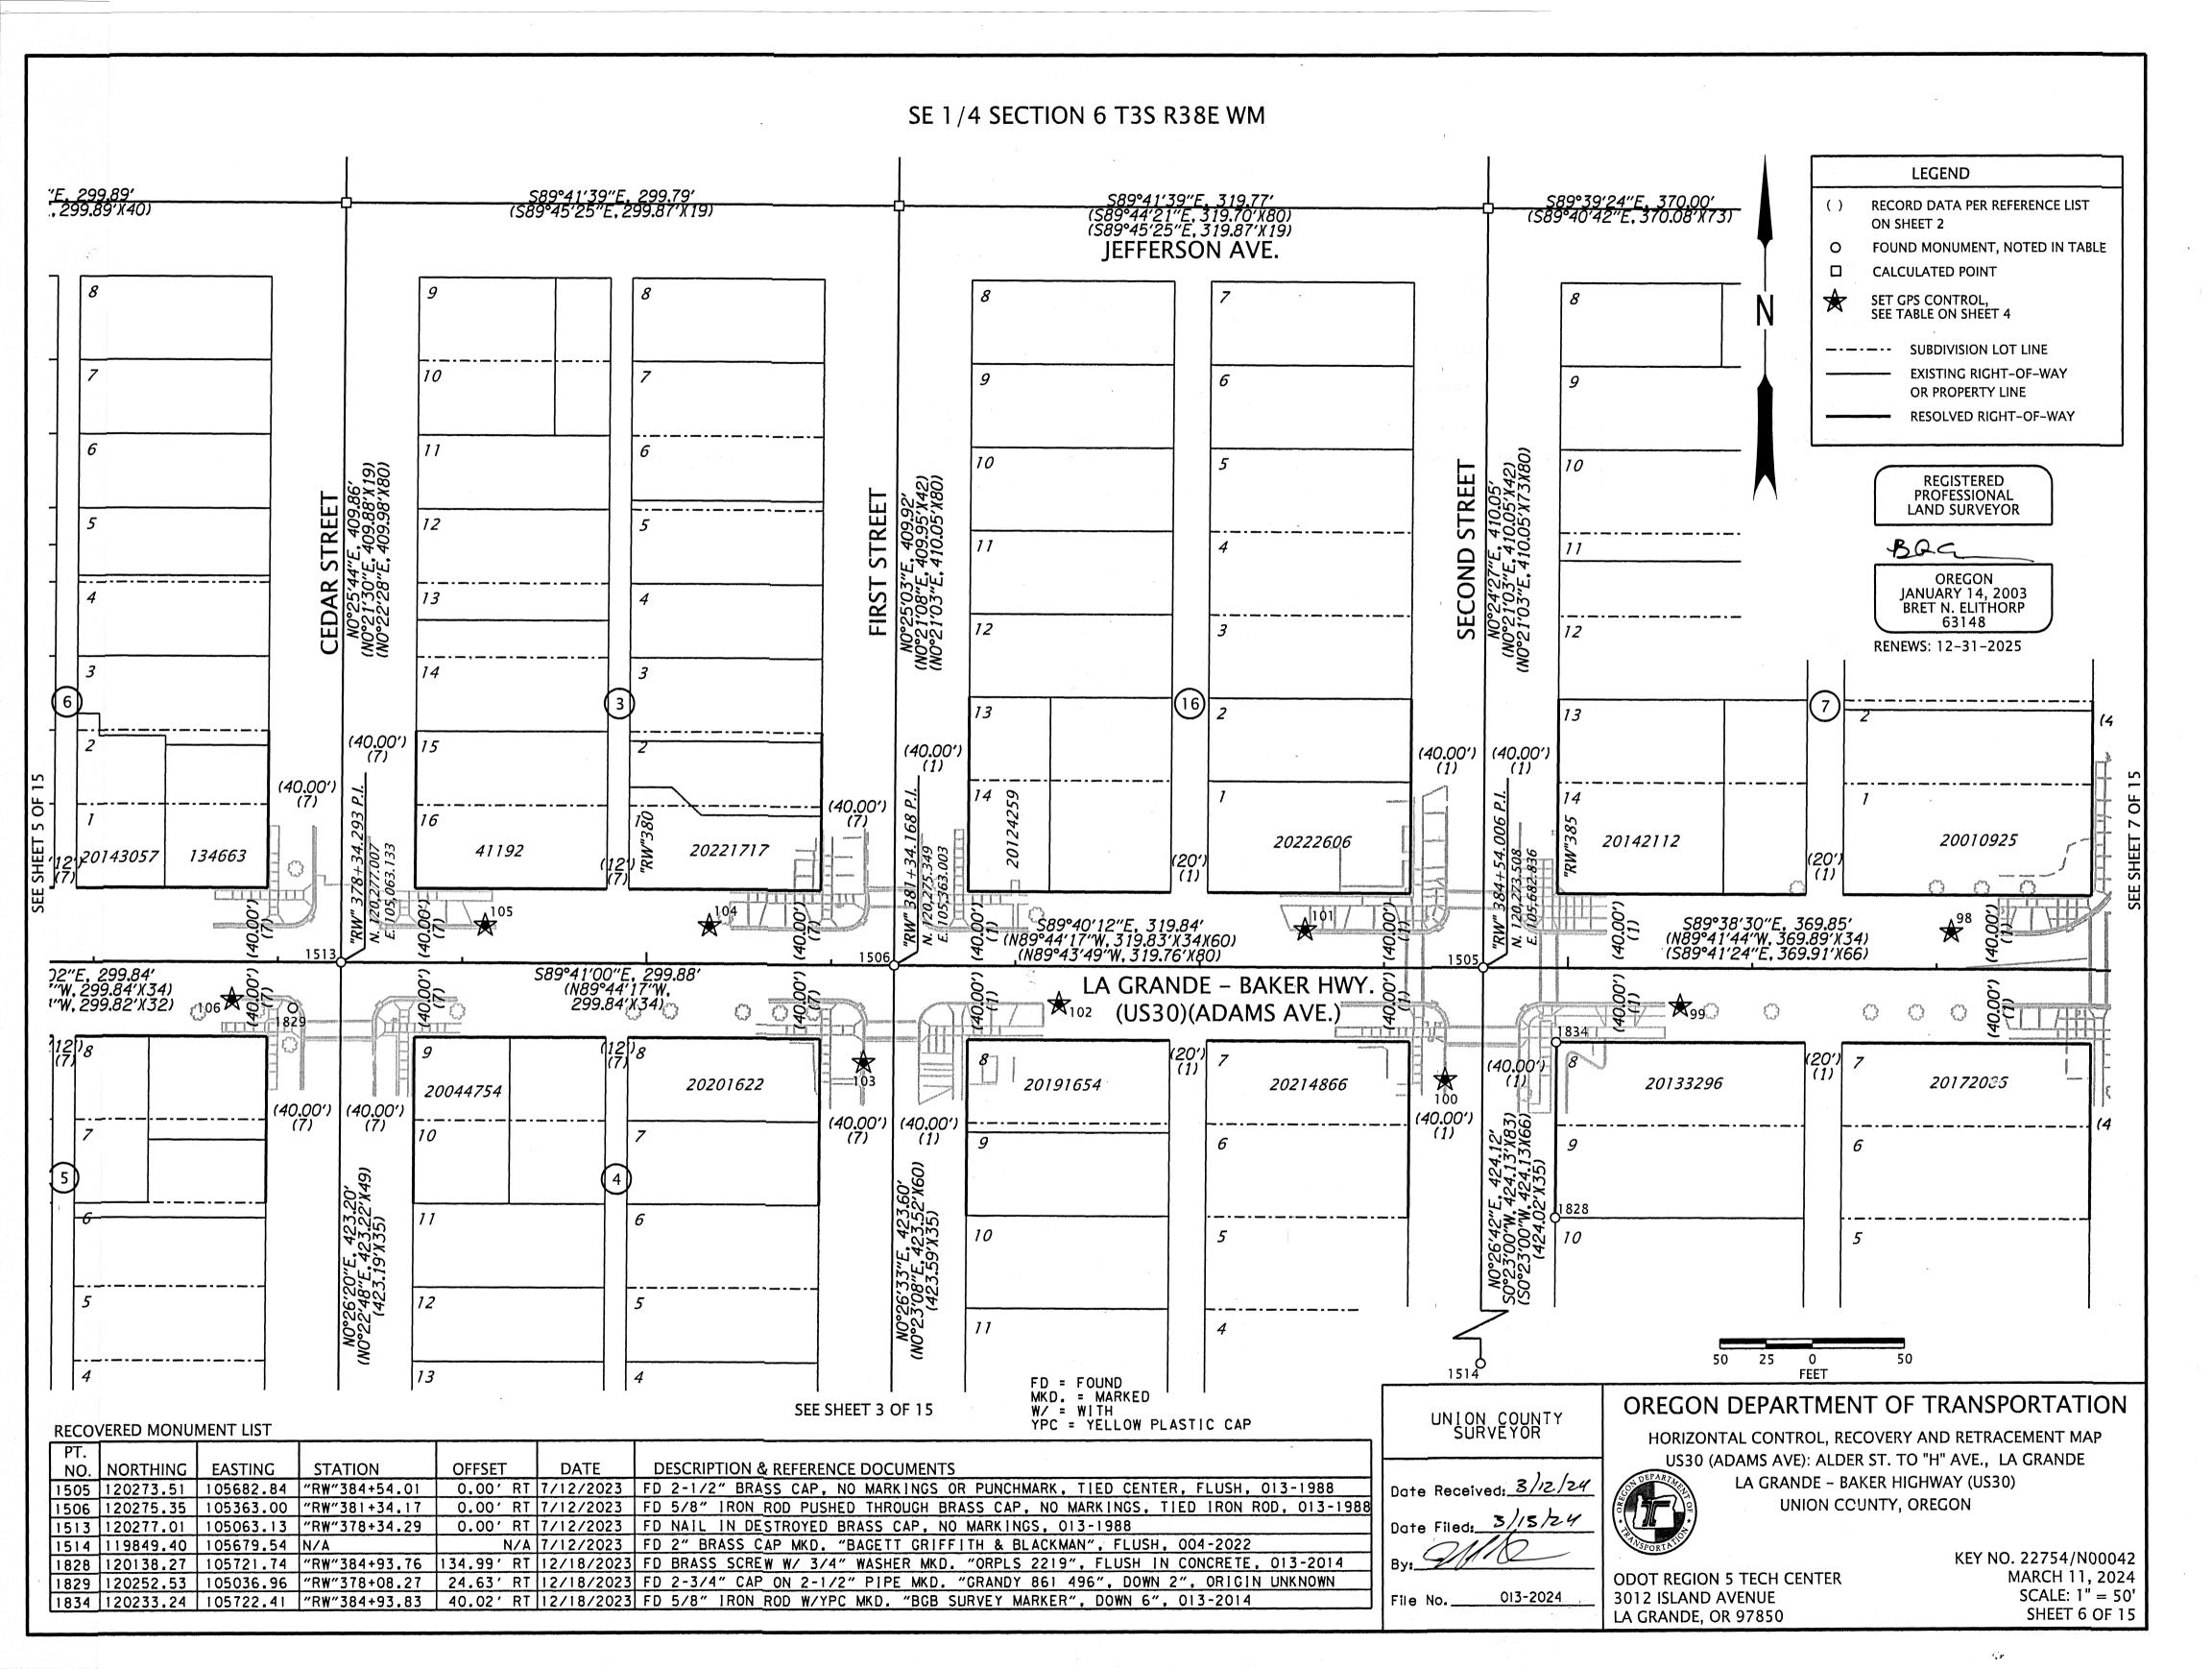


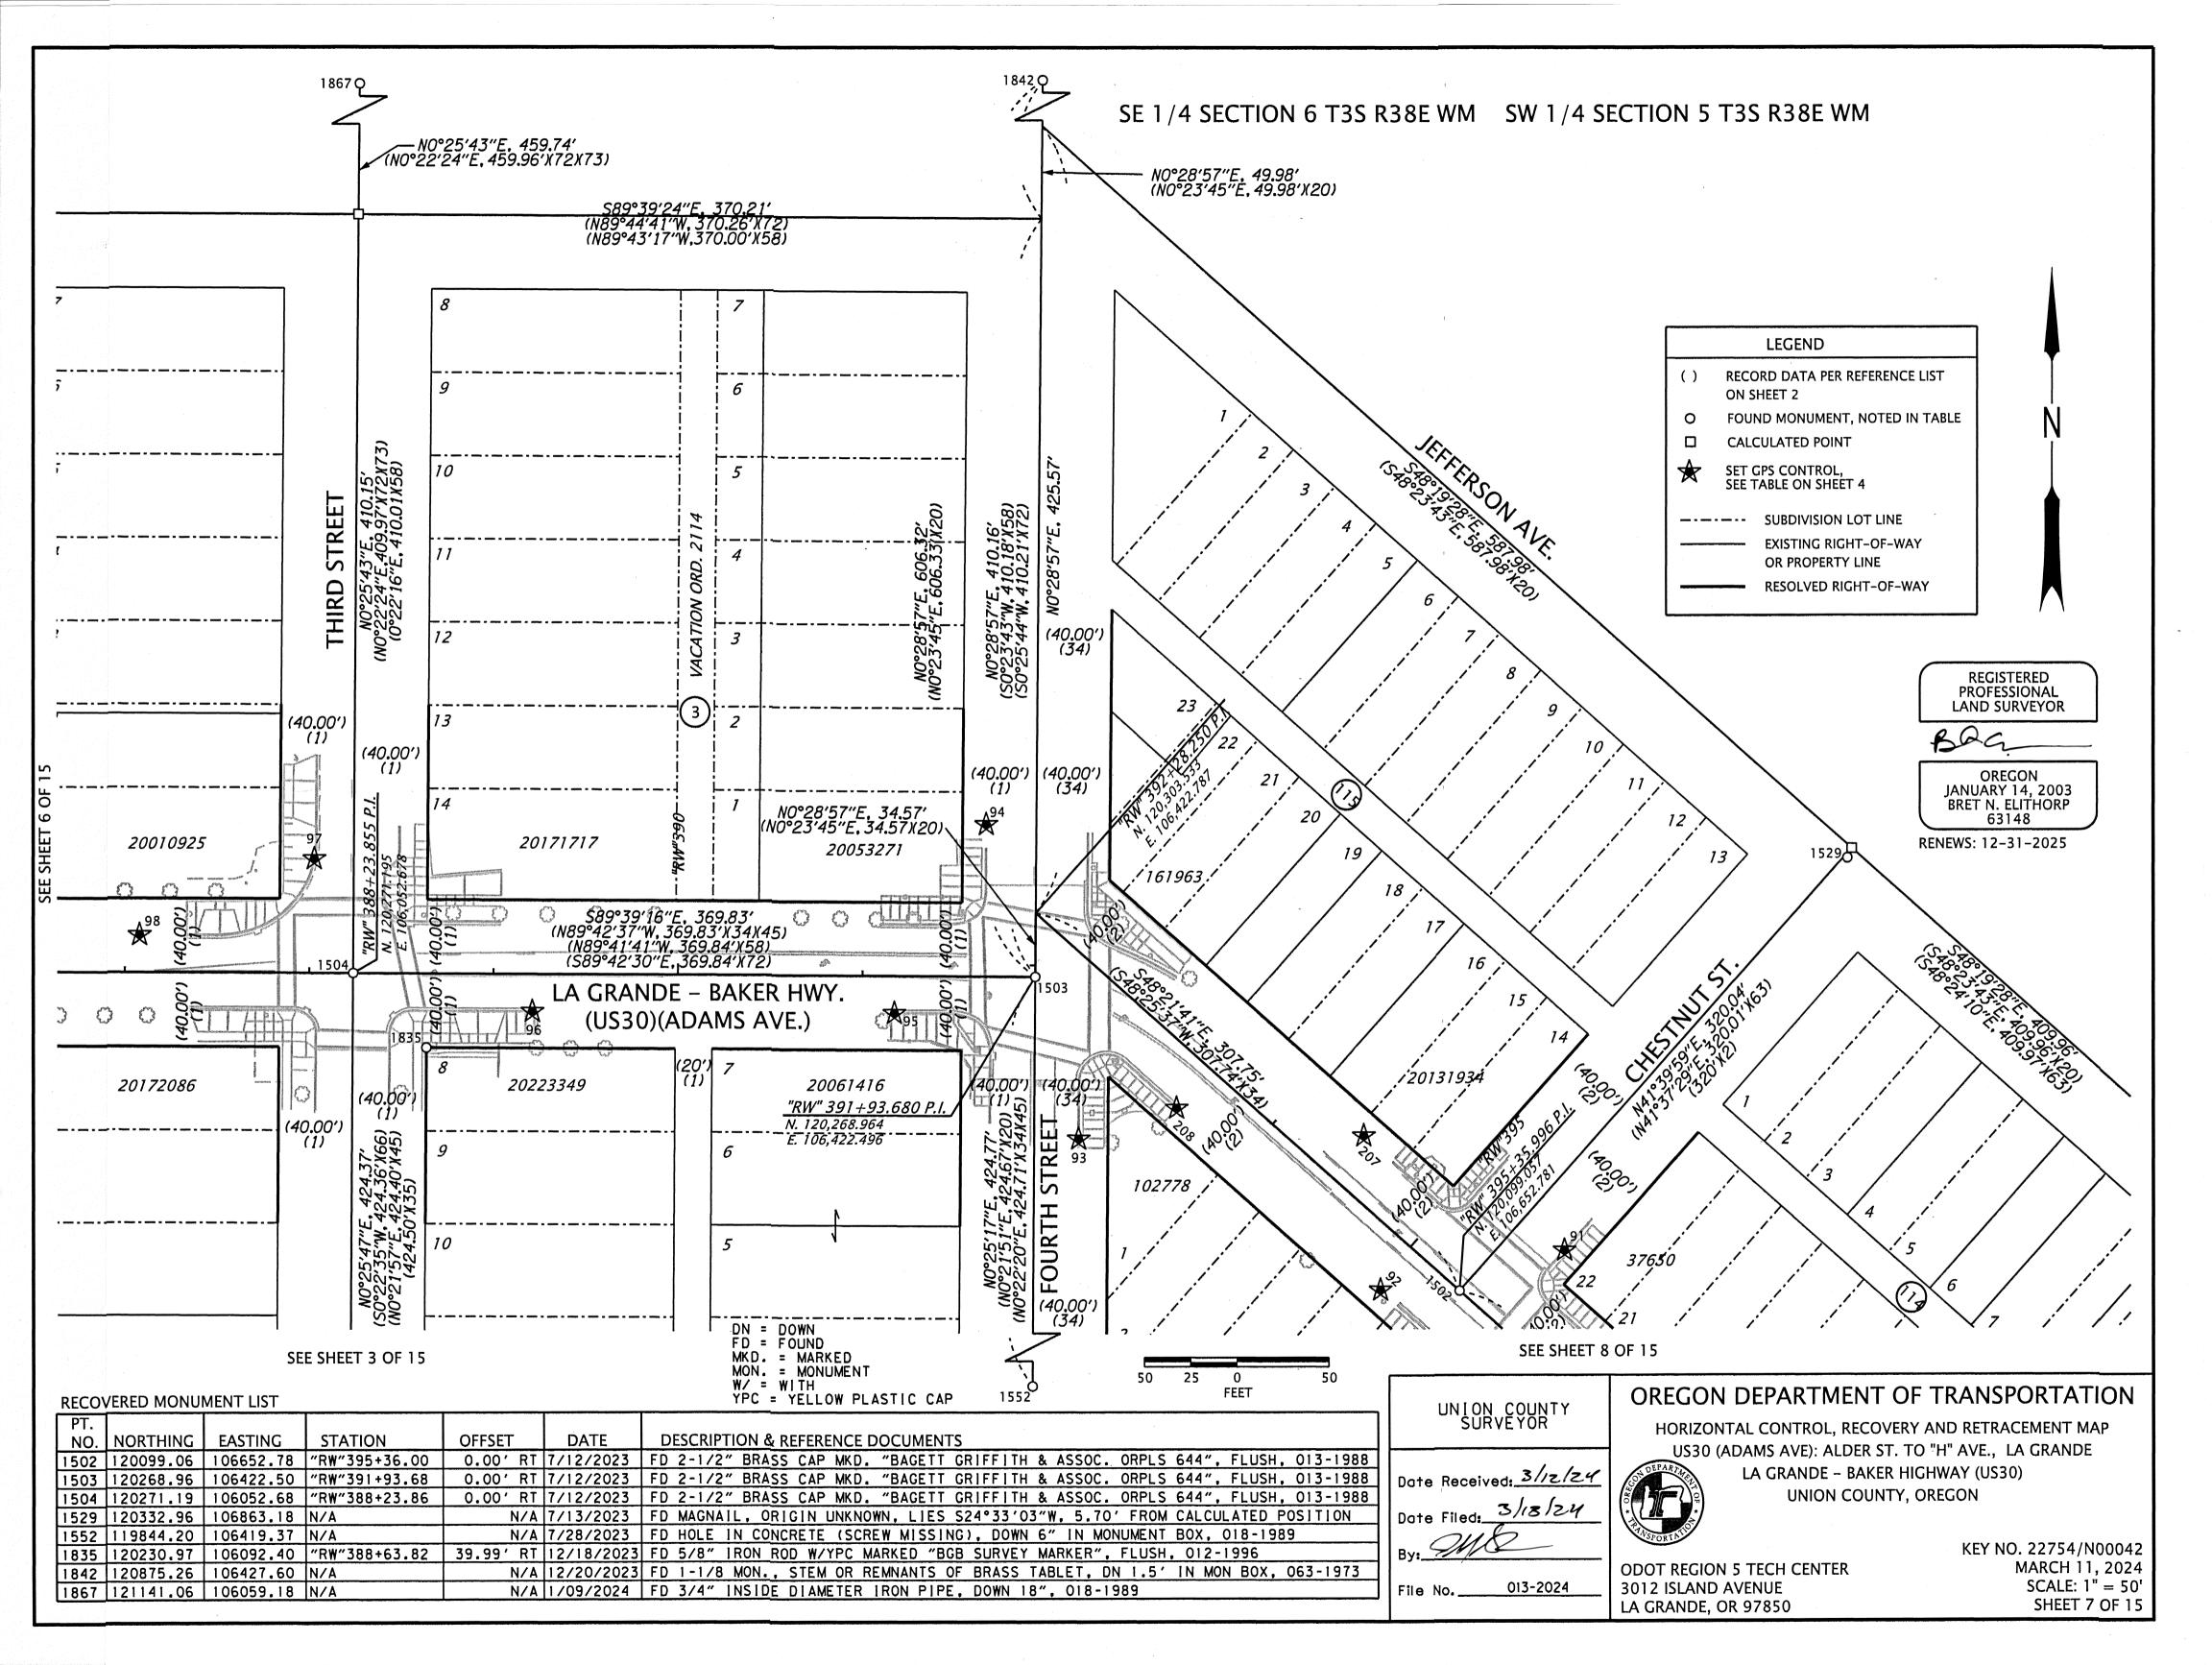


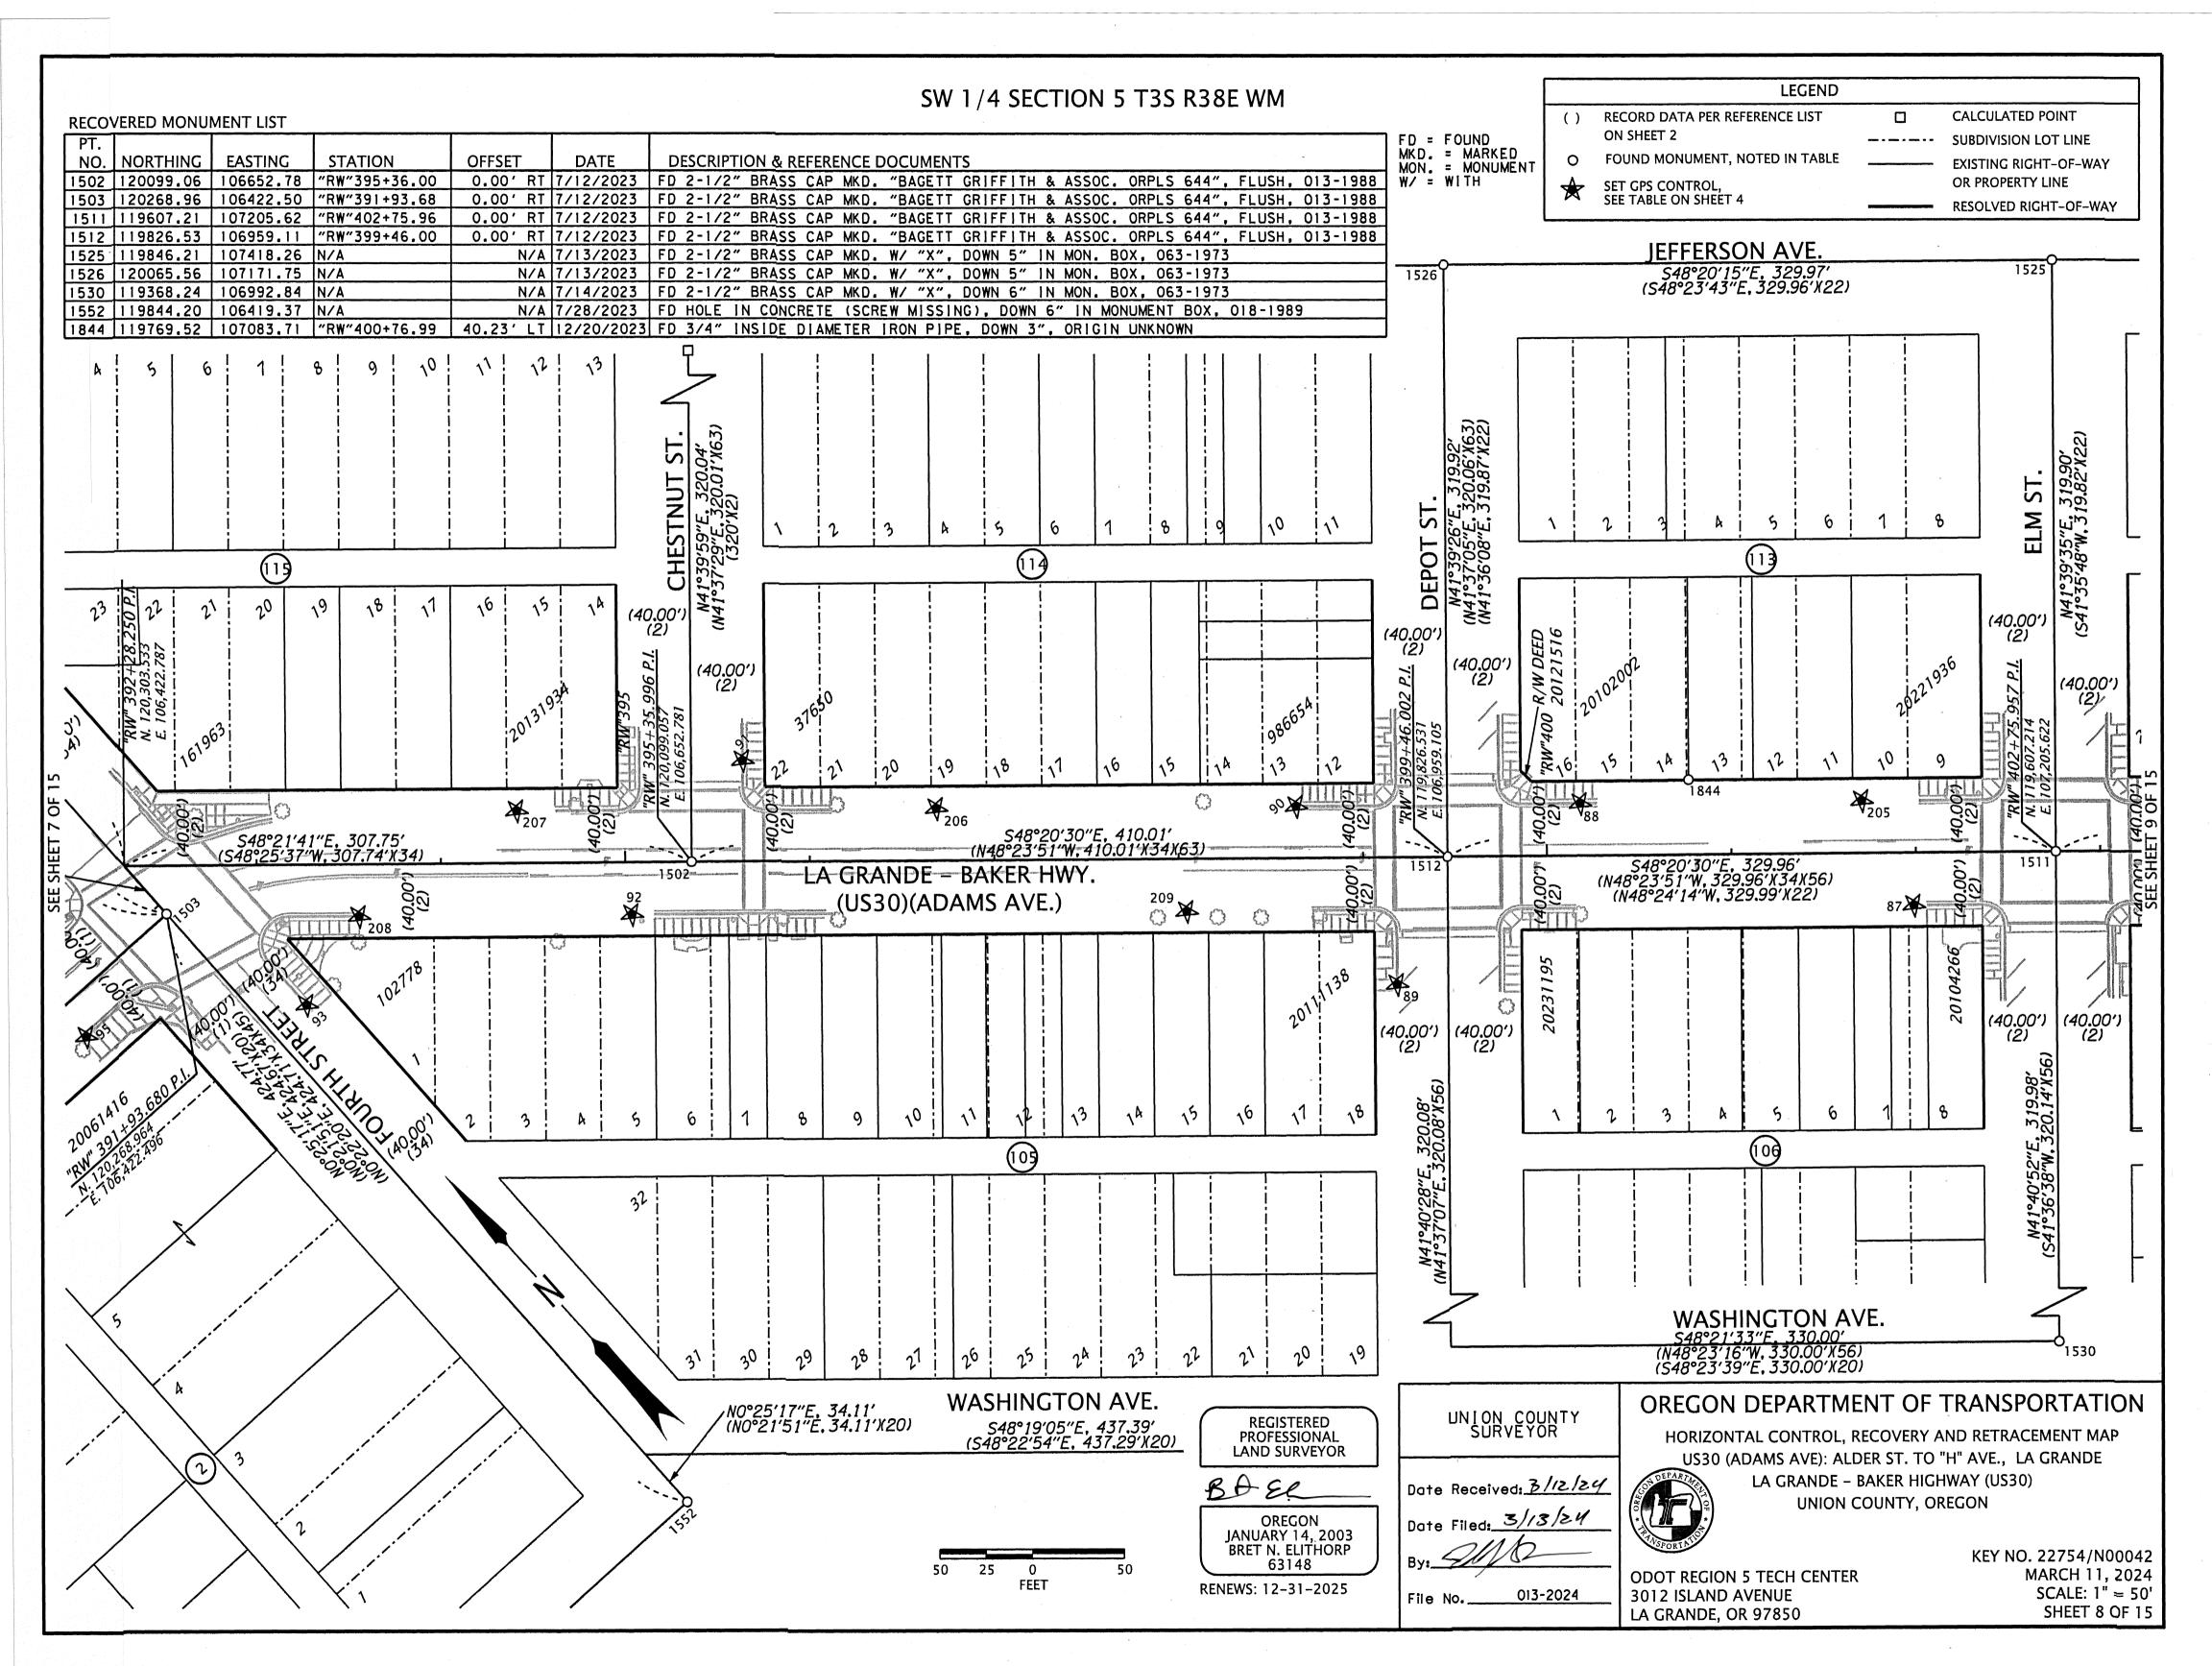


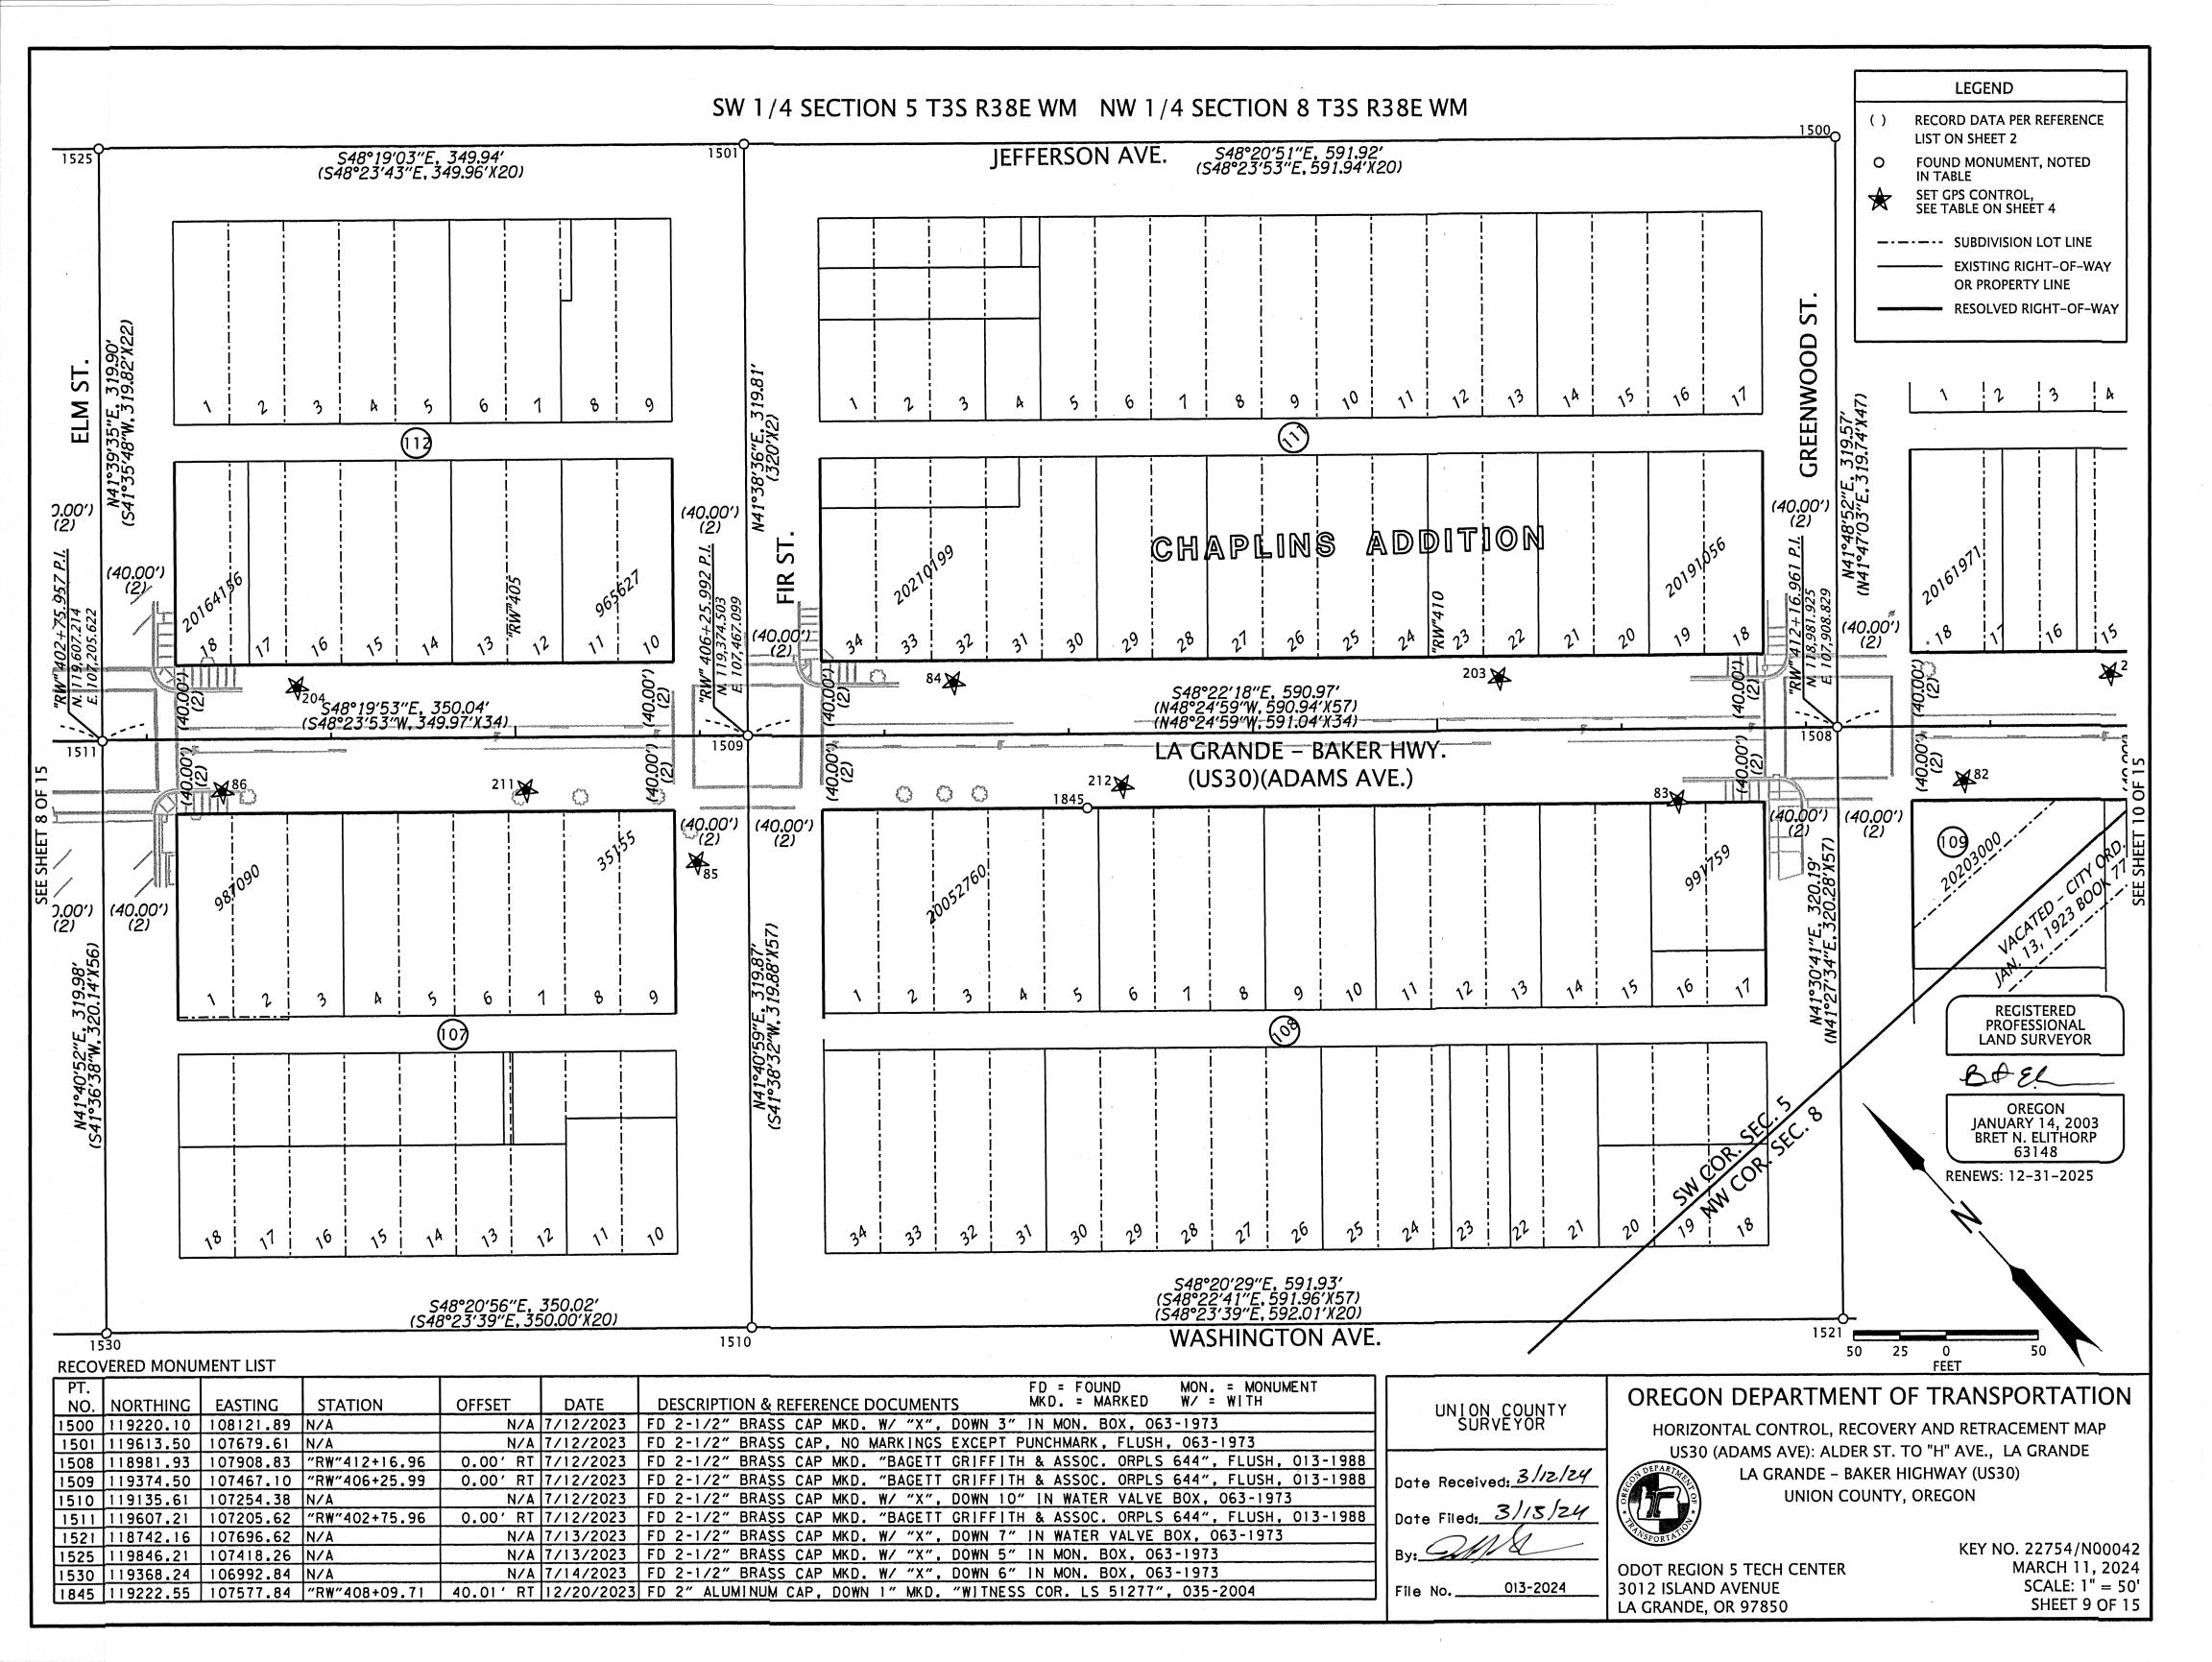


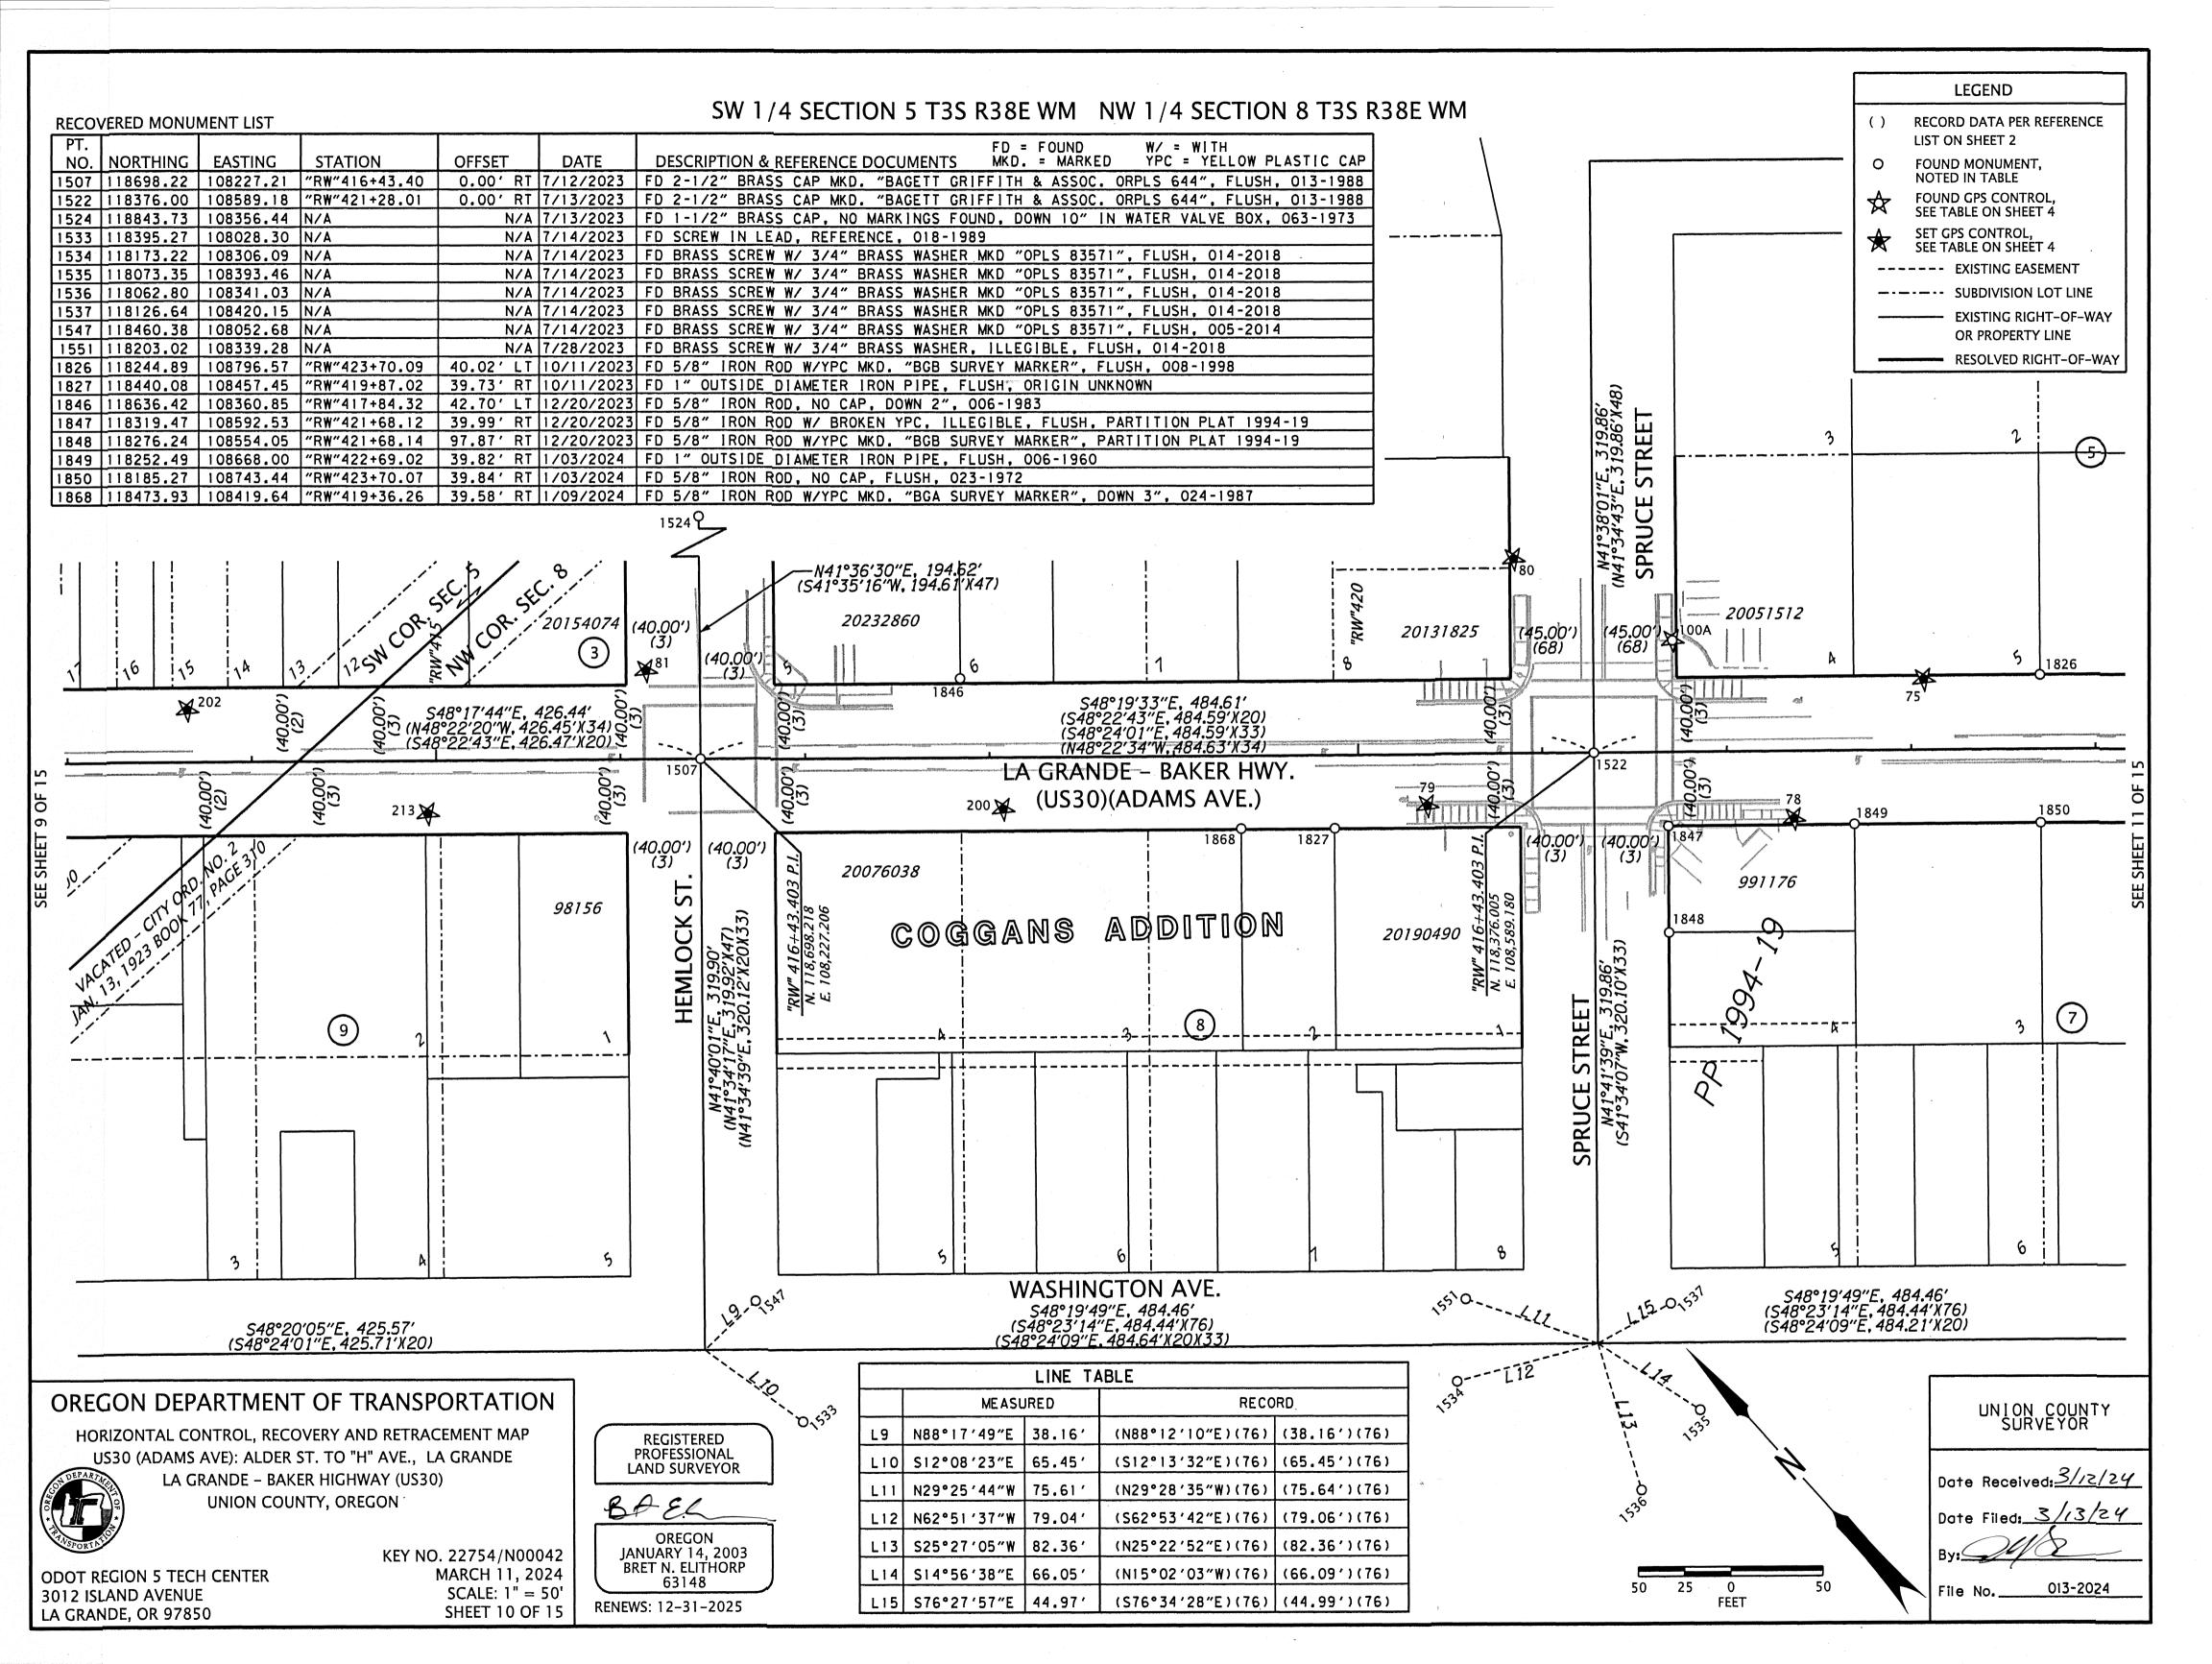

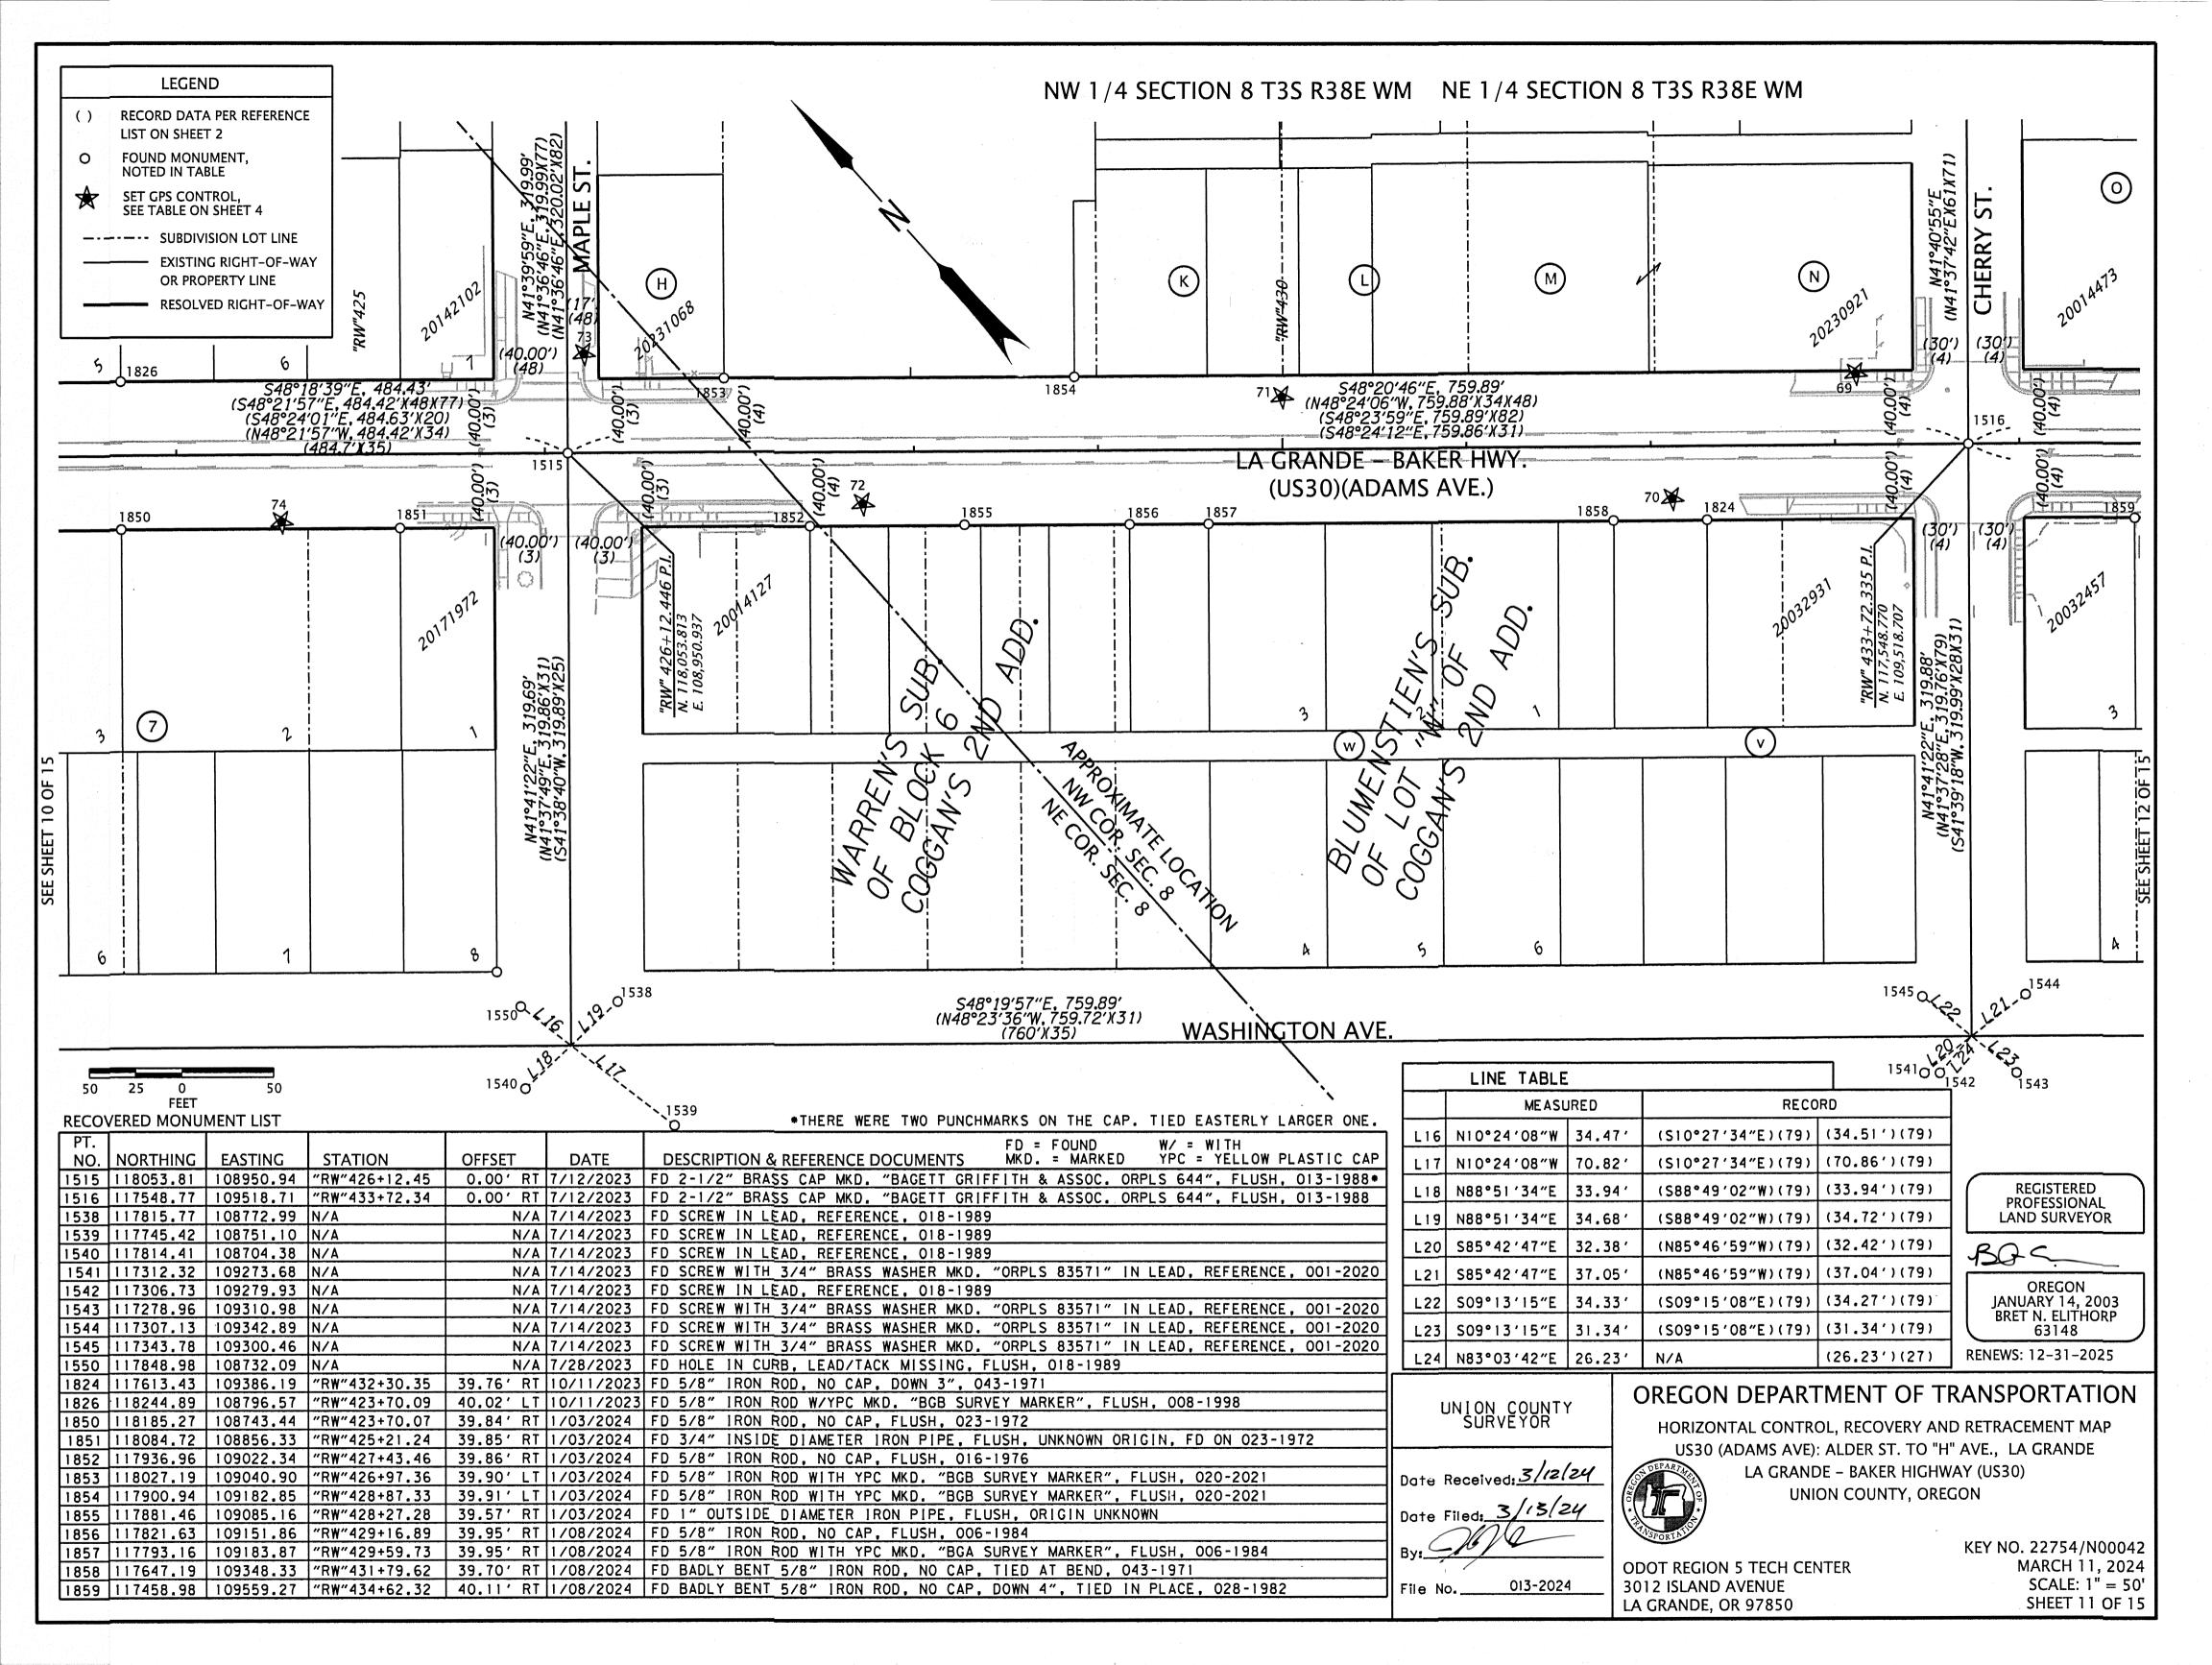

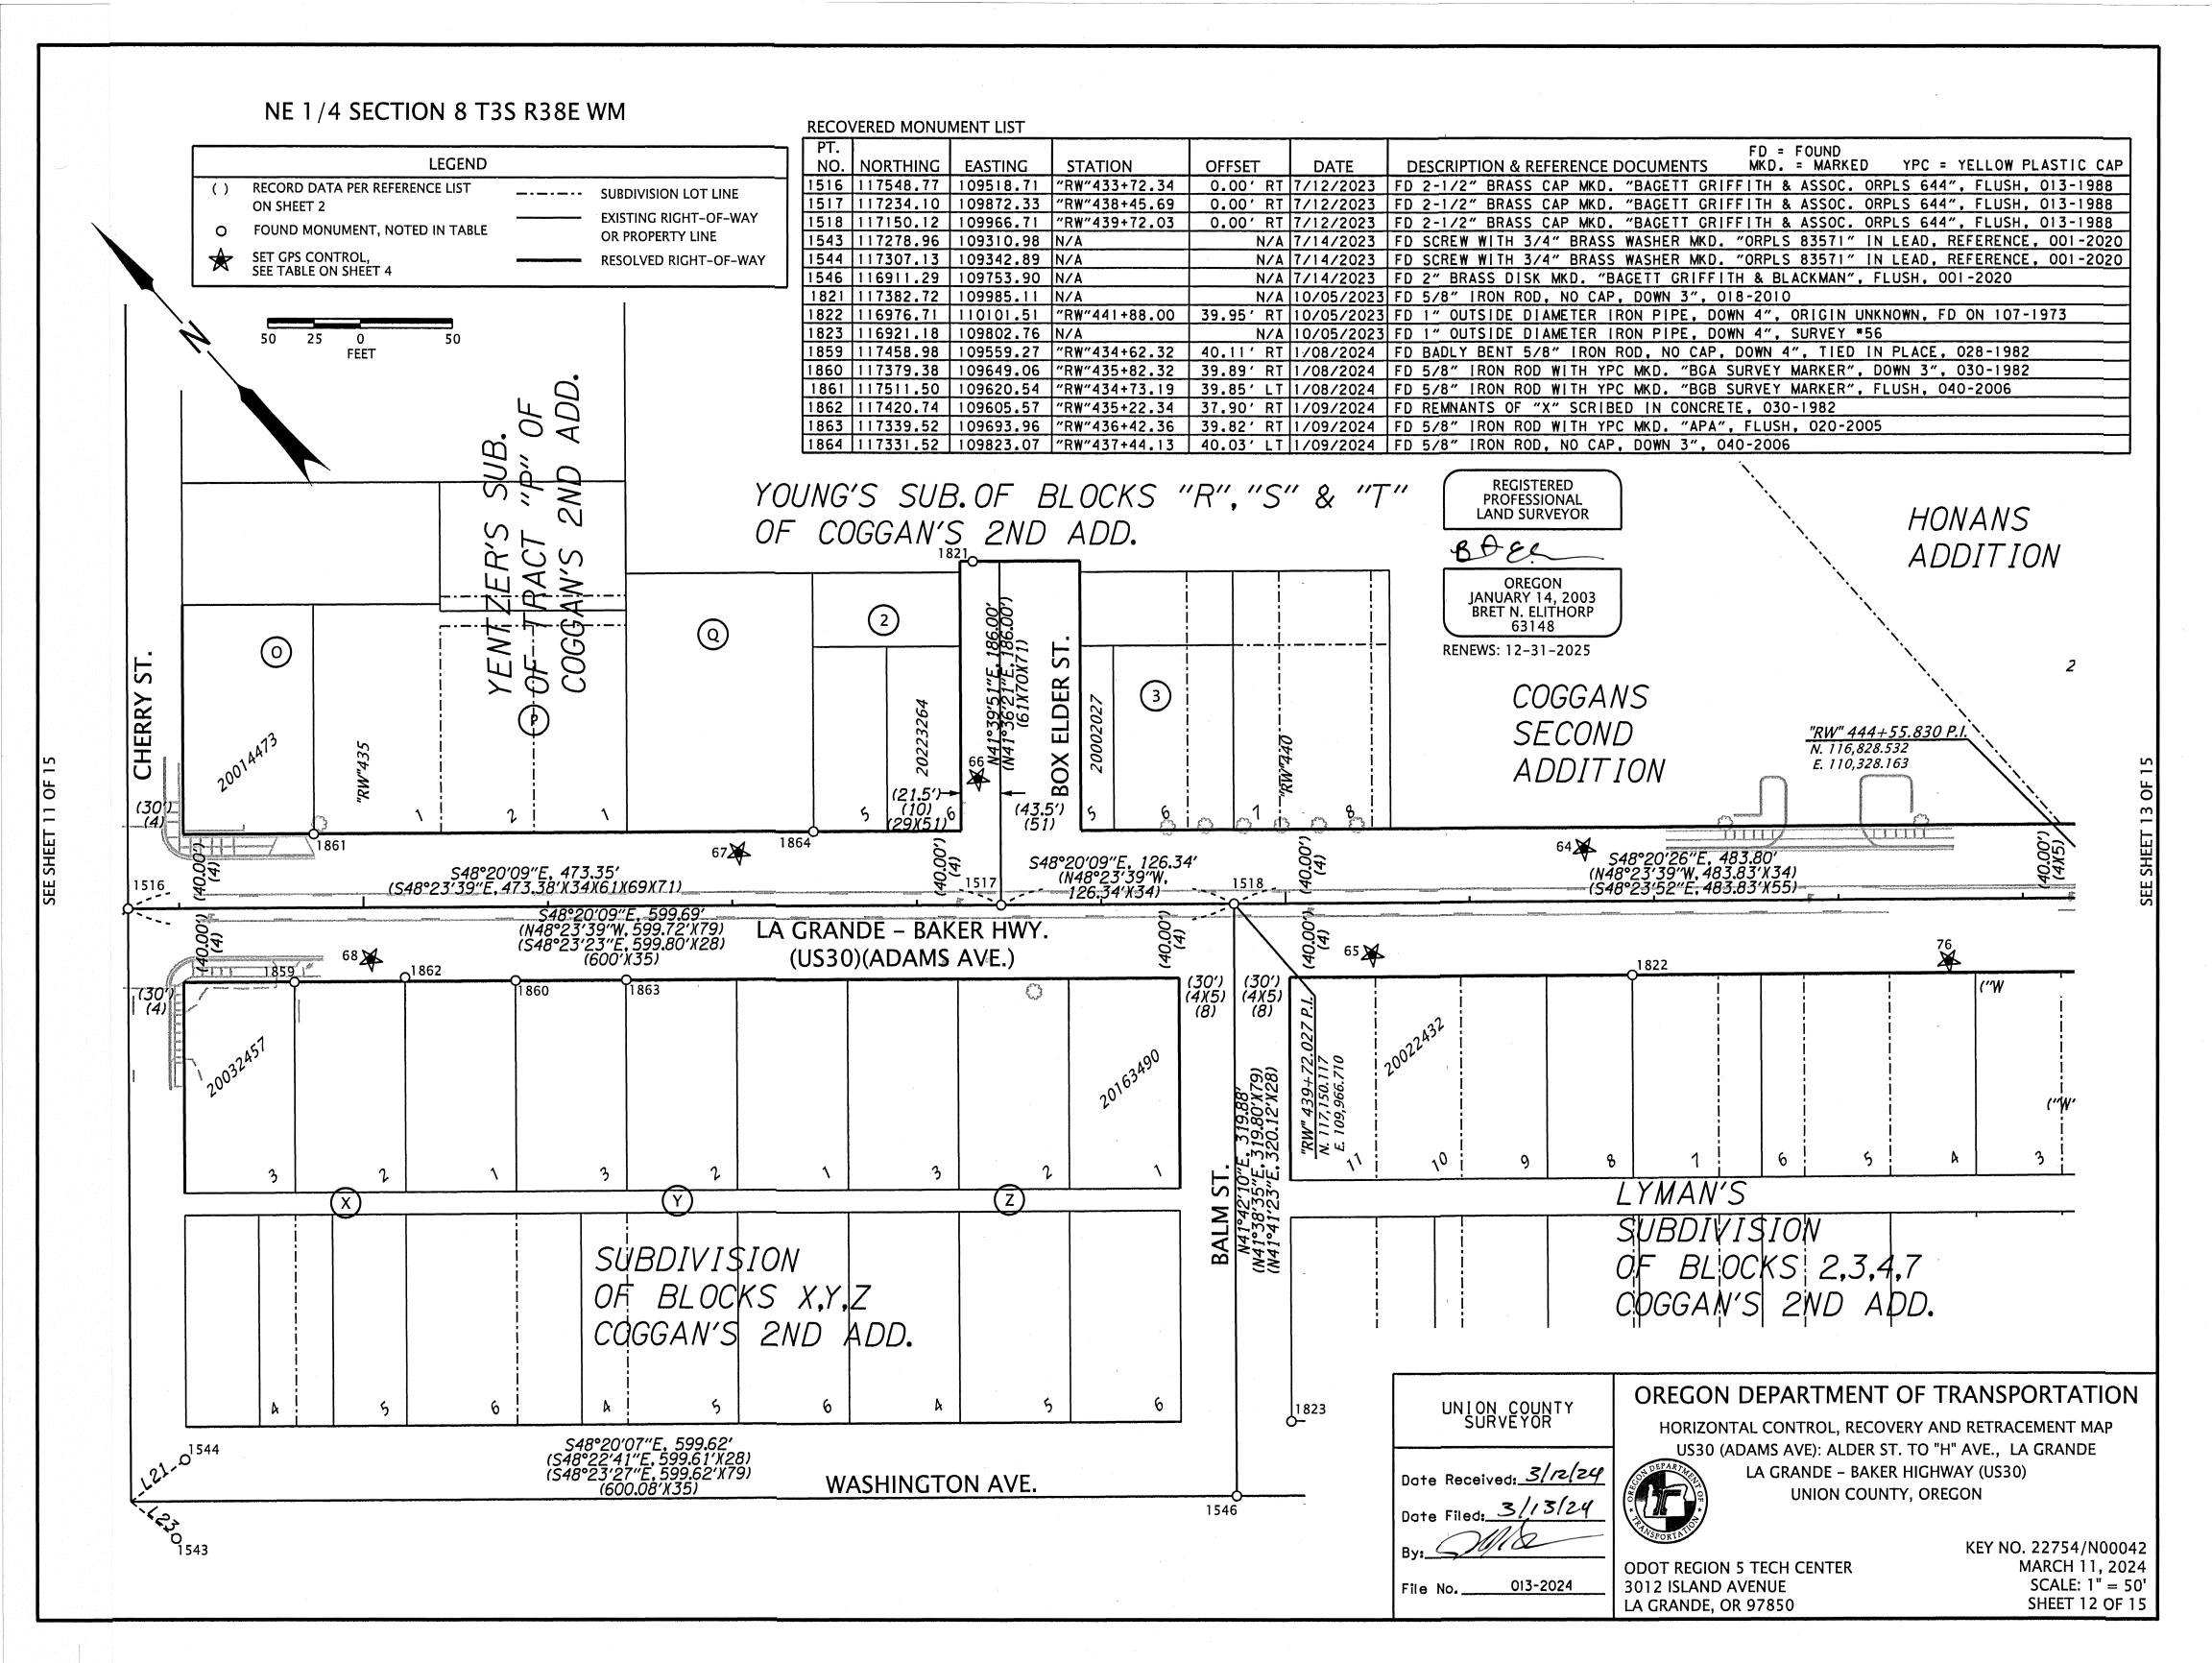

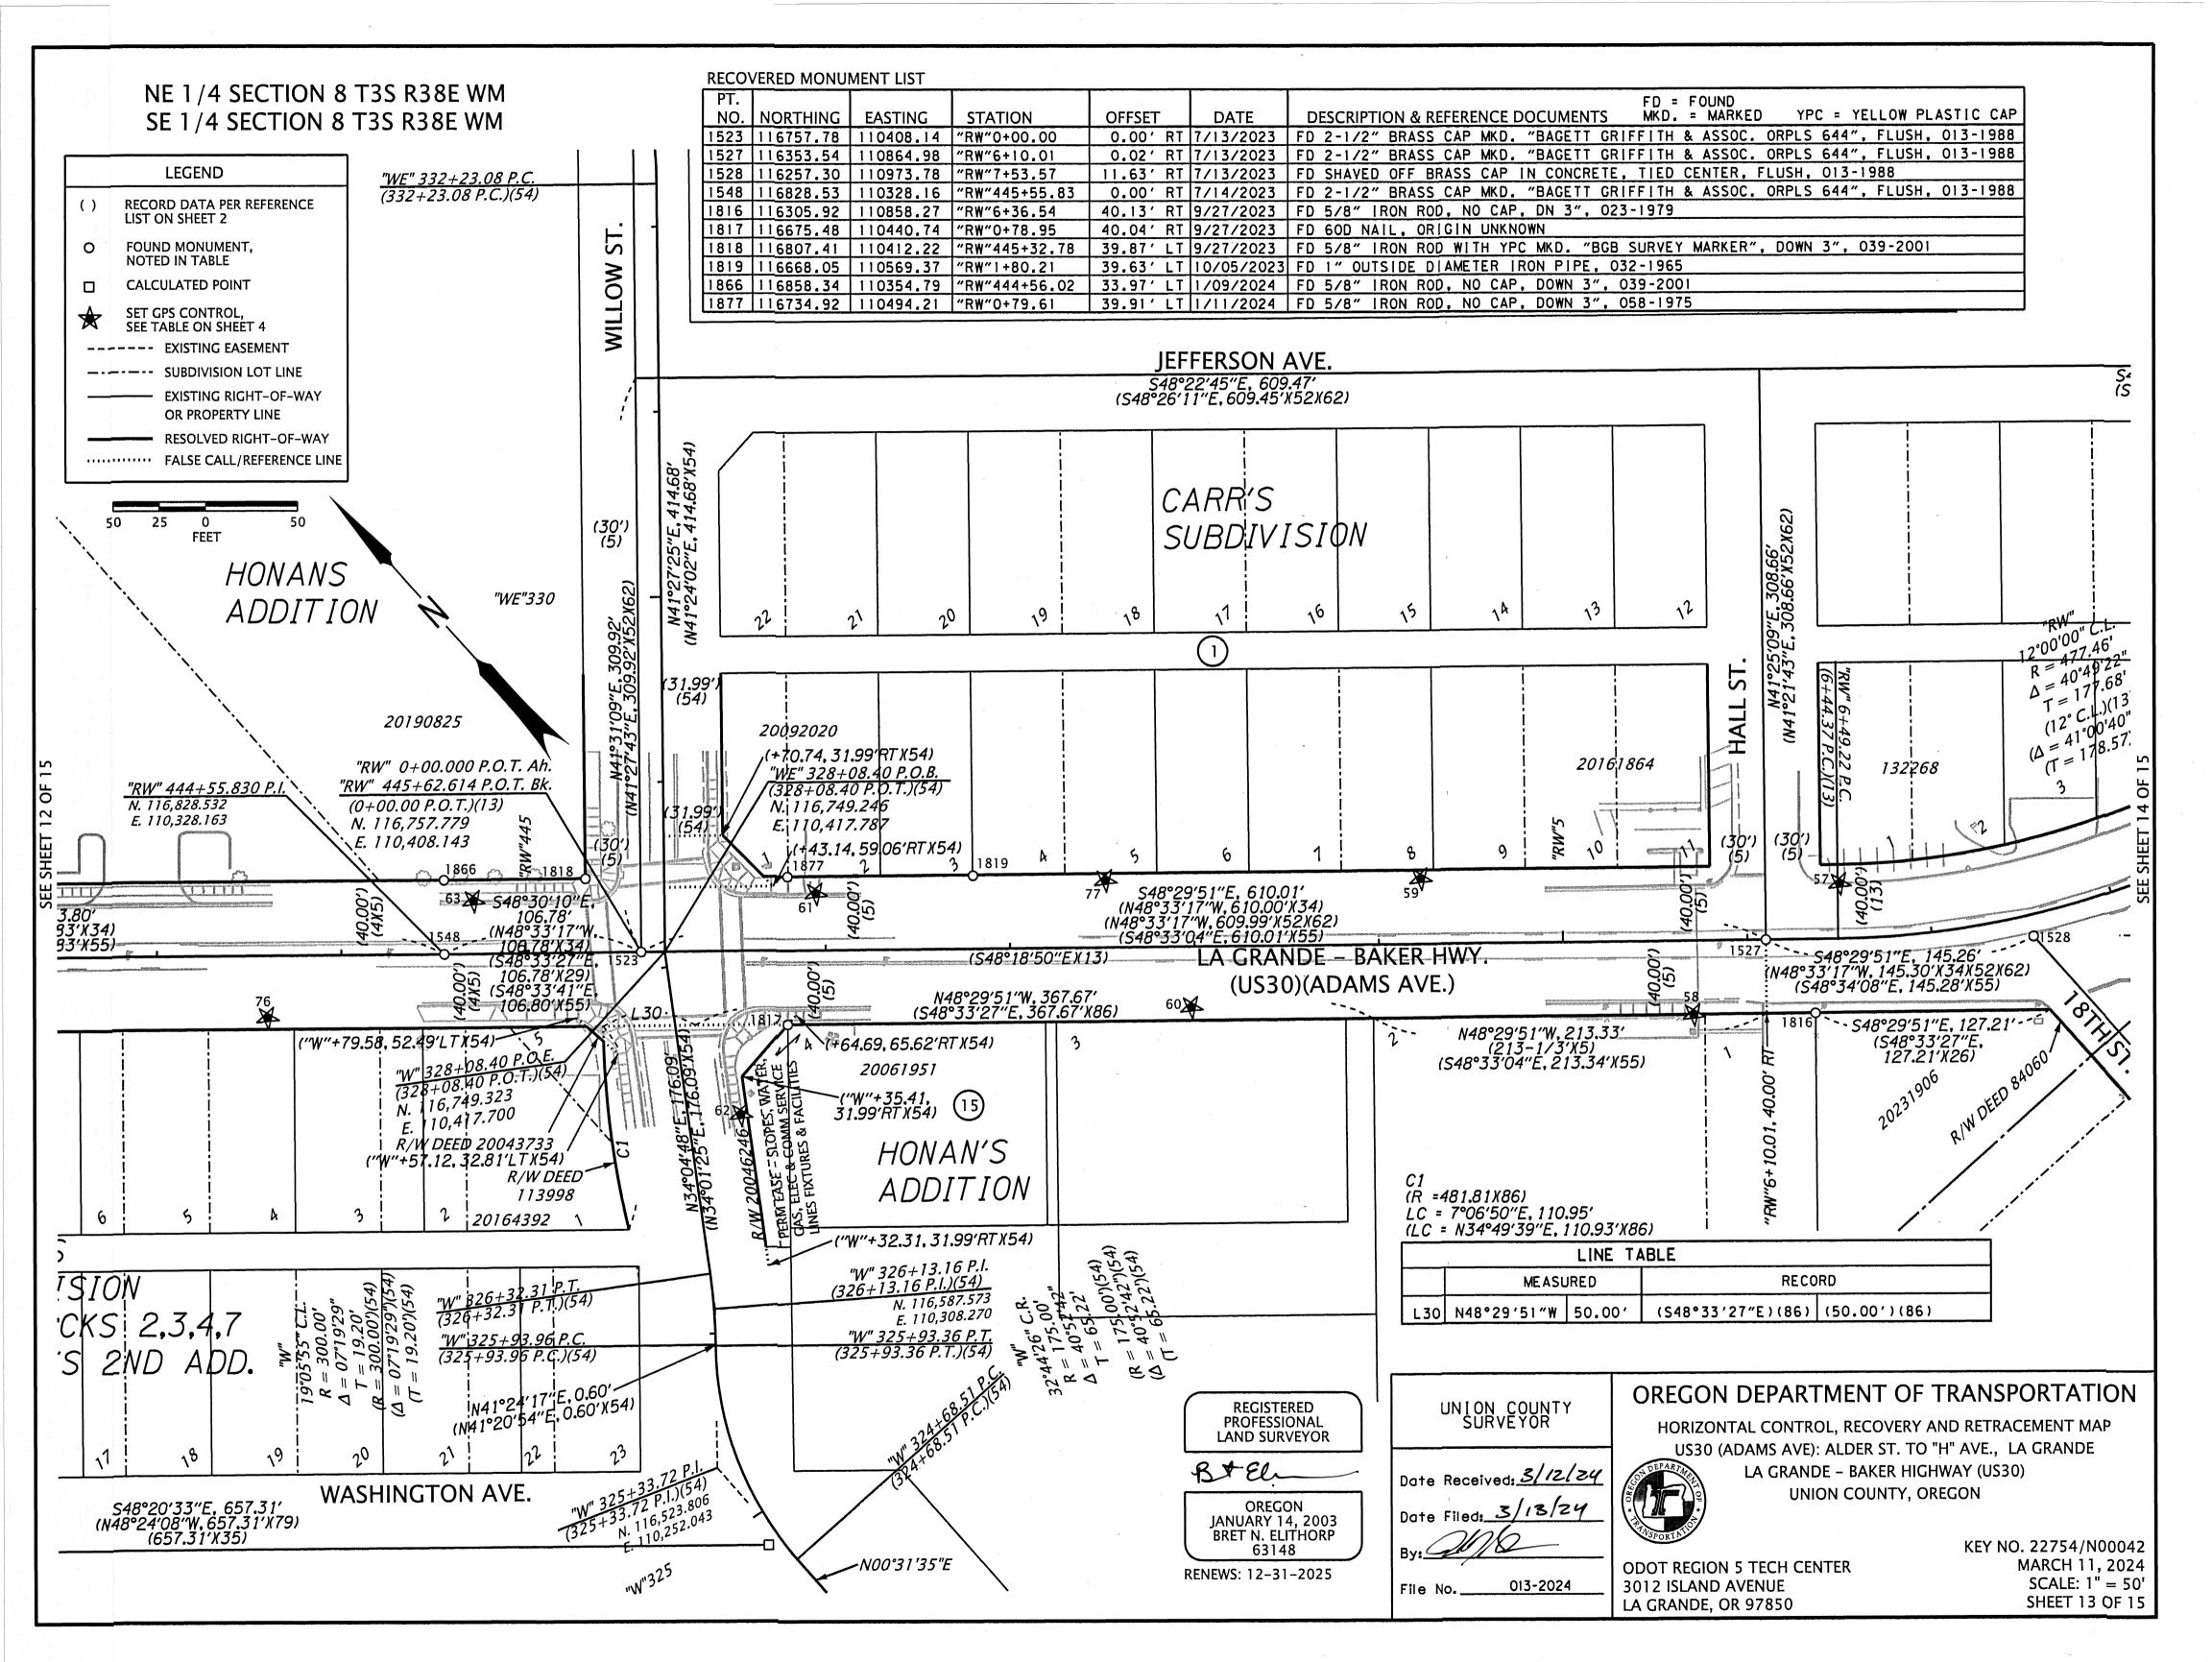


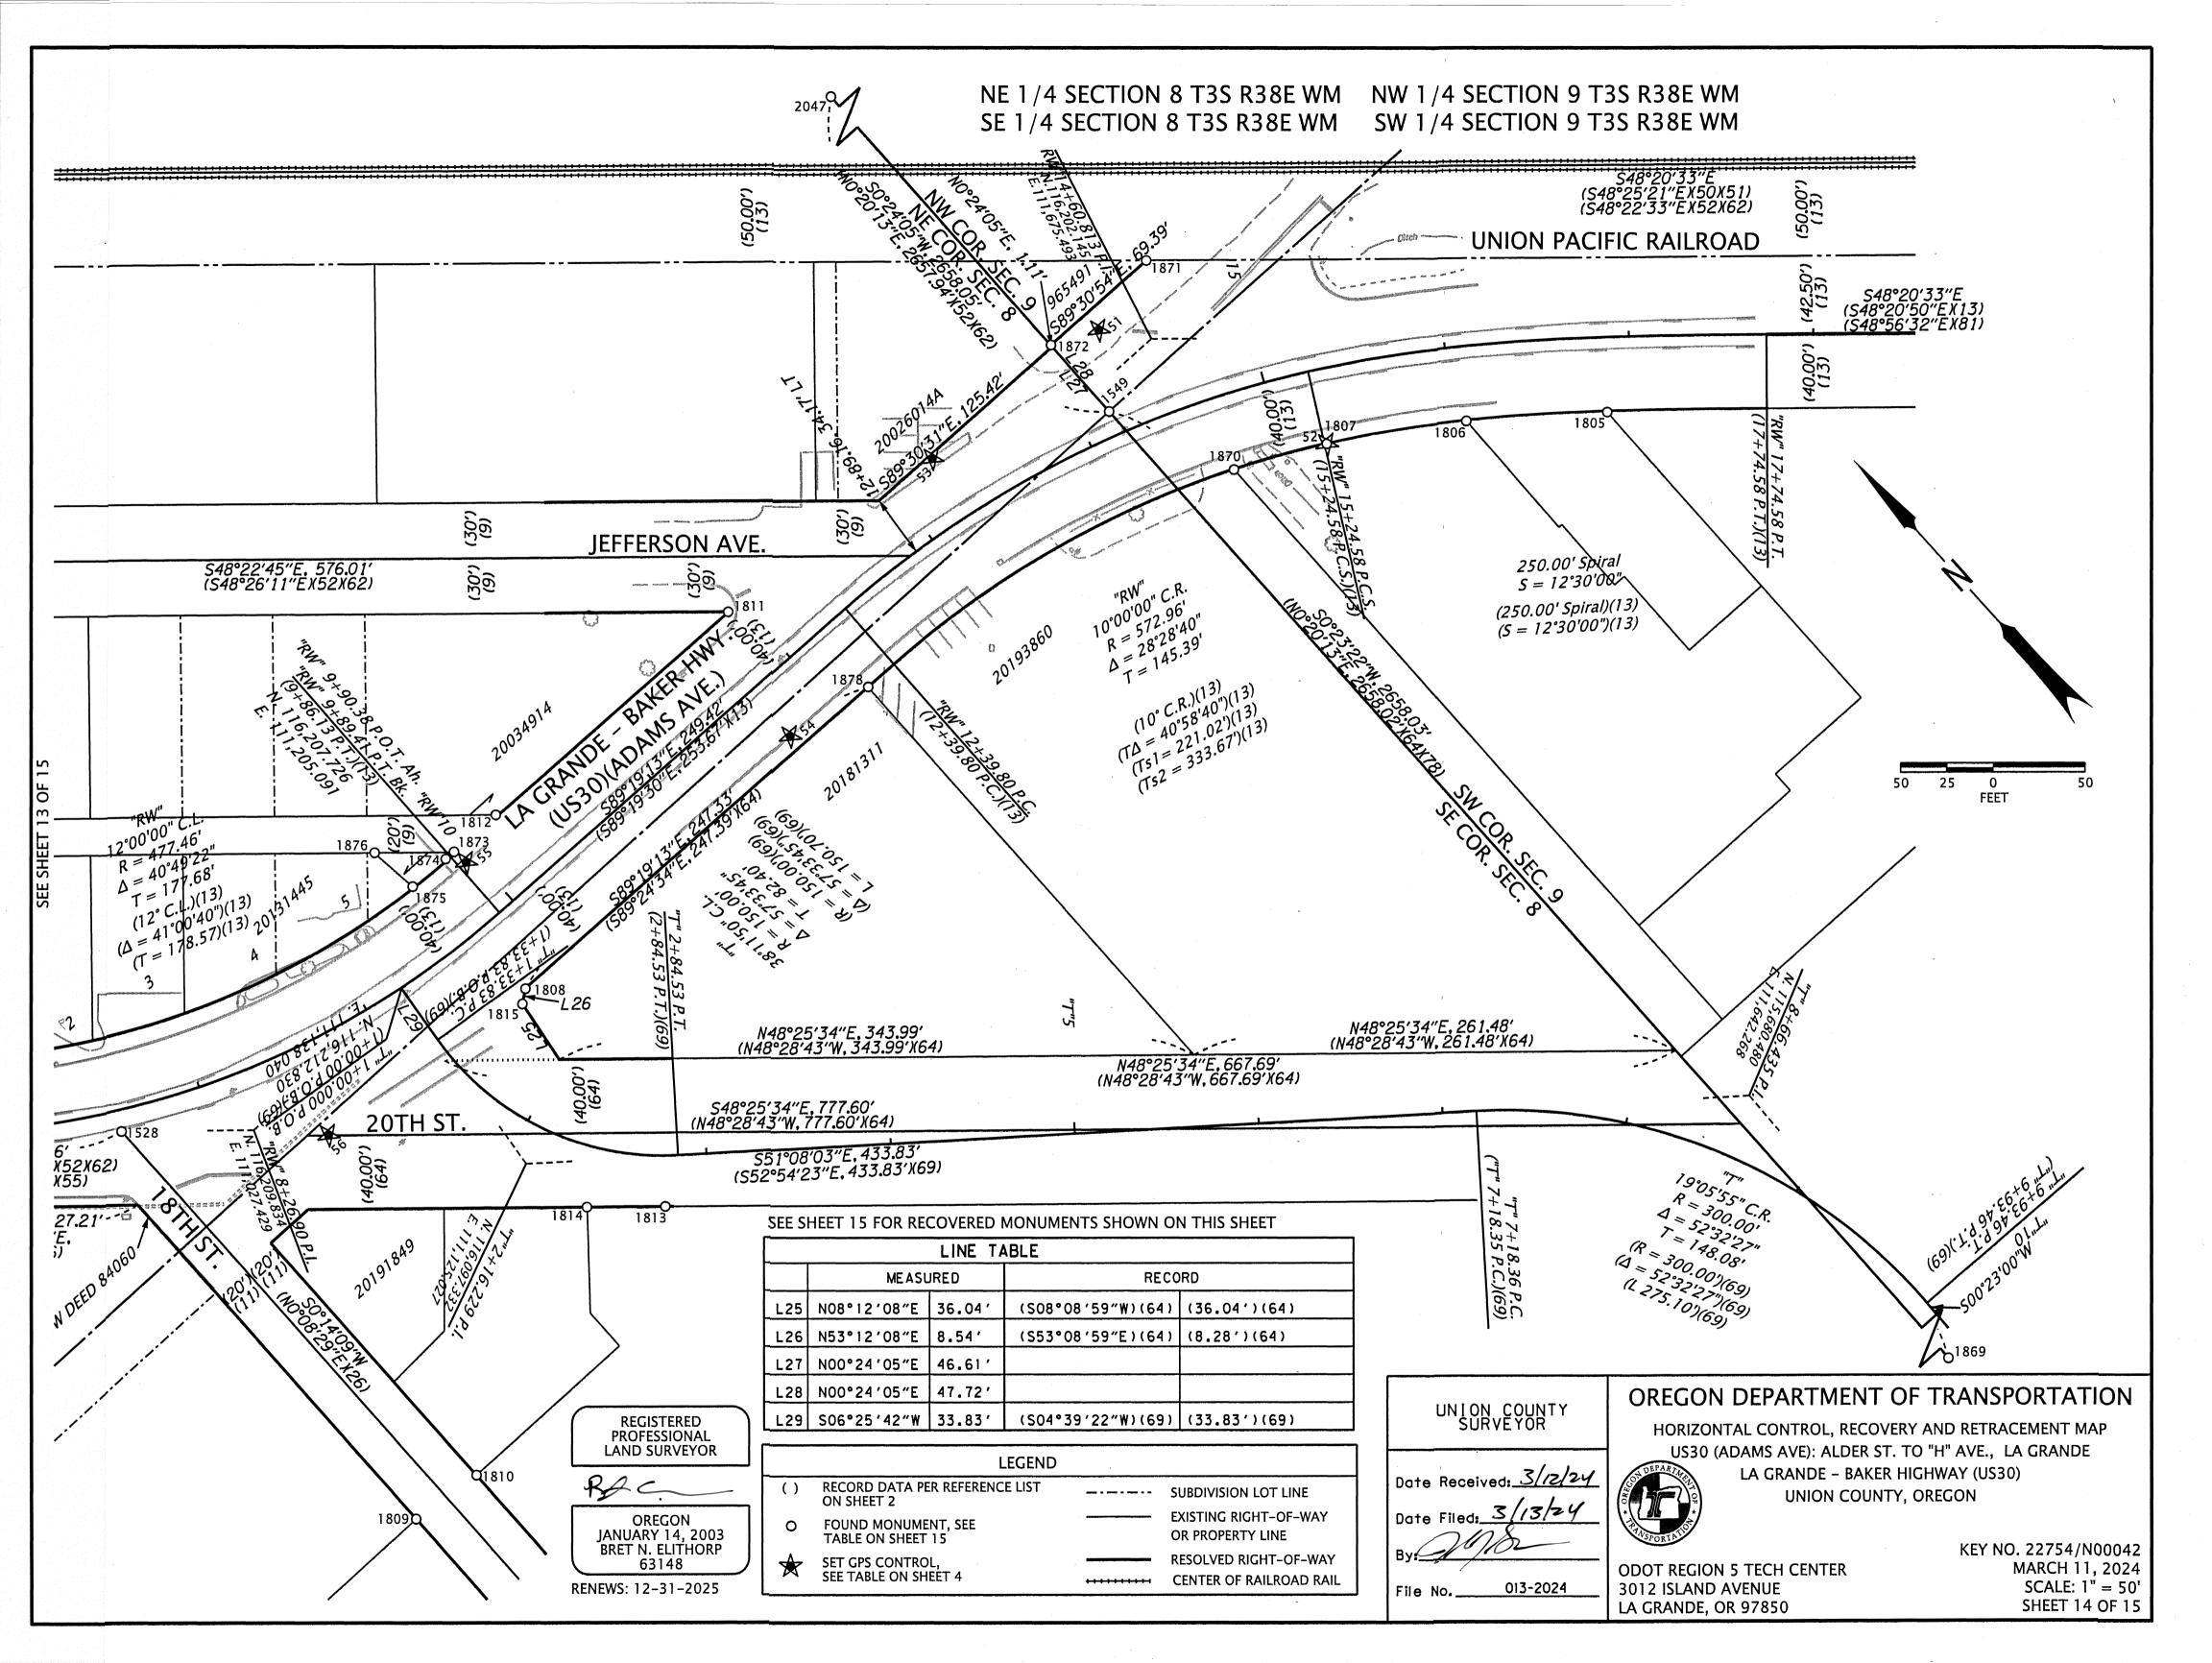

RECOVERED MONUMENT LIST

| RECOTERED MOROWERT EIST | | | | | | |
|-------------------------|-------------|-----------|--------------|-----------|-----------|---|
| PT. NO. | NORTHING | EASTING | STATION | OFFSET | DATE | FD = FOUND W/ = WITH DESCRIPTION & REFERENCE DOCUMENTS MKD. = MARKED YPC = YELLOW PLASTIC CAP |
| 1528 | 116257.30 | 110973.78 | "RW"7+53.57 | 11.63' RT | 7/13/2023 | FD SHAVED OFF BRASS CAP IN CONCRETE, TIED CENTER, FLUSH, 013-1988 |
| 1549 | 116188.39 | 111632.20 | "RW"14+16.41 | 13.36' LT | 7/28/2023 | FD 2-3/4" BRASS CAP MKD.AS SHOWN, IN MONUMENT BOX, 28-85R |
| 1805 | 116006.97 | 111832.65 | "RW"16+86.96 | 40.60' RT | 9/26/2023 | FD 5/8" IRON ROD W/YPC, ILLEGIBLE, FLUSH, 007-2019 |
| 1806 | 116054.51 | 111772.72 | "RW"16+07.58 | 40.45' RT | 9/26/2023 | FD 5/8" IRON ROD W/YPC, ILLEGIBLE, FLUSH, 007-2019 |
| 1807 | 116096.44 | 111708.28 | "RW"15+25.88 | 40.28' RT | 9/26/2023 | FD 5/8" IRON ROD W/YPC, ILLEGIBLE, FLUSH, 007-2019 |
| 1808 | 116167.75 | 111187.93 | "RW"9+74.02 | 40.44' RT | 9/26/2023 | FD 5/8" IRON ROD, NO CAP, FLUSH, 043-2013 |
| 1809 | 115995.33 | 110952.70 | N/A | N/A | 9/26/2023 | FD 5/8" IRON ROD W/YPC MKD. "BGA SURVEY MARKER", 019-1981 |
| 1810 | 115990.87 | 110992.79 | N/A | N/A | 9/26/2023 | FD 5/8" IRON ROD W/YPC MKD. "BGB SURVEY MARKER", FLUSH, PARTITION PLAT 1995-07 |
| 181 | 1 116245.58 | 111405.95 | "RW"11+90.78 | 40.23' LT | 9/27/2023 | FD 5/8" IRON ROD W/YPC MKD. "BGB SURVEY MARKER", UP 3", 026-2003 |
| 1812 | 116248.37 | 111238.96 | "RW"10+23.76 | 41.04' LT | 9/27/2023 | FD 5/8" IRON ROD W/YPC MKD. "BGB SURVEY MARKER", FLUSH, 026-2003 |
| 1813 | 116029.60 | 111165.59 | N/A | N/A | 9/27/2023 | FD "X" SCRIBED IN CONCRETE FENCE CURB, PARTITION PLAT 1995-07 |
| 1814 | 1116057.78 | 111133.75 | N/A | | | FD 5/8" IRON ROD W/YPC, FLUSH, BENT, TIED AT BEND, PARTITION PLAT 1995-07 |
| 1815 | 116162.73 | 111181.22 | "RW"9+68.11 | 45.79' RT | 9/27/2023 | FD 5/8" IRON ROD, NO CAP, DOWN 3", 043-2013 |
| 1869 | 113530.41 | 111614.13 | N/A | N/A | 1/09/2024 | FD 2-1/2" BRASS CAP MKD. AS SHOWN, DOWN 2" IN WATER VALVE BOX, 005-2009R |
| 1870 | 116119.76 | 111661.64 | "RW"14+69.77 | | | FD 5/8" IRON ROD W/YPC MKD. "BGA SURVEY MARKER", CAP BROKEN, DOWN 3", 004-1992 |
| 187 | 1 116235.52 | | "RW"14+61.23 | | | FD 5/8" IRON ROD W/YPC, CAP BROKEN, DOWN 2", 039-1982 |
| 1872 | 116236.10 | | "RW"14+03.26 | | | FD 5/8" IRON ROD W/YPC MKD. "APA", DOWN 6", 039-1982 |
| | 116248.76 | | "RW"9+93.52 | | | FD 5/8" IRON ROD, NO CAP, BENT, TIED AT BEND, TIED 9" DOWN, 026-2003 |
| | 1116248.90 | | "RW"9+86.42 | | | FD 5/8" IRON ROD W/YPC, MKD. "BGA SURVEY MARKER", DOWN 5", 026-2003 |
| | 116249.73 | | "RW"9+60.87 | | | FD 5/8" IRON ROD W/YPC, MKD. "BGA SURVEY MARKER", DOWN 4", 026-2003 |
| | 116277.16 | | "RW"9+54.92 | | | FD 5/8" IRON ROD, W/YPC, CAP BROKEN, DOWN 5", 026-2003 |
| | 116164.99 | | "RW"12+21.17 | | | FD 5/8" IRON ROD WITH YPC MKD. "BGA SURVEY MARKER", FLUSH, 005-1984 |
| +2047 | 118846.37 | 111650.81 | N/A | N/A | 9/23/2015 | FD 2-1/2" BRASS DISK MARKED AS SHOWN, FLUSH, 001-2002 |



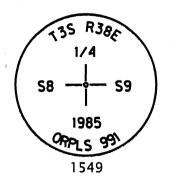





REGISTERED PROFESSIONAL LAND SURVEYOR

BPEL

OREGON JANUARY 14, 2003 BRET N. ELITHORP 63148

RENEWS: 12-31-2025

UNION COUNTY SURVEYOR

Date Received: 3/12/24

Date Filed: 5/13/24

File No. 013-2024

OREGON DEPARTMENT OF TRANSPORTATION

HORIZONTAL CONTROL, RECOVERY AND RETRACEMENT MAP
US30 (ADAMS AVE): ALDER ST. TO "H" AVE., LA GRANDE
LA GRANDE – BAKER HIGHWAY (US30)
UNION COUNTY, OREGON

ODOT REGION 5 TECH CENTER 3012 ISLAND AVENUE LA GRANDE, OR 97850 KEY NO. 22754/N00042 MARCH 11, 2024 SCALE: 1" = 50' SHEET 15 OF 15