
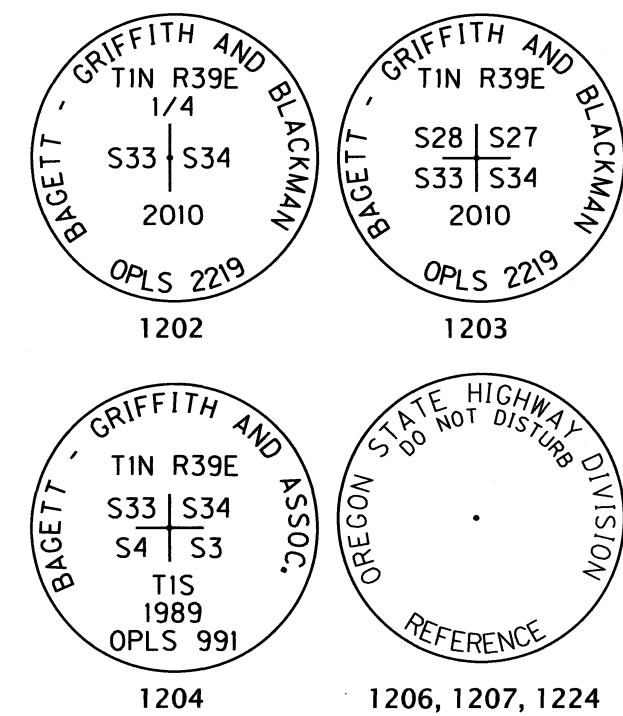


SW 1/4 SECTION 34 T1N R39E WM NW 1/4 SECTION 3 T1S R39E WM

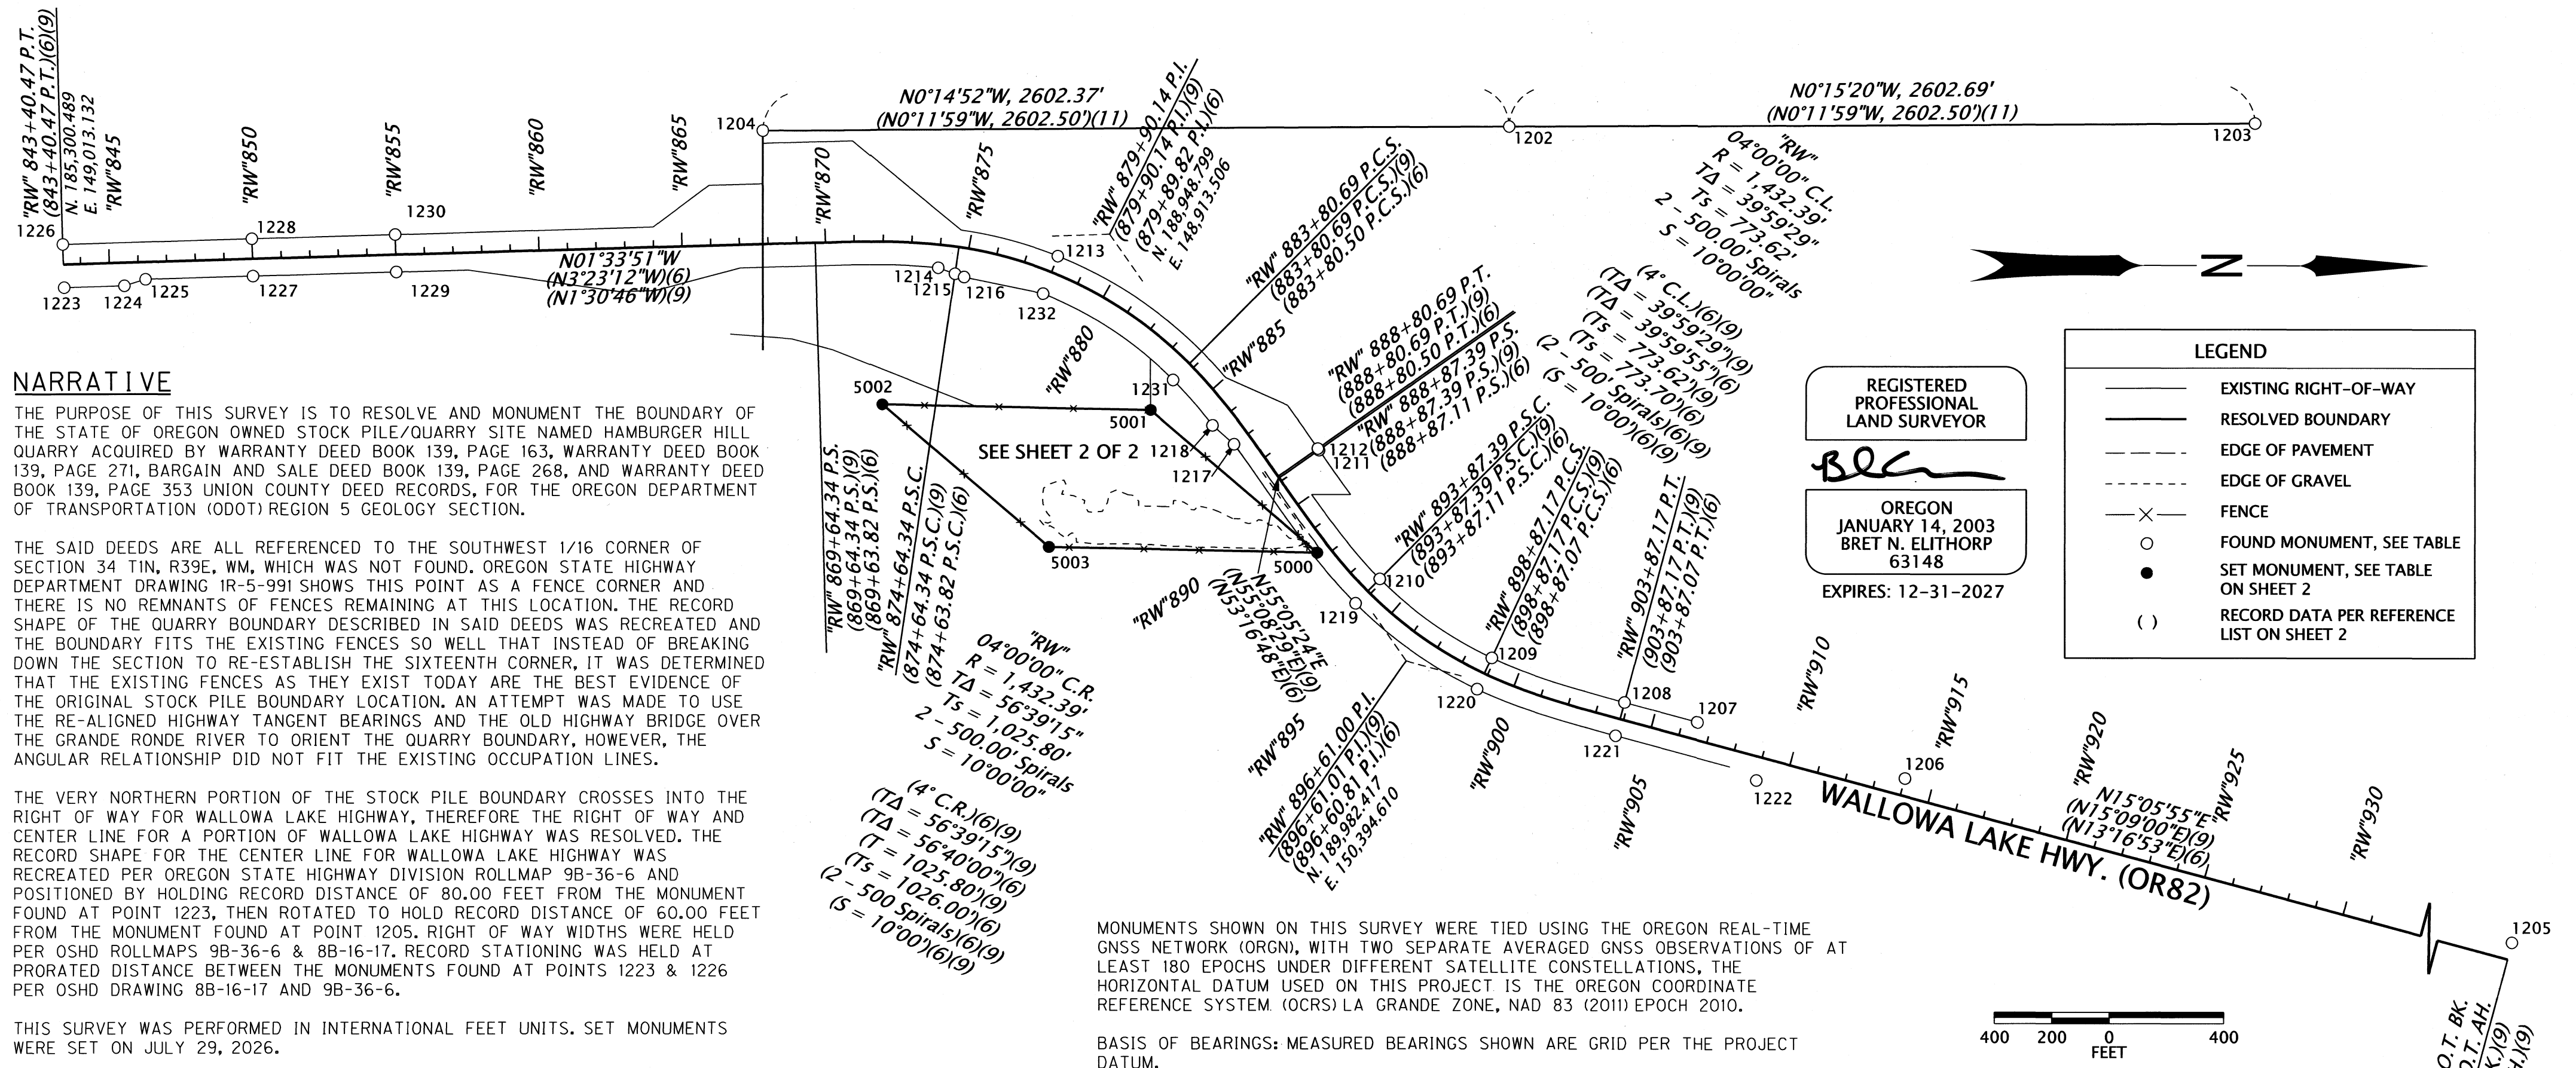

UNION COUNTY SURVEYOR

Date Received: 7/31/26

Date Filed: 7/31/26

By: [Signature]

File No. 031-2026


OREGON DEPARTMENT OF TRANSPORTATION

BOUNDARY SURVEY
 HAMBURGER HILL QUARRY
 WALLOWA LAKE HIGHWAY
 UNION COUNTY

ODOT REGION 5 TECH CENTER
 3012 ISLAND AVENUE
 LA GRANDE, OR 97850

JULY 30, 2026
 SCALE: 1" = 400'
 SHEET 1 OF 2

SW 1/4 SECTION 34 T1N R39E WM

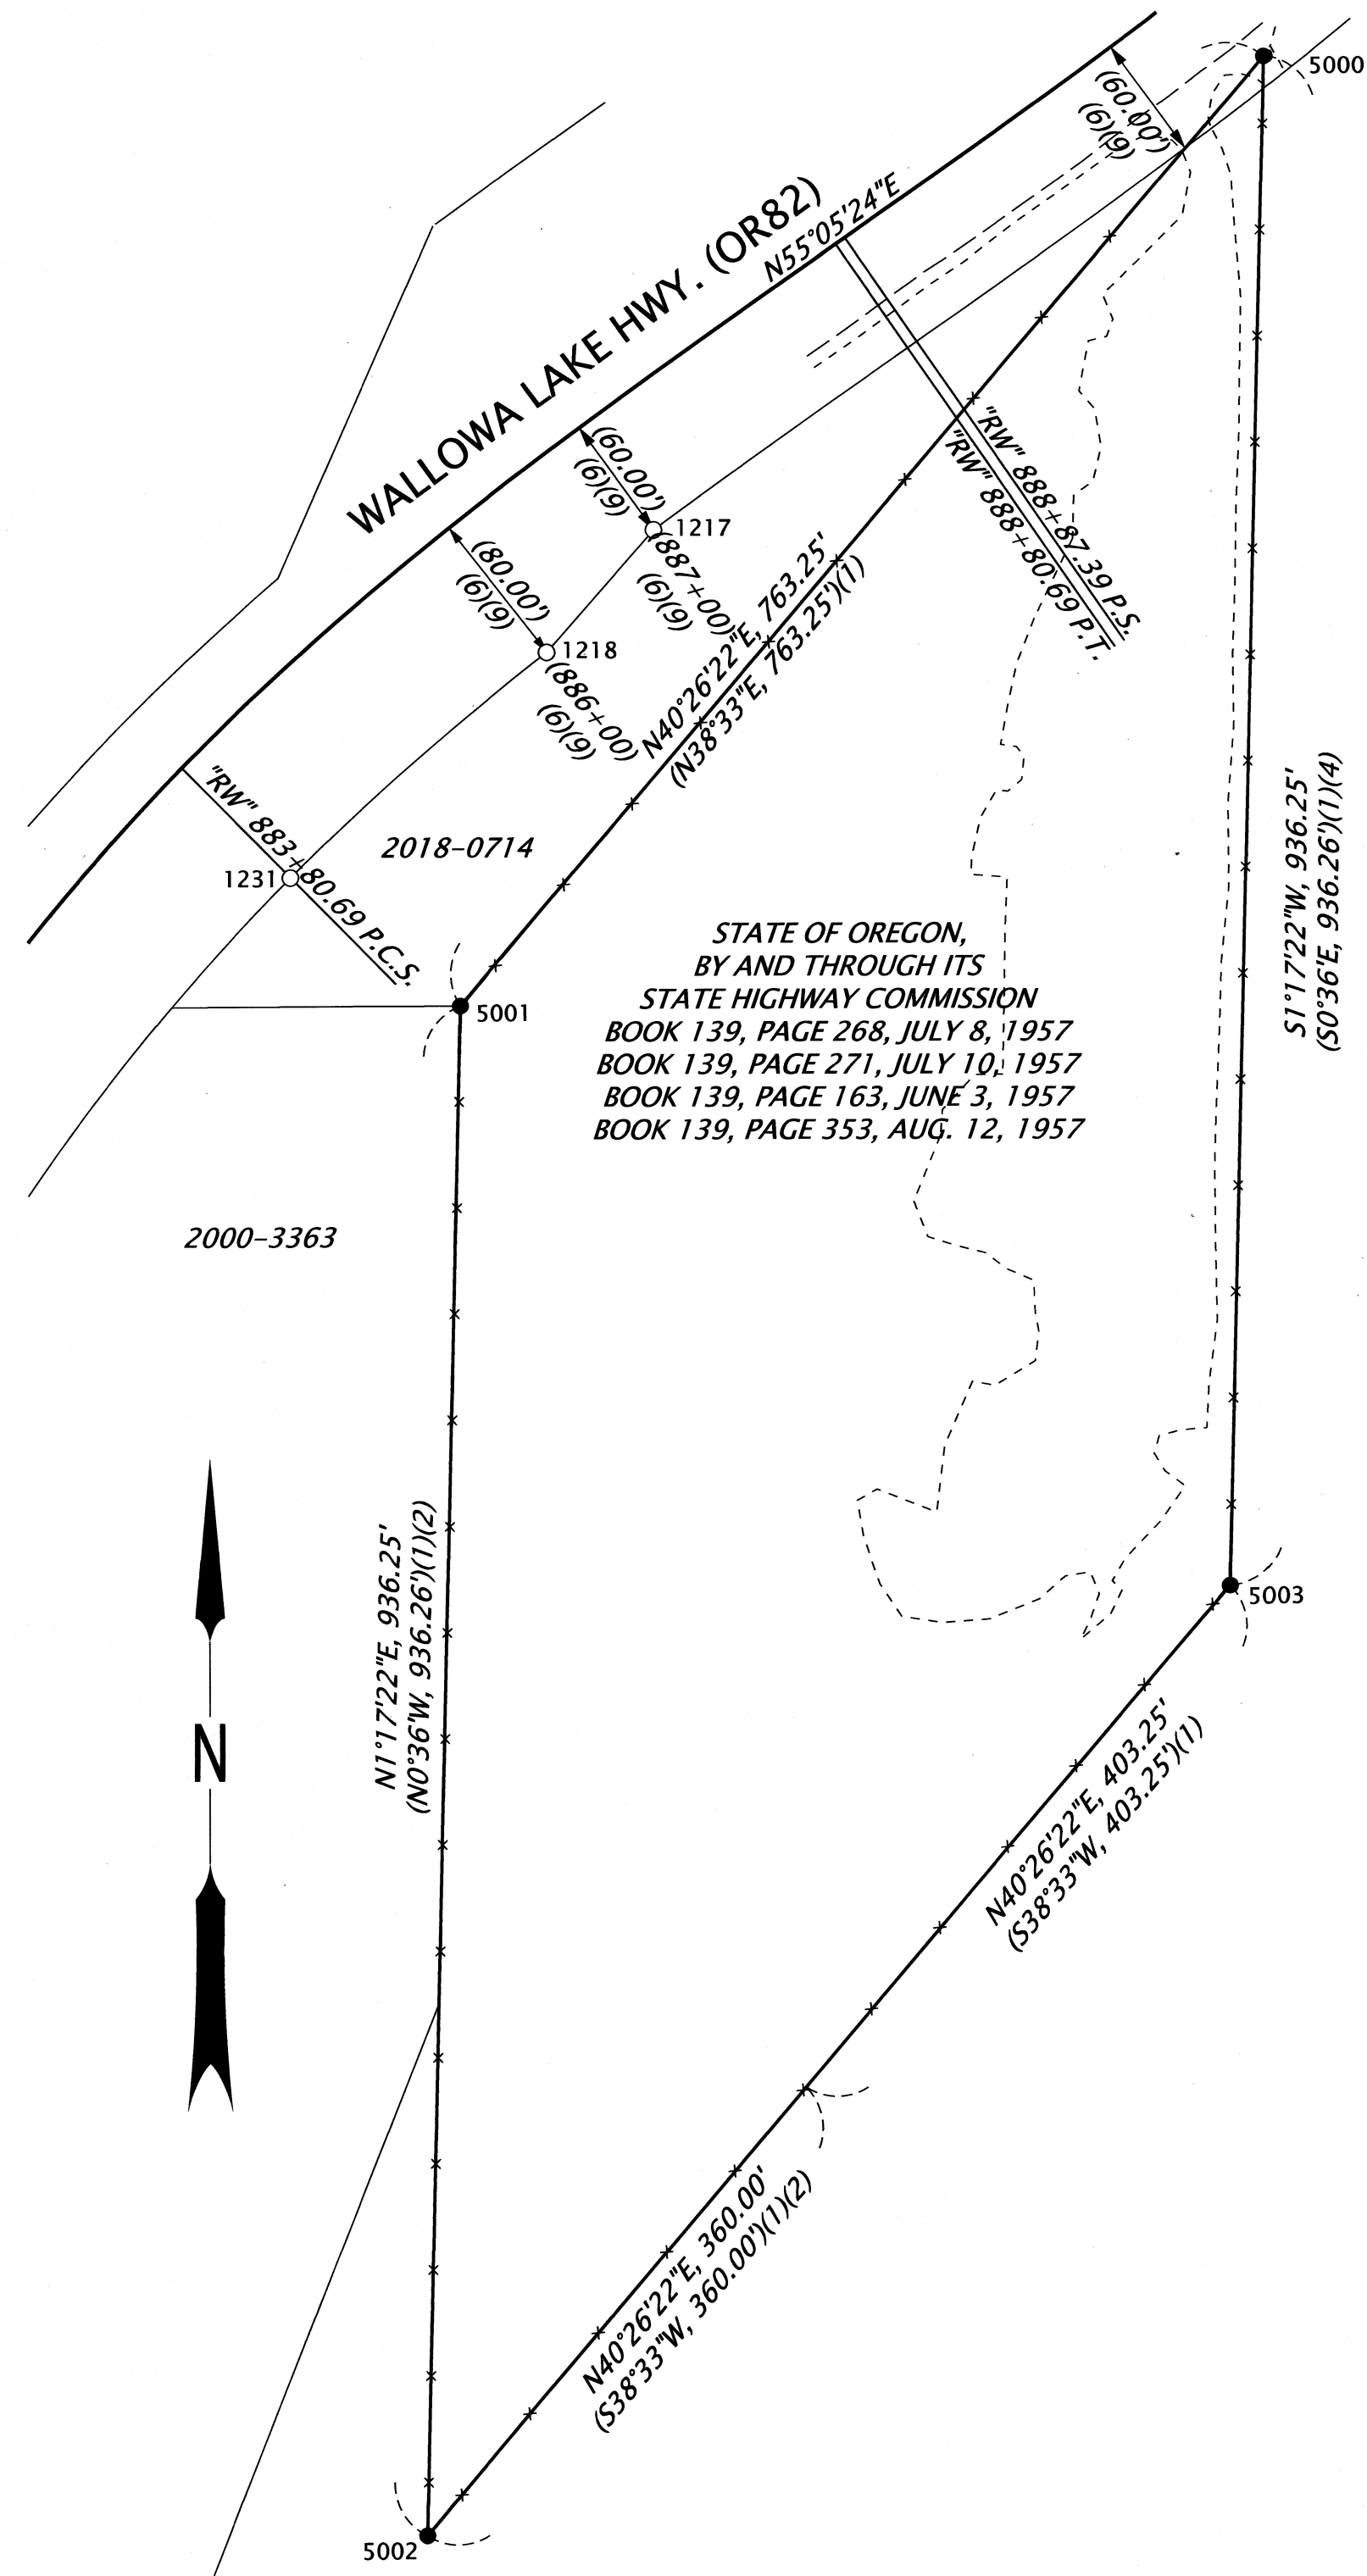

2018-0714

SET MONUMENT LIST

PT. NO.	NORTHING	EASTING	STATION	OFFSET	DATE	DESCRIPTION
5000	189672.57	150018.48	"RW" 891+72.81	44.32' RT	7/29/2026	SET 5/8"X30" IRON ROD W/YPC MARKED "ODOT RW"
5001	189091.67	149523.41	"RW" 884+02.32	209.12' RT	7/29/2026	SET 5/8"X30" IRON ROD W/YPC MARKED "ODOT RW"
5002	188155.65	149502.34	N/A	N/A	7/29/2026	SET 1-1/8" COPPER DISK MARKED "ODOT" IN CONC. FENCE FOOTING
5003	188736.56	149997.42	N/A	N/A	7/29/2026	SET 5/8"X30" IRON ROD W/YPC MARKED "ODOT RW"

LEGEND

—	EXISTING RIGHT-OF-WAY
—	RESOLVED BOUNDARY
- - -	EDGE OF PAVEMENT
- - -	EDGE OF GRAVEL
— X —	FENCE
○	FOUND MONUMENT, SEE TABLE ON SHEET 1
●	SET MONUMENT, SEE TABLE
()	RECORD DATA PER REFERENCE LIST ON THIS SHEET

REFERENCES

- O.S.H.D. DRAWING 1R-5-991, DATED DEC. 1956
- WARRANTY DEED BOOK 139, PAGE 163, JUNE 3, 1957
- BARGAIN AND SALE DEED BOOK 139, PAGE 268, JULY 8, 1957
- WARRANTY DEED BOOK 139, PAGE 271, JULY 10, 1957
- WARRANTY DEED BOOK 139, PAGE 353, AUG. 12, 1957
- O.S.H.D. DRAWING 8B-16-17, DATED JAN. 1960
- O.S.H.D. CONSTRUCTION PLANS 07V-016, DATED DEC. 1960
- COUNTY SURVEY 31-1989 BY GREGORY T. BLACKMAN, FILED DEC. 27, 1989
- O.S.H.D. DRAWING 9B-36-6, DATED FEB. 1990
- COUNTY SURVEY 051-1992 BY DUANE BERG, DATED AUG. 1992
- COUNTY SURVEY 021-2010 BY RICK G. ROBINSON, FILED SEPT. 1, 2010
- PARTITION PLAT 2018004T BY JEFFREY S. HSU, FILED FEB. 22, 2018

100 50 0 100
FEET

REGISTERED
PROFESSIONAL
LAND SURVEYOR

BLC

OREGON
JANUARY 14, 2003
BRET N. ELITHORP
63148

EXPIRES: 12-31-2027

UNION COUNTY
SURVEYOR


Date Received: 7/31/26

Date Filed: 7/31/26

By: *[Signature]*

File No. 031-2026

OREGON DEPARTMENT OF TRANSPORTATION

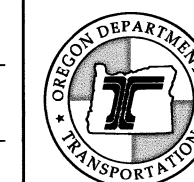

ODOT REGION 5 TECH CENTER
3012 ISLAND AVENUE
LA GRANDE, OR 97850

BOUNDARY SURVEY
HAMBURGER HILL QUARRY
WALLOWA LAKE HIGHWAY
UNION COUNTY

JULY 30, 2026
SCALE: 1" = 100'
SHEET 2 OF 2