


NE 1/4 SECTION 12 T1N R38E WM SE 1/4 SECTION 1 T1N R38E WM
NW 1/4 SECTION 7 T1N R39E WM SW 1/4 SECTION 7 T1N R39E WM
NW 1/4 SECTION 18 T1N R39E WM

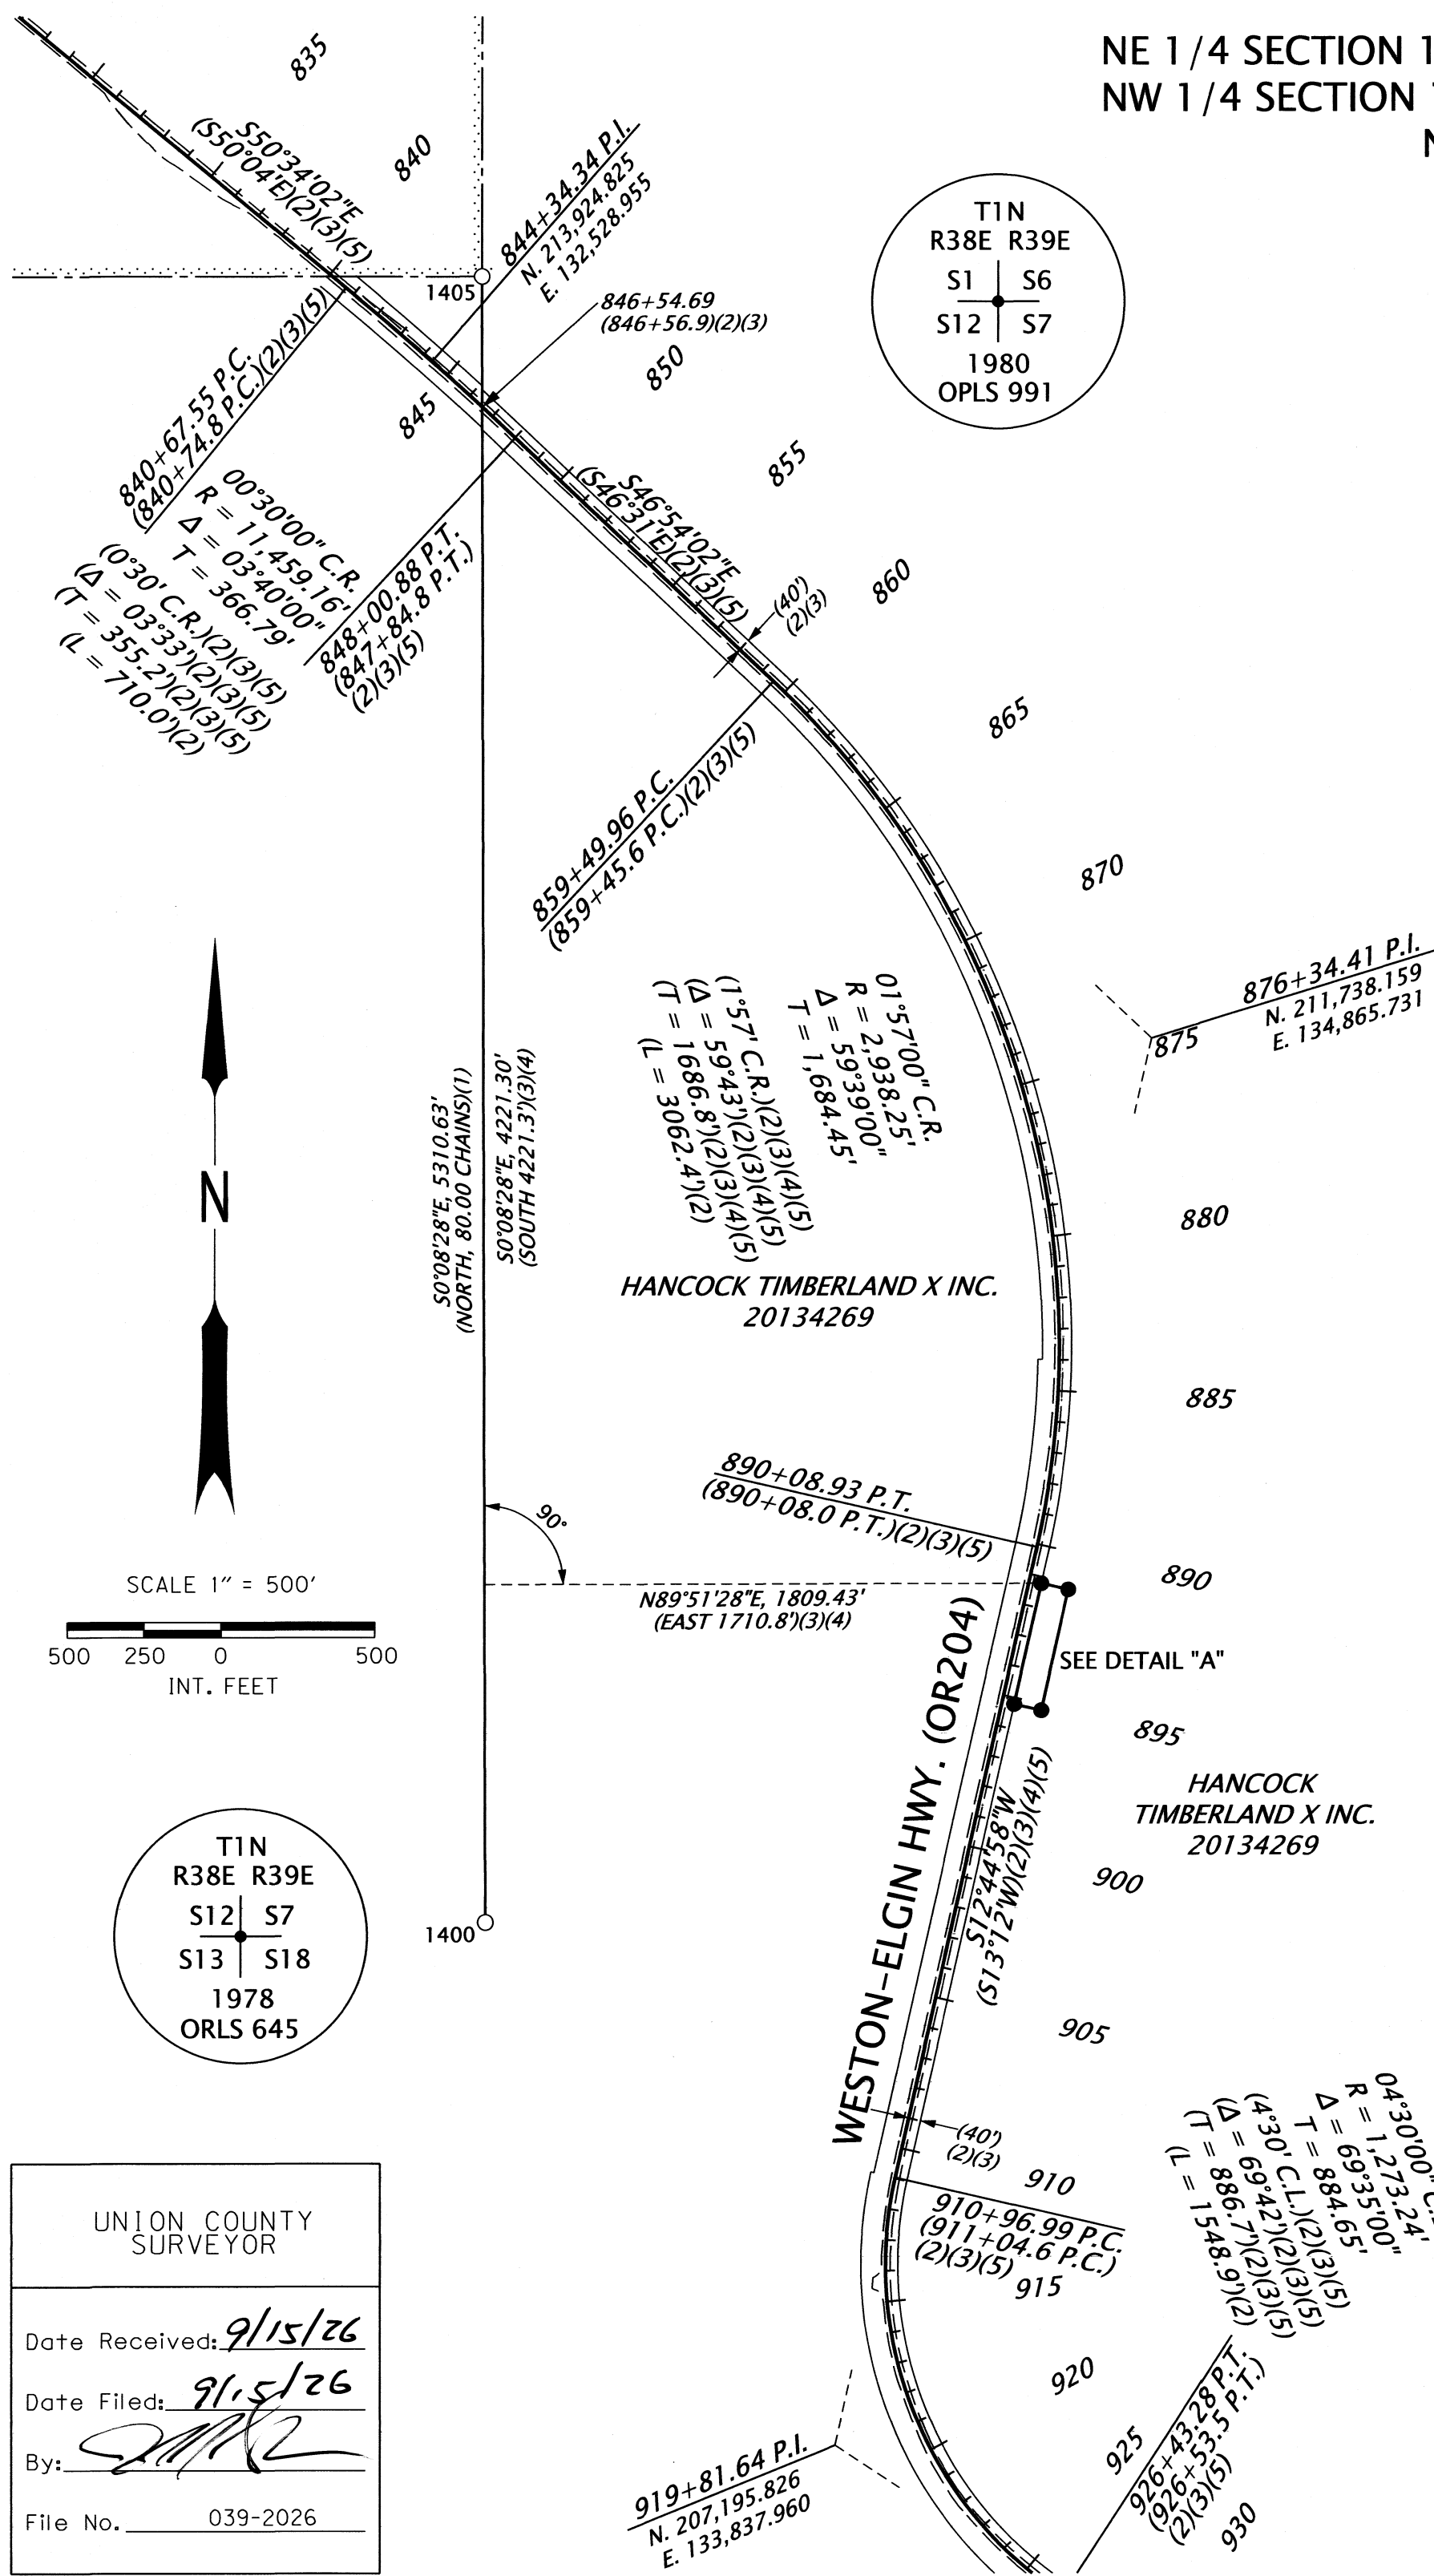

SET MONUMENT LIST

PT. NO.	NORTHING	EASTING	STATION	OFFSET	DESCRIPTION
5000	209977.00	134508.25	891+21.11	40.00' LT	SET 5/8\"X30\" IRON ROD W/1-1/2\" ALUMINUM CAP MARKED \"ODOT\"
5001	209957.14	134596.04	891+21.11	130.00' LT	SET 5/8\"X30\" IRON ROD W/1-1/2\" ALUMINUM CAP MARKED \"ODOT\"
5002	209567.00	134507.76	895+21.11	130.00' LT	SET 5/8\"X30\" IRON ROD W/1-1/2\" ALUMINUM CAP MARKED \"ODOT\"
5003	209586.86	134419.98	895+21.11	40.00' LT	SET 5/8\"X30\" IRON ROD W/1-1/2\" ALUMINUM CAP MARKED \"ODOT\"

REFERENCE LIST

- GLO FIELD NOTES, CONTRACT 102, BY TIMOTHY DAVENPORT, OCT. 16, 1863
- DEPT. OF AGRICULTURE, BUR. OF PUBLIC ROADS PROJECT #37-81, OSHD ROLLMAP 5B-15-18, DATED 1933
- OSHD DRAWING 1R-2-863, DATED JULY 1939
- WARRANTY DEED 83441, BOOK 100, PAGE 533, DATED NOV. 16, 1939
- OSHD DRAWING 5B-35-8, DATED APRIL 1950
- STATUTORY SPECIAL WARRANTY DEED 20134269, RECORDED DEC. 11, 2013

NARRATIVE

THE PURPOSE OF THIS SURVEY IS RESOLVE THE BOUNDARY FOR THAT STOCK PILE PROPERTY ALONG WESTON-ELGIN HIGHWAY (OR 204) ACQUIRED BY WARRANTY DEED BOOK 100, PAGE 533, UNION COUNTY DEED RECORDS. THIS SURVEY WAS PERFORMED IN INTERNATIONAL FEET UNITS. THIS SURVEY WAS PERFORMED IN AUGUST AND SEPTEMBER 2026. SURVEY EQUIPMENT USED INCLUDES A LEICA GS18 RECEIVER, LEICA CS20 DATA COLLECTORS, AND A LEICA TS16 TOTAL STATION. THE HORIZONTAL DATUM FOR THIS PROJECT IS NAD83 (2011) EPOCH 2010, OREGON COORDINATE REFERENCE SYSTEM, LA GRANDE ZONE. BEARINGS ARE GRID PER THE PROJECT DATUM. MONUMENTS WERE SET ON SEPTEMBER 8, 2026.

TO RESOLVE THE CENTER LINE FOR WESTON-ELGIN HIGHWAY, THE EDGE OF EXISTING PAVEMENT WAS HELD TO ESTABLISH THE TANGENTS, THEN RECORD DEGREE OF CURVE WAS HELD TO ESTABLISH THE CURVES. RECORD STATION OF 715+38.30 P.C. (OUTSIDE THE LIMITS SHOWN ON THIS SURVEY) WAS HELD PER US DEPARTMENT OF AGRICULTURE, BUREAU OF PUBLIC ROADS PROJECT 37-81 FOUND IN OREGON DEPARTMENT OF TRANSPORTATION RECORDS AS ROLLMAP 5B-15-18. MEASURED TANGENT DISTANCES WERE SIGNIFICANTLY SHORTER THAN RECORD TANGENT DISTANCES AND SOME OF THE DELTAS OF THE CURVES WERE SIGNIFICANTLY DIFFERENT SO STATIONING DOES NOT MATCH RECORD BY QUITE A BIT. THEREFORE, TO PLACE THE BOUNDARY OF SAID STATE OF OREGON STOCK PILE SITE I HELD RECORD DISTANCE OF 4221.3 FEET SOUTH ALONG THE WESTERLY LINE OF SAID SECTION 7 FROM THE NORTHWEST CORNER OF SECTION 7 (POINT 1405), THEN HELD 90° FROM SAID SECTION LINE EASTERLY TO THE EASTERLY RIGHT OF WAY LINE FOR WESTON-ELGIN HIGHWAY AS SHOWN ON OREGON STATE HIGHWAY DEPARTMENT DRAWING 1R-2-863.

RECOVERED MONUMENT LIST

PT. NO.	NORTHING	EASTING	DATE	DESCRIPTION & REFERENCE DOCUMENTS
1400	208883.19	132701.54	8/27/2026	FD 2-1/2\" BRASS CAP ON PIPE, UP 1.0', MARKED AS SHOWN, MON. RECORD 88-84R
1405	214193.80	132688.35	8/31/2026	FD 2-1/2\" BRASS CAP ON PIPE, UP 1.0', MARKED AS SHOWN, MON. RECORD 90-84R

LEGEND

- () RECORD DATA PER REFERENCE LIST
- FOUND MONUMENT NOTED IN TABLE
- SET MONUMENT NOTED IN TABLE
- RESOLVED BOUNDARY
- EXISTING RIGHT OF WAY OR PROPERTY LINE
- ... FOREST BOUNDARY
- EDGE OF PAVEMENT

REGISTERED
PROFESSIONAL
LAND SURVEYOR

Bret N. Elithorp
OREGON
JANUARY 14, 2003
BRET N. ELITHORP
63148

EXPIRES: 12-31-2027

OREGON DEPARTMENT OF TRANSPORTATION

BOUNDARY SURVEY
STOCK PILE SITE MP 36.66
WESTON-ELGIN HIGHWAY (OR 204)
UNION COUNTY



ODOT REGION 5 TECH CENTER
3012 ISLAND AVENUE
LA GRANDE, OR 97850

SEPTEMBER 14, 2026
SCALE: 1" = 500'
SHEET 1 OF 1

