Surveyed for Samuel Perry July the 23 1887

by J. W. Kimbrell Dep't. Co. Surveyor Plat No. 9

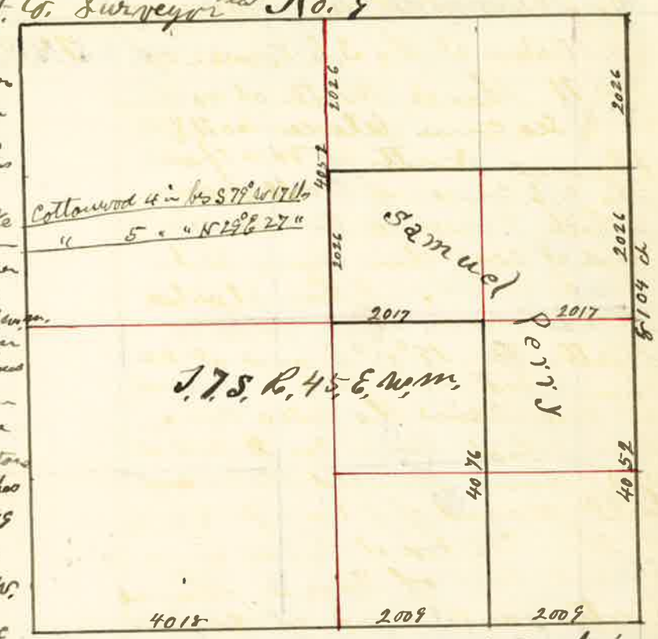

I started at the N.E. corner of Sec. 36 which is a Stone in a mound of stone. from this corner I run South at 20 chains set Stake for Temporary 1/4 corner at 40.52 chains set Stake for Temporary 1/4 sec corner and 80.04 chains the S.E. Corner Sec 36 which is also the S.W. Corner to T. 7 S. R. 45 & T. 8 S. R. 45 & 46 E. W. M. from which I run North on True line and at 40.52 chains Drove Stake for 1/4 sec corner and at 60.78 chains Planted a Stake and Built mound of Stone from which a Pine 34 inches Diameter Bears N 64° 45' W 75 links Distant a Pine 14 inches Diameter Bears S. 15° W. 67 links Distant

I then Started at the S.E. corner of Sec. 36 and run west var 19° 30' E and at 20 chains set Stake for 1/8 corner and at 40 chains set Stake for Temporary 1/4 Sec corner and at 80.36 chains the S.W. Corne of Sec 36 from which I run East on True line and at 40.18 chains marked Stone and Planted in Small creek or Irrigating Ditch in mound of Stone from which a Cottonwood or Balm 6 inches Bears S 68° 30' E 28 links Distant. and at 60.27 chains Planted Stake for 1/8 Corner. from which I run North and at 40.76 1/16 corne.

I then Started at 1/4 Sec corner on East Side of Sec 36 from which I run West at 20.14 chains the 1/16 corne Previously set and at 40.34 chains the center of Sec 36 by Alinement from 1/4 Sec. to 1/4 Sec. Corne through the center East & West and North & South as per Instructions from the Hon. Commissioner as the Corners was in Sight I did not think it Necessary to Chain the Whole Distance, from this corne or center I run North at 20 chains set Stake for Temporary 1/16 corne and at 40.52 chains the 1/4 Sec. corne on North Side of Sec 36. from which I run South on True line and at 20.26 Drove Stake and Built Mound of Rock for 1/16 corner.

J. W. Kimbrell Dep't Co Surveyor

Surveyed for Edwards Melhorn & Stewart July 24th 1887

by J. W. Kimbrell Dep't Co. Surveyor Plat No. 10

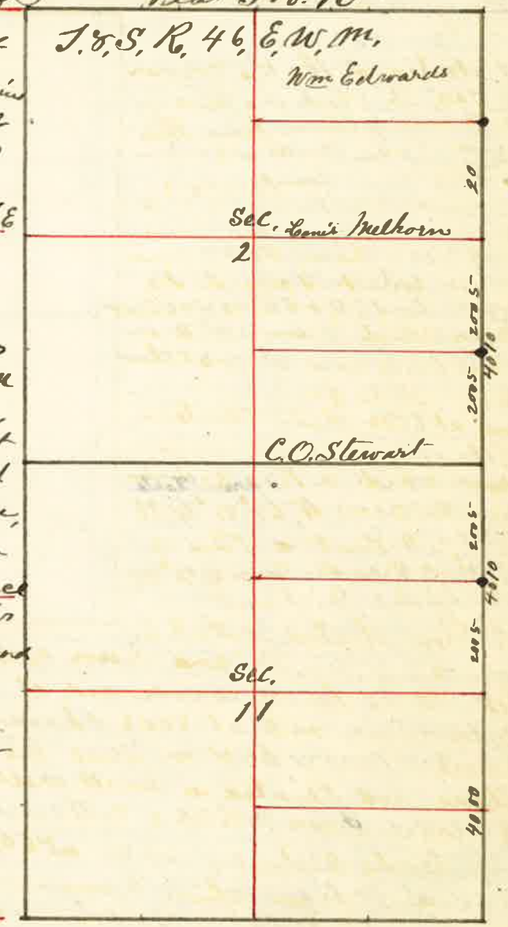

I Started at the S.E. Corner of Sec 11 Thence North at 40 chains the 1/4 Sec Corne between Sec 11 & 12 Thence North at 80.10 chains the N.E. Corne of Sec 11 from which I run South var 19° 45' E and at 20.05 chains Drove Stake for 1/4 corne, I then Started at S.E. Corner Sec. 2 Thence North var 19° 45' E and at 20 chains set Stake for 1/4 corne and at 40.10 Chains the 1/4 Sec corne, from which I run South and at 20.05 chains Planted Stake and built mound of Stone for 1/4 corne, I then Started at 1/4 Sec corne on East Side of Sec. 2 Thence North var 19° 45' E at 20 chains Drove Stake and Built mound of Stone for 1/4 corne,

J. W. Kimbrell Deputy County Surveyor

Surveyed for Ed Staples Aug the 4th 1887

by J. W. Kimbrell Dep't Co. Surveyor Plat No 11

I Started at N.W. Corner of Sec 6. from which I run South var 20° E at 20 chains set Stake for Temporary 1/4 corne at 40.52 chains the 1/4 Sec. corne on West side of Sec. 6. from which I run North on True line and at 20.26 chains Planted a Stone 6 X 6 X 12 inches from which a Pine Tree 12 inch Diameter Bears S 140 W 56 links distant a Pine Tree 14 inches Diameter Bears N 52° 30' E 74 links Dist.

J. W. Kimbrell Dep't Co Surveyor