

Field Notes of Subdivision - Sec 4-5-8-9 in T8S R46 E 20W

Surveyed for Joll Hewitt & James McMut - June 30 1885

The corner to Sec 4-5-8-9 thence South var 20° E

8011 chains the corner to 8-9-16817

The 1/4 corner on South side S.W. 1/4 Sec 4 thence North 1985 chains

the 1/4 corner on South side S.W. 1/4 Sec 4 thence North 1985 chains

the 1/4 corner on North side N.W. 1/4 Sec 9 thence I run South 2003 chains set

Post for center N.W. 1/4 Sec 9 from which a line 10 inch bears S 89° 26' 00" W

thence East - 6018 chains 1/8 corner on East side N.E. 1/4

the 1/4 Sec corner on East side Sec 9 thence North 4006 chains N.E. corner


sec 9 from which I run South 2003 chains set post for 1/4 corner from

which an asp 5 inch diameter bears N 58° 30' W 1/3 links distant

thence West 2006 chains set post for 1/4 corner from which

an asp 10 inches bears S 45° 10' 32" links distant

J.W. Kimbrell Capt Co. Surveyor

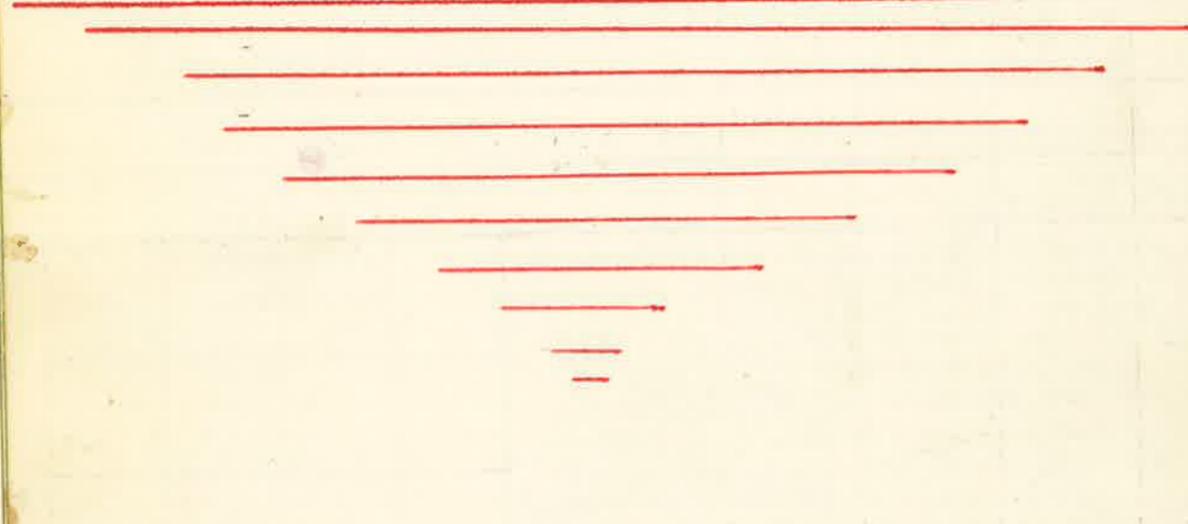

Surveyed for Robt Eakin & C.C. Coffin July the 9th 1885

By J.W. Kimbrell County Surveyor Plat 1 No. 39

I commenced at the 1/4 Sec corner between Sec 7 & 8 a stone marked
 thence South var 20° E 2000
 chains set post for temporary
 one 4018 corner to Sec 7-8-17816
 from which I run South 2009
 chains set stone marked for
 4018 chains 1/8 corner thence
 North 20 chain deposit for 1/4 corner
 4018 chain corner to Sec 5-6-7816
 a stone 8 x 8 x 2 1/2 inches 20 inch
 in ground from which I run
 South 2009 chains set stone marked
 for 1/4 corner 4018 chain 1/8 corner
 between Sec 7 & 8 thence East
 20 chains set stake for 1/4 corner
 40 " set stake for temporary
 center 8012 chains 1/4 Sec corner
 on East side Sec 8.
 The N.E. corner Sec 8 thence
 I run West between Sec 5
 & 8 40 chains set temporary
 stake for 1/4 Sec corner 8036
 chains the N.W. corner Sec 8
 from which I run East on line corner to
 4018 chains set stone 7 x 8 x 14 inch
 for 1/4 Sec corner between Sec 5 & 8.
 The S.E. corner Sec 8 thence I run
 East on random line between
 Sec 8 & 17 40 chains set stake for temporary
 1/4 Sec corner 8036 chains S.E. corner Sec 8
 from which I run West at 4018 chains
 set stone for 1/4 Sec corner from a stone
 set by Moses Austin to temporary
 set for Mrs. Diggins bears N 2° W
 32 links distant. thence North
 through center Sec 8 var 20° 15' E.
 3965 chains center Sec 8. 8075
 chains the 1/4 Sec corner on North side
 Sec 8 from which I run South 2014
 chains set stone in mound of stone
 for 1/4 corner. The 1/4 corner point
 on North side N.W. 1/4 Sec 8 thence I run
 South 2007 chains set stone for 1/4 corner 4020 set stake for 1/4 corner 6031 chain
 set stone for 1/4 corner the N.W. corner Sec 8 thence North 40 chains set stake
 for temporary 1/4 Sec corner 8090 chains intersect North boundary
 Sec 5 67 links East of line to Sec 5-6-31934 from which I run South
 on true line var 21° E. 4060 chains set stone 7 x 8 x 18 in the following corner
 between Sec 5 & 6 8090 chains corner to Sec 5-6-7816 thence West 2000
 set stake for temporary 1/4 corner 4024 chains 1/4 Sec corner on North side Sec
 7 from which I run East 2012 chains set stone marked 1/4 corner
 4024 chains N.E. corner Sec 7 248 to 4064 W 1/4

J.W. Kimbrell County Surveyor

