


74 Surveyed for John Smith Blockland & Schaffer Dec 26 1888
By J.W. Kimbrell County Surveyor Plat No. 65

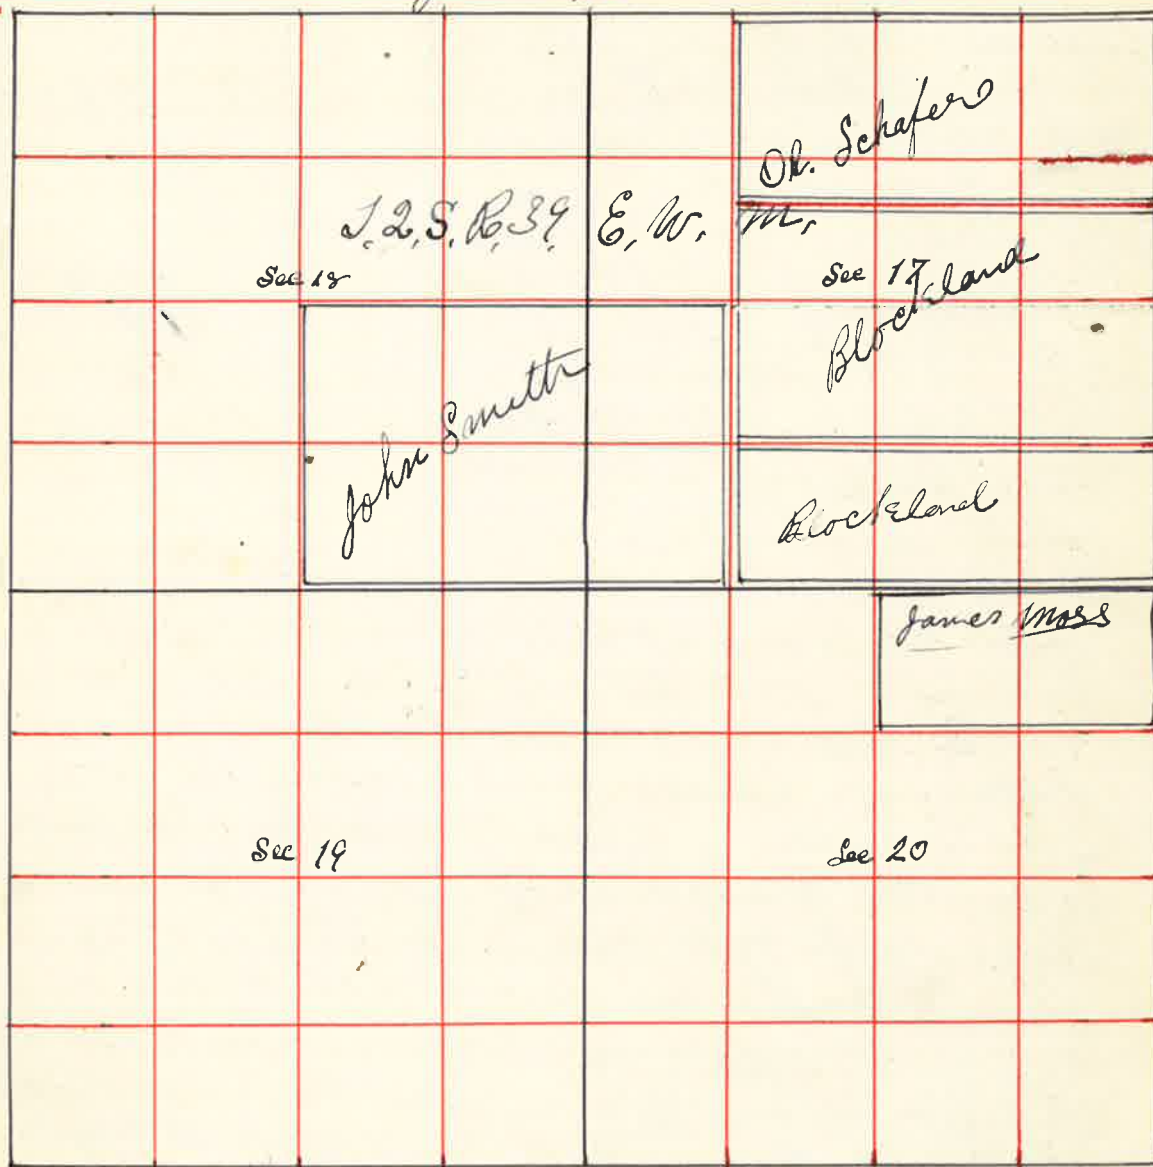

I Commenced at the corner to Secs 17=18=19 & 20
thence west 7788 chains the S.W. corner Sec 18 from which
I ran east 3774 chains set stone marked for 1/4 Sec corner between
Sec 18 & 19 the N.W. corner Sec 18 thence south for that purpose
of finding this line 3 miles to the S.W. corner of Sec 20 and find an excess
of 75 links or 25 links to each mile over the original U.S. field notes
the N.W. corner Sec 18 thence east 2 miles to the N.E. corner Sec
17 finding an excess of 56 links or 18 links to each mile I
therefore ran west 6018 chains planted a stone marked for 1/8
corner on north side N.W. 1/4 Sec 17 the corner to Sec 17=18=19 & 20
thence north 40 chains set stake for temporary 1/4 Sec corner 80 chains
found no corner thence north 80 chains thence north 7955 chains
the north boundary of Township making an excess of 50 links

75- See Page 74 Plat 65 John Smith Blockland & Schaffer
in the 3 miles over U.S. field notes set a stone for 1/4 Sec corner
4008 chains north of corner to Sec 17=18=19 & 20 from which
I ran west 4016 chains center Sec 18 7833 chains to 1/4 Sec
corner on west side Sec 18 the 1/4 Sec corner on south
side Sec 18 thence north 4012 chains the center Sec 18 8022 chains
the 1/4 Sec corner on north side Sec 18 initial point from
which I ran south 4011 chains set stone marked for
center Sec 18 the N.E. corner Sec 17 thence
south 2672 chains set stake for temporary point
60 chains set stake for temporary 1/8 corner 8000 chains set
stake for temporary Sec corner thence south 8036 chains
the corner to Sec 20=21=28 & 29 making an excess
of 18 links in each mile I there fore ran north
8018 chains set stake for corner north & south thence north
2004 chains set stone for 1/8 corner 5876 chains set stone
for fractional corner to Blockland & Schaffer
the corner to Sec 17=18=19 & 20 thence east
7994 chains set stake for temporary corner thence
east 7940 chains original measurement no corner
but at 85 links further on I find the corner
making an excess of 85 links in the 2
miles I there fore ran west 7983 chains
and planted a stone 7x12x24 for corner
to Sec 16=17=20 & 21 thence west 4018 chains
set stone for 1/4 Sec corner at 6027 chains set stone
for 1/8 corner on south side S.W. 1/4 Sec 17 thence
north 20 chains set stake 40 chains set stake 5888
chains set stake 8020 chains the 1/8 corner on north side
N.W. 1/4 Sec 17 from which I ran south 2672
chains set stone marked for fractional corner
between Blockland & Schaffer 4010 chains
set stone for center Sec 17 6016 chains set
stone for 1/8 corner in center S.W. 1/4 Sec 17
J.W. Kimbrell County Surveyor