Jack Farrell Lou Brande

Surveyed for Dewit Clark April 11 1889

by J.W. Kimbrell County Surveyor Plat No. 75

I commenced at the 1/4 Sec. Corner bet Sec 23 & 14 from which
a Fir 30 in brs S 43° W. 25 lks
" 4 " " N 8° E 20 lks
Thence East
2000 Set Temporary 1/8 corne
3987 The corner to Sec 13=14=23 & 24
Post from which
a Pine 10 in brs N 74° E 27 lks
" 18 " " N 6° W 60 "
" 8 " " S 30° W 28 "
" 6 " " S 23° E 55 "
Thence ~~South~~ Var 20° E
4000 The 1/4 Sec corner bet Sec 23 & 24
8000 The corner to Sec 23=24=25 & 26
Thence East Var 20° E
4000 The 1/4 Sec corner bet Sec 24 & 25

J.W. Kimbrell
County Surveyor

Surveyed for School Dist. No. 31 April the 25 1889

by J.W. Kimbrell County Surveyor Plat No 76

I Started at the 1/4 Sec corner bet Sec. 33 & 34
Thence West Var 20° E
2000 Set Stake for Temporary 1/16 corner in center E 1/2 Sec 33
4000 Set Stake for Temporary Cate
6000 Set " " Temporary Cate W 1/2
8033 The West Boundary 73 lks North of 1/4 Sec. Corner on West Boundary Sec 33
from Which I run East Setting Stakes on line between the 1/4 Sec corners

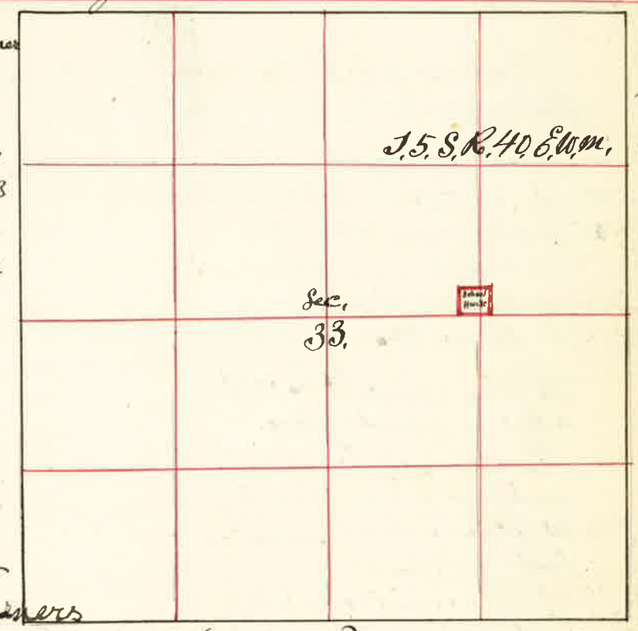

One acre out of the S 1/2 N E 1/4 Sec 33
Described as follows to wit Beginning 1234 feet West of the 1/4 Sec corner bet Sec 33 & 34
Thence West 208 71/100 Thence North 208 71/100 feet
Thence East 208 71/100 " South 208 71/100 feet to Place of Beginning containing One acre.

J.W. Kimbrell
County Surveyor