


I Commenced at the corner
 to Sec 15=16=21 & 22
 from which
 an aspo 8 in brs N 35° E 49 lks
 " " " " N 51° W 61 "
 " " " " S 60° E 60 "
 " " " " S 70° W 75 "

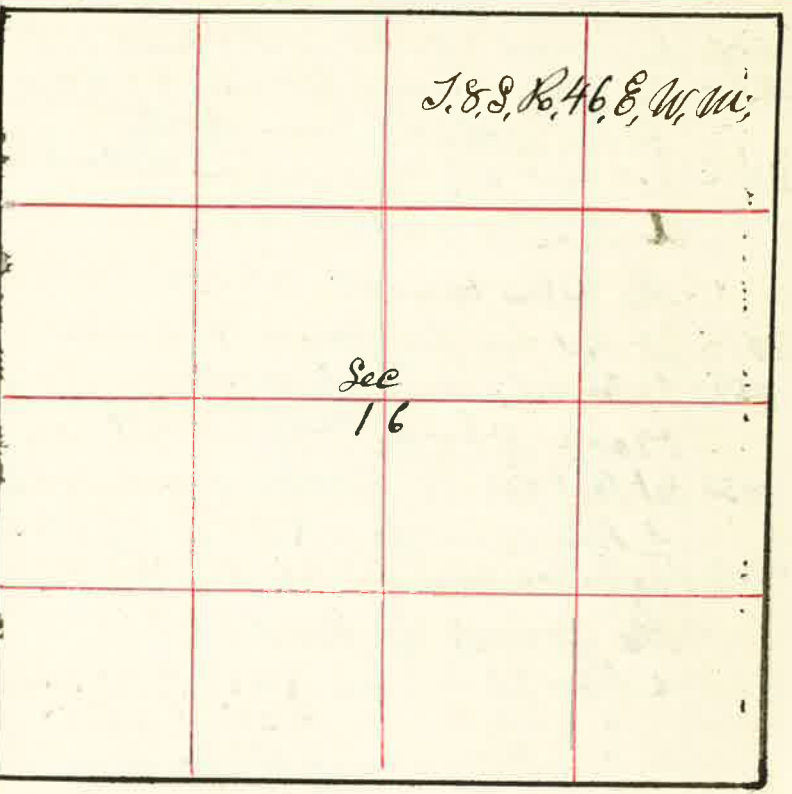

- 119 Pine Creek 74 lks wide S. E.
 2000 Set Stake for Temporary 1/4 corner
 4000 the 1/4 Sec corner bet Sec 15 & 16
 which is an alder 6 inches dia.
 from which
 an alder 5 in brs S 80° W 11 lks
 " " " " " " " " S 80° E 20 lks
 from this corner I run South
 2070 Set Post marked 1/2 for 1/2 corner
 from which
 an aspo 4 inch brs N 53° W 80 lks
 " " " " " " " " S 38° W 163 "
 4000 the corner to Sec 15=16=21 & 22
 Hence West var 20° E
 2014 Set Temporary 1/4 corner
 4027 US Field Note found No 1/4 Sec corner Set Stake for Temporary 1/4 corner
 8055 US " " " " Sec corner Set Temporary Stake and extend line west
 3947 The 1/4 Sec corner bet Sec 17 & 21 making a deficiency of 50 lks
 in the 1 1/2 miles I therefore run East on true line and at
 3981 set Stone volcanic 8 x 10 x 22 inch for corner to Sec 16=17=20 & 21
 Hence East
 4010 Set Stone 8 x 6 x 14 for 1/4 Sec corner bet Sec 16 & 21 15 lks west of creek bed.
 6015 Set Post marked 1/8 from which an aspo 4 in brs N 78 1/4° W 98 lks
 8020 the corner to Sec 15=16=21 & 22

The 1/4 Sec corner on west Boundary Sec. 16
 Hence East Through center var 19° 30' E
 2000 Set Stake for Temporary 1/6 corner in center W 1/2 Sec 16
 4000 " " " " " " " " center Sec 16
 4851 Pine Creek 100 lks wide turns S. E.
 5000 " " " " " " " " " " N. E.
 5300 " " " " " " " " " " S. E.
 6000 Set Stake for Temporary 1/6 corner in center E 1/2 Sec 16
 8028 Intersect East Boundary 67 lks North of 1/4 Sec corner

- The 1/4 Sec corner on South Boundary Sec 16 Hence North var 19° E
 2000 Set Post for Temporary 1/6 corner in center S 1/2 Sec 16
 4045 Intersect True E & W line 36 lks East of 1st Stake at this point
 4625 Pine Creek 75 lks wide runs East East
 6000 Set Stake for Temporary 1/6 corner in center N 1/2 Sec 16
 8014 Intersect North Boundary 106 lks East of 1/4 Sec corner
 from which I run South on True line var 20° E
 2002 Set Post marked 1/6 from which an aspo 4 inch brs N 11° W 11 lks
 4004 the center Sec 16 a Post from which
 an aspo 6 inch brs N 35° W 9 lks
 6020 Set Post from which
 an aspo 4 inches brs N 2° W 11 lks

The 1/6 corner in center S 1/2 Sec, 16 Hence East
 400 Creek 25 lks wide S. E.
 715 " " " " " " " " N. E.
 775 " " " " " " " " S. E.
 850 " " " " " " " " N. E.
 1200 " " " " " " " " South
 2000 Set Post for Temporary 1/6 corner in center S. E. 1/4
 3125 Pine Creek 50 lks wide runs South
 4008 Intersect East Boundary 25 lks North of 1/8 corner
 from which I run West
 2004 Set Post for center S. E. 1/4 Sec, 16
 The 1/6 corner in center W 1/2 Sec 16 Hence North through NW 1/4
 800 Co. Road N. W. 1/4 S. E.
 1300 Creek 15 lks wide S. E.
 1500 " " " " " " " " S. W.
 1675 " " " " " " " " S. E.
 2000 Set Stake for Temporary 1/6 corner in center NW 1/4 Sec 16
 3850 Pine Creek 35 lks wide course S. E.
 4002 the 1/8 corner on North Body N. W. 1/4 Sec 16 from which I run
 South var 20° 10' E
 2001 Set Post for center N. W. 1/4 Sec 16 from which
 an aspo 5 inches diameter brs S 61° E 32 lks distant
 J.W. Kimbell County Surveyor