



United States Department of the Interior

BUREAU OF LAND MANAGEMENT
OREGON STATE OFFICE
P.O. BOX 2965 (825 NE MULTNOMAH STREET)
PORTLAND, OREGON 97208



IN REPLY REFER TO:

9641 (942)

RECEIVED
OCT 25 1988

October 21, 1988

Mr. Howard Perry
Union County Surveyor
P.O. Box 1107
LaGrande, OR 97850

Dear Sir:

The enclosed diagram(s) indicate cadastral survey field work completed by this office from October 1987 through September 1988.

The diagram(s) are for informational purposes only. The final field notes and plat have not yet been prepared. If you need any information on any of these surveys, please feel free to contact this office at (503) 231-6987.

Sincerely,

Wayne M. Gardner
Chief, Branch of Cadastral
Survey


Enclosures (as stated)

UNION COUNTY SURVEYOR
Received <u>10-25-88</u>
Filed <u>10-28-88</u>
<u>G. LANGLITZ, DEPUTY</u>
File No. <u>NARRATIVE 1/12</u>

U.S. DEPARTMENT OF THE INTERIOR
 BUREAU OF LAND MANAGEMENT

TOWNSHIP DIAGRAM *

Township	2 SOUTH	Range	34 EAST	Meridian	WILLAMETTE	State	OREGON
----------	---------	-------	---------	----------	------------	-------	--------

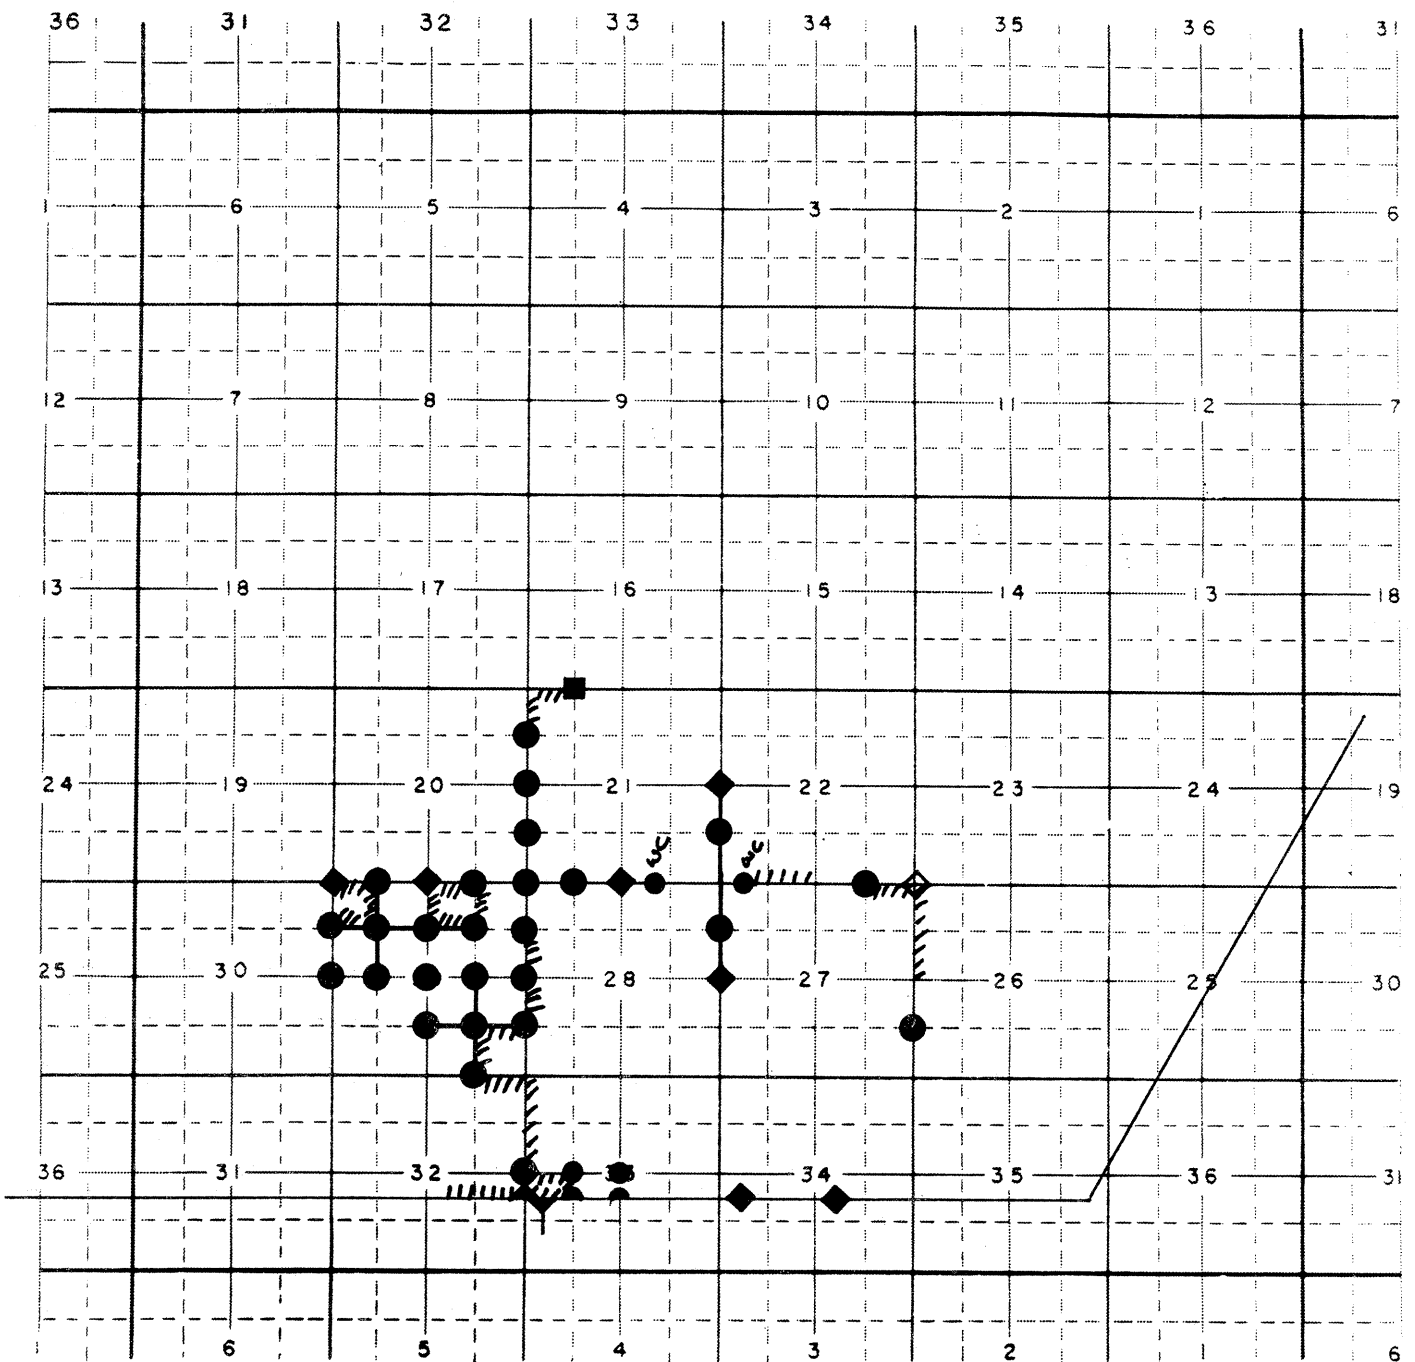

Field Work Completed During FY 1988

For the Bureau of Indian Affairs,

Umatilla Indian Reservation,
 Umatilla and Union Counties, Oregon

- Resurveyed or Surveyed line 3 1/2 Miles Resurveyed or Surveyed
 - ◊ Original Corner, previously remonumented 42 Monuments set
 - ◆ Original Corner, remonumented this survey
 - Corner established this survey Group 1343, Oregon
 - ||||| Reservation boundary posted by Richard L. Johnson
- Survey from 10/1/87 to 6/13/88