


CERTIFIED RECORD OF LAND CORNER MONUMENTATION

J-15.01

History of original corner establishment:

NONE

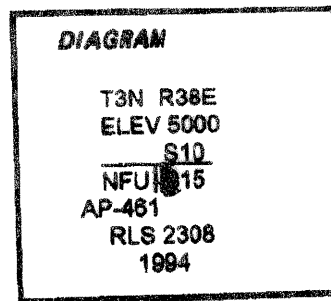

Description of corner evidence found:

NONE

Description of monument and accessories I established to perpetuate the original location of this corner:

At intersection of the 5000 foot contour with the line between sections 10 & 15, I set a 5/8" by 36" rebar, with a 3 1/4" diameter aluminum cap, flush with the ground

DATUM: NAD83(1991)
 STATE PLANE COORDINATES: OREGON NORTH ZONE (meters)
 Latitude: 45°44'47.11428" North
 Longitude: 118°02'44.70677" West

Northing: 234010.890 meters Easting: 2690940.860 meters

Date: September 12, 1994

Witnessed by: Laurie Marin

Magnetic declination: 20° East

REGISTERED
 PROFESSIONAL
 LAND SURVEYOR

David A. Schlaich

OREGON
 JULY 15, 1987
 DAVID A. SCHLAICH
 2308

Renews 12-31-94

Office of..... County of.....

State of....., I hereby certify that the within instrument was filed in this office

for record on the..... day of....., 19.....

..... by
 (COUNTY OFFICIAL) (DEPUTY)

Form R6-7100-57 (9/71)

UNION COUNTY
 SURVEYOR

Date Received 12/14/94
 Date Filed 12/21/94
 By [Signature]
 File No. 17-1994K