


Box # & Horizontal 1"=30' Vertical 1"=3'

Total CY 5291.01


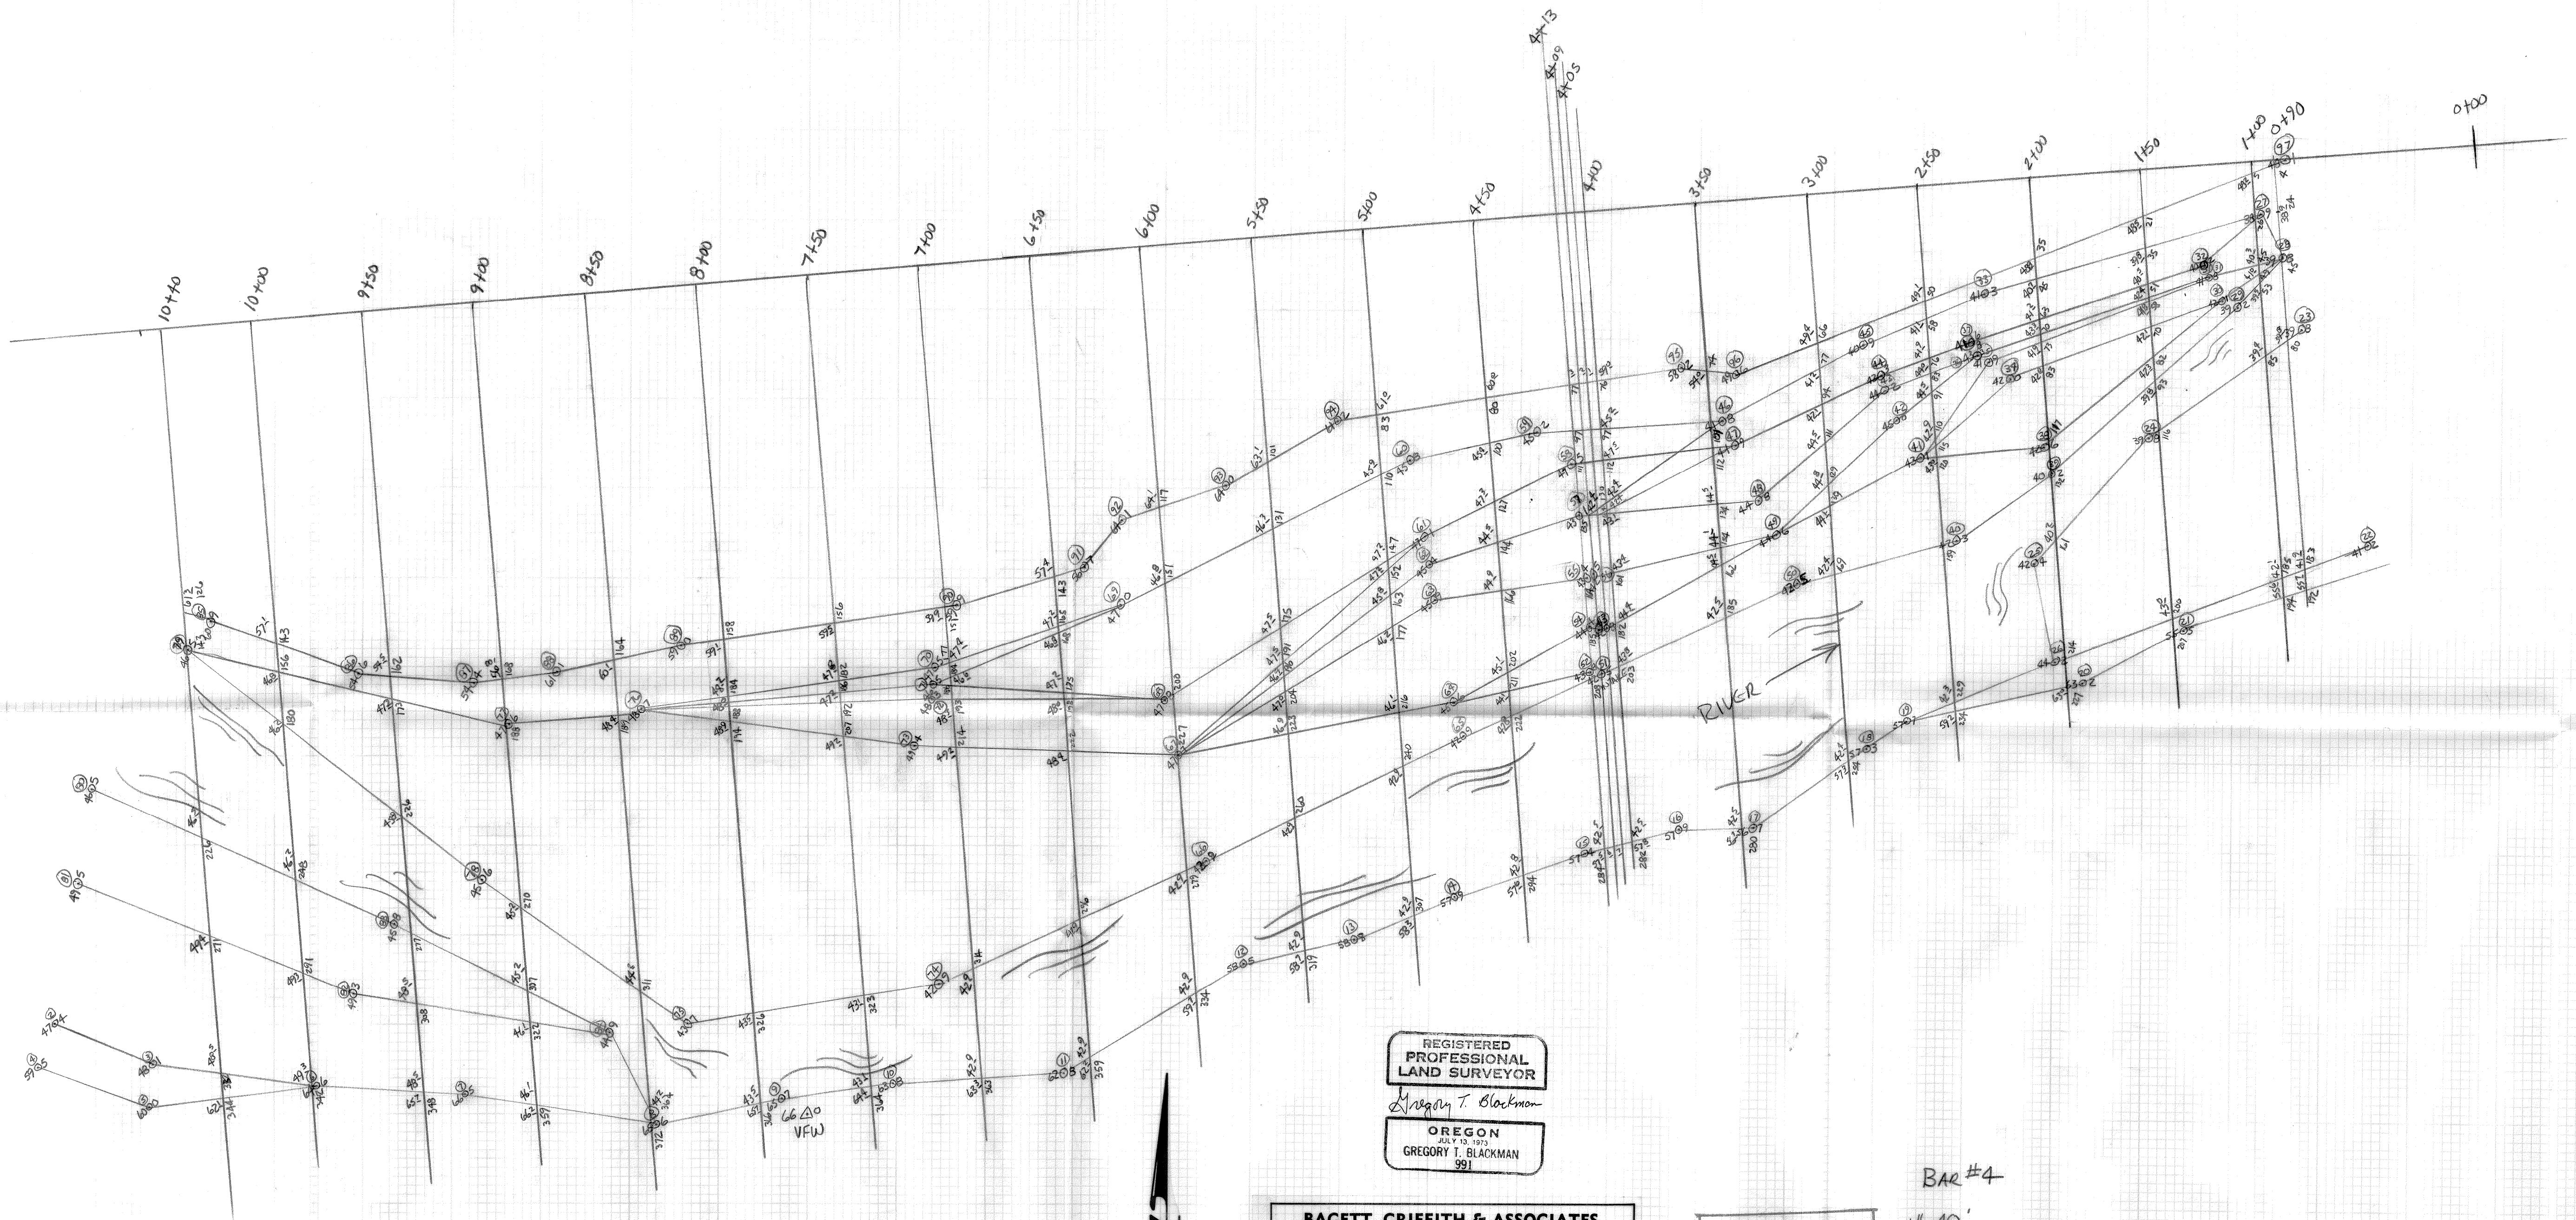

REGISTERED
PROFESSIONAL
LAND SURVEYOR

Gregory T. Blackman

OREGON

BAGETT, GRIFFITH & ASSOCIATES La Grande, Oregon	
BAR #4 TOP SHEET	
UNION COUNTY, OREGON	
SURVEYED FOR	R.D. MAC, INC.
SURVEYED BY	G.T.B.
Scale: 1" = 40'	Drawn by: B-15-86

UNION COUNTY SURVEYOR	
Date Received	8-19-86
Date Filed	9-19-86
By	
File No.	NARRATIVE 1/7

BAR #4
1" = 40'

SEE SURVEY 25-86