


CHAINS  
LKS.

for Andy Wilkinson March 25 1887

I commenced at the corner  
to Sec 9=10=15 & 16

thence East var 20° E

40 00 Set temporary 1/4 Sec corner  
The original corner being out of place  
80 50 I intersect East boundary old corner  
to Sec 10=11=14 & 15 which is a  
stone marked and established by  
Moses Austin Co. Surveyors

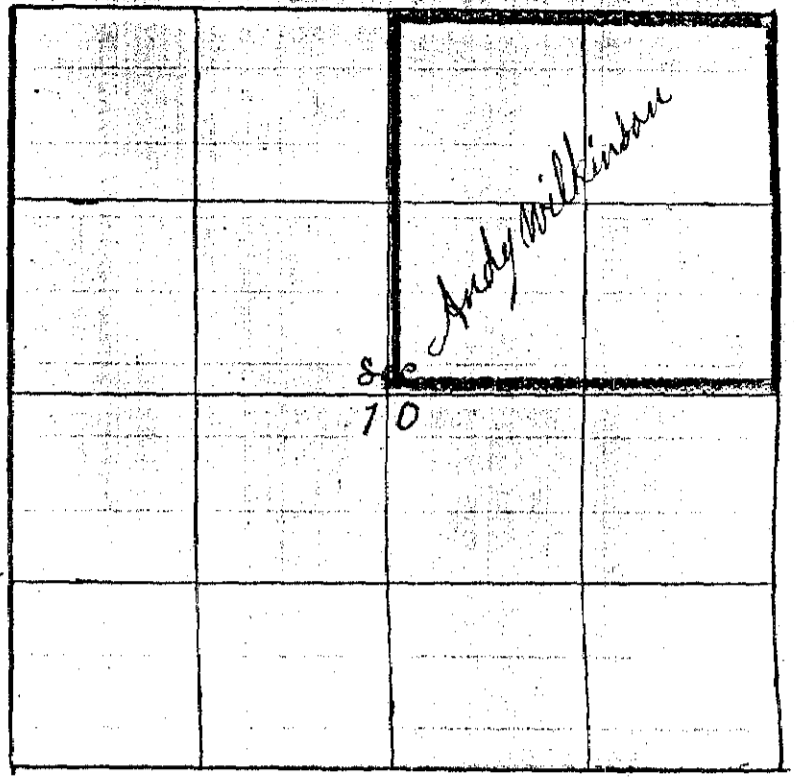

40 25 Set Stone 6 x 10 x 24 in for 1/4 Sec corner bet Sec 10 & 15 -  
from which I run West on line var 20° 30' E

The corner to Sec 10=11=14 & 15

thence North var 20° E

40 00 Set temporary 1/4 Sec corner The original corner being out of place  
80 70 the corner to Sec 2=3=10 & 11  
from which I run South var 20° 15' E

40 35 Set Stone 8 x 10 x 16 for 1/4 Sec corner bet Sec 10 & 11  
80 70 the corner to Sec 10=11=14 & 15

The corner to Sec 2=3=10 & 11

thence West var 20° E

40 00 Set temporary 1/4 Sec corner. The original corner being out of place  
80 70 I intersect 70 lks North of corner to Sec 3=4=9 & 10 a stone in middle  
from which I run N 89° 15' E var 20° E

40 35 Set Post in mound of earth for 1/4 Sec corner bet Sec 3 & 10  
80 70 The corner to Sec 3=4=9 & 10

The corner to Sec 3=4=9 & 10

thence South var 19° E

40 77 I intersect 35 lks East of 1/4 Sec corner bet Sec 9 & 10  
which I found by digging I found the point of old stake  
and some charcoal. Planted a Stone 5 x 10 x 22 in.

thence South

82 92 The corner to Sec 9=10=15 & 16

The 1/4 Sec corner bet Sec 9 & 10

thence East through  
Center Sec 10 var 20° E

Township 4 South Range 40 East W.M., Union County, Oregon.

CHAINS. LKS.

40 00 Set Temporary Post for Center Sec 10  
80 60 Intersect East Boundary Sec 10 20 lks North of 1/4 Sec corner between Sec 10 & 11

The 1/4 Sec Corner bet Sec 3 & 10  
Hence South through Center  
Sec 10 Var 20° E

40 26 Intersect E & W line 30 lks East of Temporary Stake  
81 47 The 1/4 Sec corner bet Sec 10 & 15 from which  
I run North on true line Var 20° E

41 21 Set Stone 10 x 18 x 25 inches marked C.S. for  
Center Sec 10

81 47 The 1/4 Sec corner bet Sec 3 & 10

J.W. Kimbrell Deputy Surveyor