


Township 3 South

Range 38 East W.M.

Union County, Oregon.

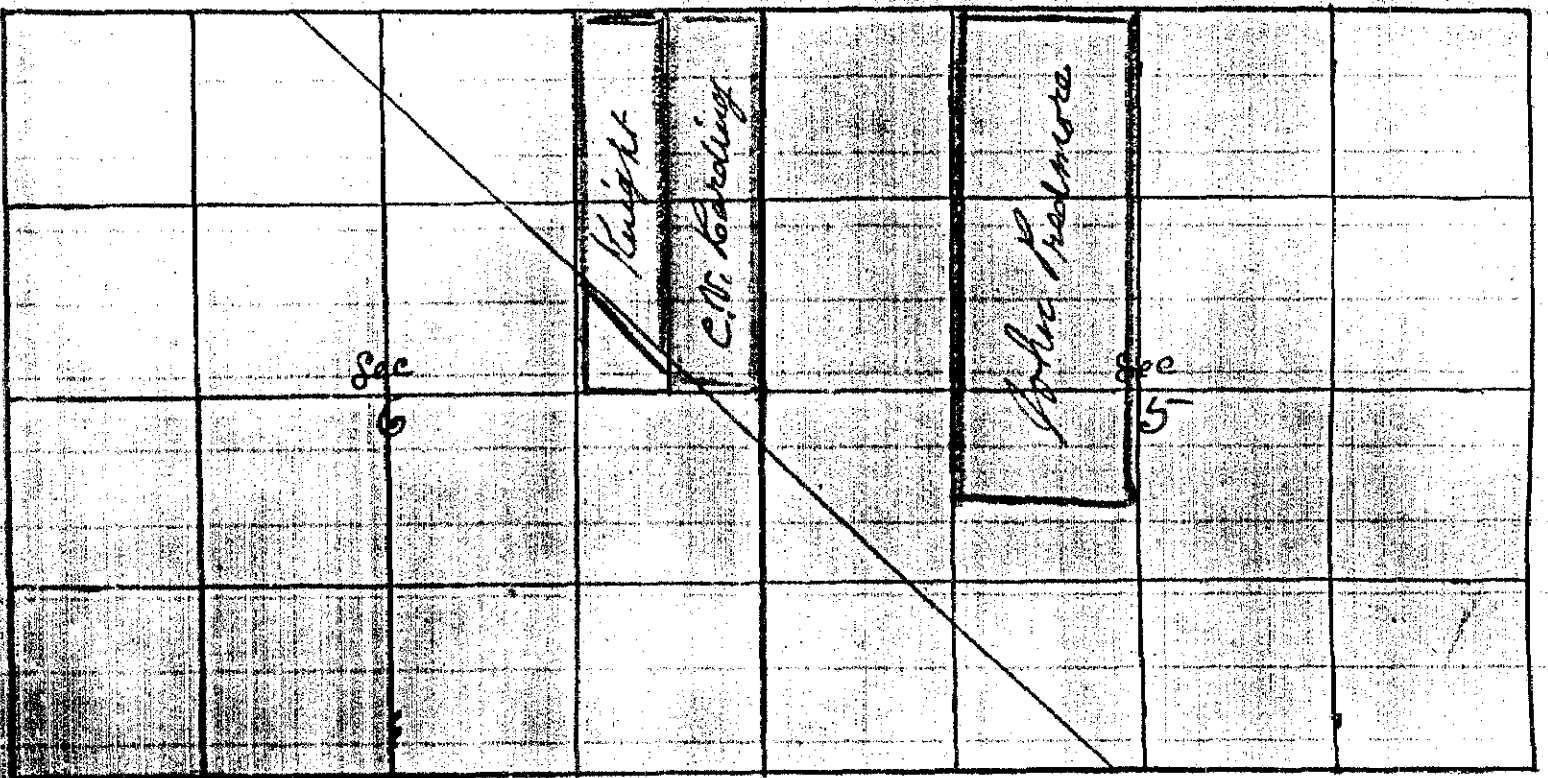

for John Fredmore & C.V. Harding March 29 1887

I Commenced at the 1/4 Sec corner on North Boundary Sec 5-
Thence West Varo 20° 15' E

20 00 Set Temporary 1/8 corner
 40 00 Set Temporary corner to Sec 5=6=31 & 32 The original corner
 being out of place
 Thence West Varo 20° E

10 00 Set Temporary Stake
 20 00 Set Temporary 1/8 corner
 77 48 Intersect at Point of Corner to Sec 1=6=31 & 36 and
 Townships 2 & 3 South of Ranges 37 & 38 East
 This corner being out of place I Reestablished it
 by Planting a Stone 6 x 12 x 19 inches from which
 a Pine Tree 24 inches dia. brs N 65° E 182 lks distant
 " " 24 " " " S 55° E 465 " " This Tree
 having ben cut down and Stumps decayed I marked in place
 a Pine Tree 5 inches dia. brs S 51° 45' E 370 lks distant
 Thence East on T.P. line allowing 5 lks to the 1/4 mile

57 38 Set Stone 6 x 8 x 29 inches for 1/8 corner
 67 35 1/2 Set Stone 6 x 7 x 16 inches
 77 38 Set Stone 7 x 10 x 28 inch for corner to Sec 5=6=31 & 32
 Thence East Varo 20° E

20 05 Set Post in Marsh for 1/8 corner from which
 a Willow Tree 21 inches dia. brs N 55° E 22 lks distant
 40 10 The 1/4 Sec corner bet Sec 5 & 32
 The corner to Sec 5=6=31 & 32
 Thence South Varo 21° E

39 45 Set Temporary 1/4 Sec corner. The old corner being out of place
 79 45 Set Temporary corner to Sec 5=6=7 & 8 The original

RECORD OF SURVEY

6
1887

Township

Range

Union County, Oregon.

- Corner being out of Place
 Thence South 27° E
- 80 20 The corner to Sec 7=8=17 & 18. Making an Excess of 20 lks
 I therefore run North allowing 5 lks to each 1/2 mile Excess
- 80 10 Set Stake for corner to Sec 5=6=7 & 8
 Thence North 21° E
- 40 05 Set Stone 7 x 9 x 22 inches for 1/4 Sec corner bet Sec 5 & 6
- 39 55 The corner to Sec 5=6=81 & 82

The 1/4 Sec Corner bet Sec 5 & 6
 Thence West through center Sec 6 20° E

- 10 02 1/2 Set Stone 4 x 9 x 20 inches
- 20 05 Set Stone 5 x 6 x 16 "
- 40 20 Intersect Stone Mound previously built by same
 Person for center Sec 6
- 78 35 Intersect West Boundary at 1/4 Sec corner
 bet Sec 1 & 6 from which
 a line 24 inch brs $S 85^{\circ} \text{ E}$ 168 lks distant

J. W. Kimball Deputy Co. Surveyor