


Township 4 South

Range 39 East W.M.

Union County, Oregon.

For P. M. Coffin July the 6th 1887

CHAINS
LKS.

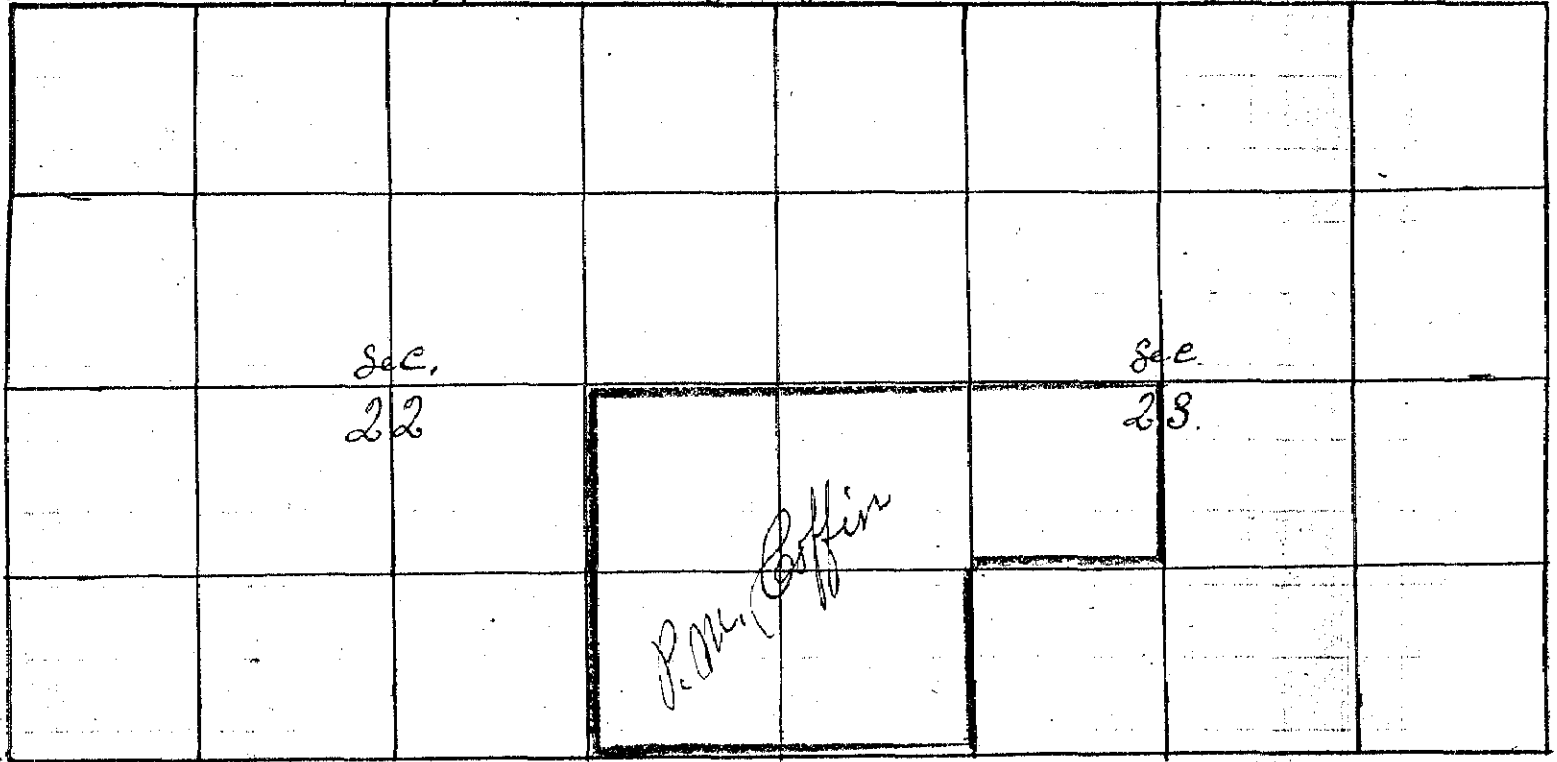

I Commenced at the $\frac{1}{4}$ Sec corner bet Sec bet Sec 22 & 23
Which is a Post in Mound of Stone

Thence West through the Center Sec 22 var 20° E

20 00 Set Temporary $\frac{1}{16}$ corner

40 00 Set Temporary Center Sec 22

83 50 The $\frac{1}{4}$ Sec corner bet Sec 21 & 22 a Post in Mound bet Sec

The $\frac{1}{4}$ Sec corner bet Sec 15 & 22

Thence South through the Center Sec 22 var. 20° E

41 85 Intersect E & W line through center Sec 22 100 lks West
of Random Stake previously set at this point

81 85 The $\frac{1}{4}$ Sec corner bet Sec 22 & 27 a Post in Mound
from which

I run North on line

40 00 Set Stone $8 \times 12 \times 28$ inches built Mound of Stone for
 $\frac{1}{16}$ corner in Center Sec 22

Thence East var 20° E

20 50 Set Stake and Mound of Stone for $\frac{1}{16}$ corner in Center Sec 22

41 00 The $\frac{1}{4}$ Sec corner bet Sec 22 & 25

The $\frac{1}{4}$ Sec Corner bet Sec 22 & 27

Thence East bet Sec 22 & 27 var 20° E

20 00 Set Temporary $\frac{1}{8}$ corner

41 36 The corner to Sec 22 = 23 = 26 & 27 a Post in Mound of Stone
from which

I run West var 20° E on line

20 68 Set Stake and built Mound of Stone for $\frac{1}{8}$ corner

41 36 The $\frac{1}{4}$ Sec corner bet Sec 22 & 27

Land Mountain Stake to the N^W of Sec 22

Township 4 South Range 39 East W. M. Union County Oregon.

- The corner to Sec 22=23=26 & 27
Hence North bet Sec 22 & 23 over 20° E
- 20 00 Set Temporary 1/8 corner
39 50 the 1/4 Sec corner bet Sec 22 & 23
from which
1/2 run South on true line over 19° E
- 19 75 Set Stone 6x2x20 inches and Built-Mound of Stone for 1/8 corner
39 50 The corner to Sec 22=23=26 & 27
- The 1/8 corner on South Boundary S E 1/4 Sec 22
Hence North through center S E 1/4
- 19 87 Set Stake built-mound of Stone for 1/16 corner in center S, E, 1/4
39 75 The 1/16 corner in center E 1/2 Sec 22
- The 1/8 corner on West Boundary S W 1/4 Sec 23
Hence East over 20° E
- 20 00 Set Stone and Built-Mound of Stone for 1/16 corner
in center S W 1/4 Sec 23
Hence North over 20° E
- 20 00 Set Stake in Mound of Stone for center W 1/2 Sec 23
Hence West over 20° E
- 20 00 The 1/4 Sec corner bet Sec 22 & 23

J. W. Kirkell Deputy Co. Surveyor