

RECORD OF SURVEY

No. 13


Township 5 South

Range 39 East W. M.

Union County, Oregon.

For C. L. Kayler Aug. the 15th 1887

CHAINS. I.KS.

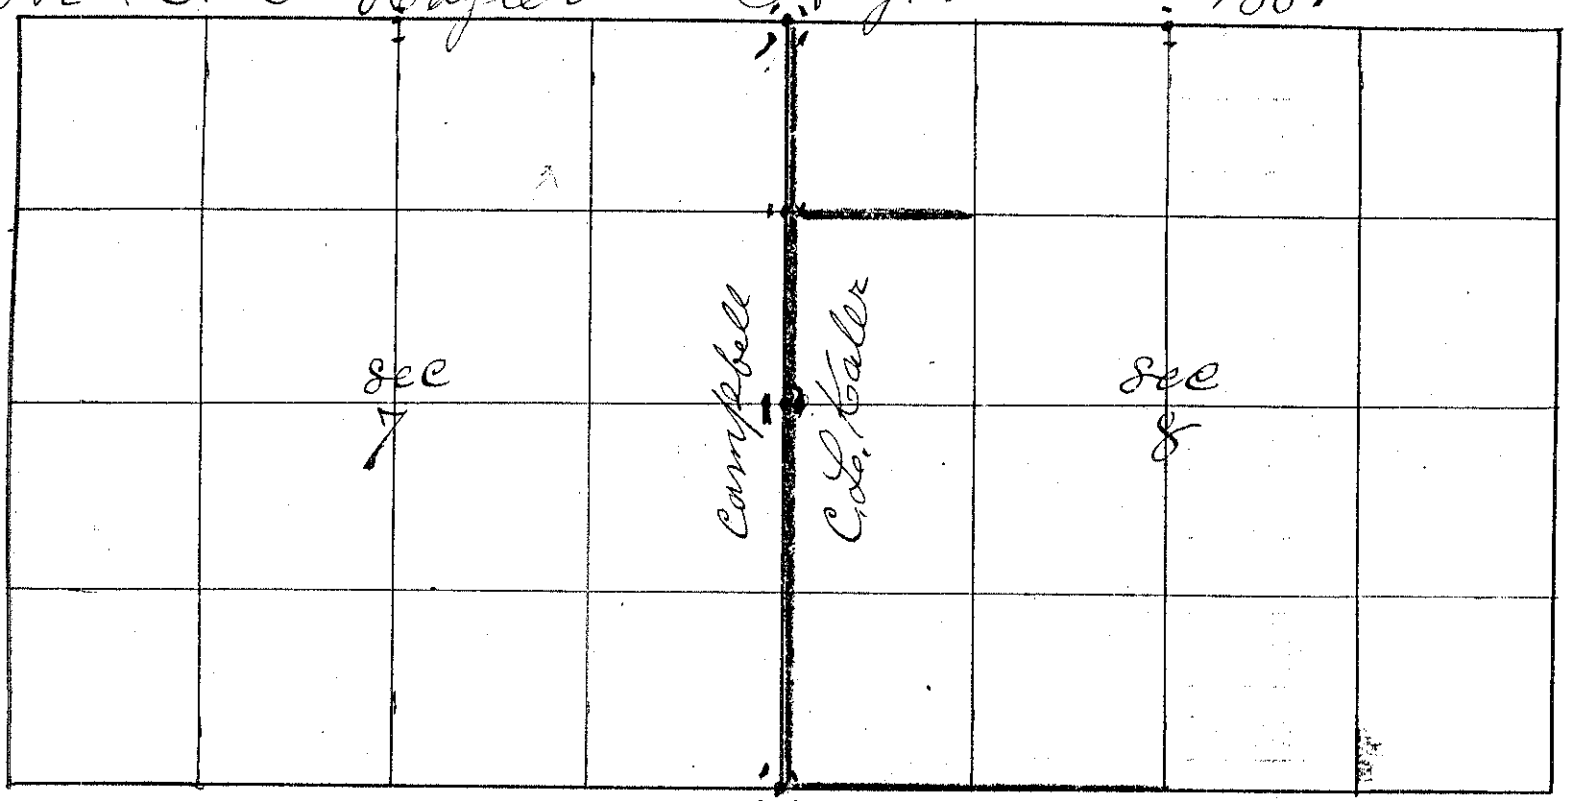

This Survey was made for the purpose of Re-establishment of the corner to Sec 5=6=7 & 8 and the 1/4 Sec corner bet Sec 7 & 8 and Subdivision corners and Sec. Line bet Sec 7 & 8 which is also the line between the lands of Campbell & Kayler

I Commenced at the 1/4 Sec corner bet Sec 6 & 7 a Post in Md. of Stone. Thence East bet Sec 6 & 7 var 20° E

40 00 Set Temporary corner to Sec 5=6=7 & 8 the original corner being out of place

Thence East bet Sec 5 & 8 var 20° E

40 2 1/2 U.S. Field Notes found no 1/4 Sec corner but at 40 88 the 1/4 Sec corner bet Sec 5 & 8 a Post in Mound of Stone Making an Excess of 66 1/2 lks over U.S. Field Notes

I therefore run West and divide this Excess bet. the whole distance run Making Each 1/2 mile 33 1/4 lks longer than the original Measurement

40 55 Set Post for Temporary corner to Sec 5=6=7 & 8

80 88 the 1/4 Sec corner bet Sec 6, 8, 7.

The corner to Sec 7=8=17 & 18 - Thence North bet Sec 7, 8, 8 var. 20° E.

40 00 Original U.S. Field Notes found no 1/4 Sec corner Set Temporary 1/4 Sec corner

80 00 Set Temporary corner to Sec 5=6=7 & 8

Township _____ Range _____ Union County, Oregon.

Thence North between Sec 5 & 6
Var 20° E

4000 found No 1/4 Sec corner but at
4072 the 1/4 Sec corner bet Sec 5 & 6 a Post in Mound of Stone
making an Excess of 72 lks over U.S. Field Notes
In the 1 1/2 miles retraced

I therefore ran South allowing 24 links to each
1/2 mile and at

4024 I re-established the corner to Sec 5 = 6 = 7 & 8
by planting a Post 4 inches Square 3 1/2 feet long 18 inches
in the ground with a Handfull of Charcoal at the
bottom of Post Built mound of Earth dug pits
S & S.W. N.E. & N.W. from Post 5 feet distant
Thence South Var. 20° E

2012 Set Post 4 inches Square and 3 1/2 feet long 18 inches in
the ground with a handfull of Charcoal at Bottom
of Post Built mound of Earth with Pits E. & W. 5 feet from Post

4024 Set Post 4 inches Square 3 1/2 feet long 18 inches in the
ground with handfull of Charcoal at bottom of
Post with Mound of Earth with Pits E & W 5 feet from Post

5048 The corner to Sec 7 = 8 = 17 & 18

Thomas Shaw Chairman
J. C. Childers "

J. W. Kimbrell Deputy Co. Surveyor