

No. 15

Township 5 South


Range 40 East W.M.

Union County, Oregon.

For J. B. Dawson

Sept 16 1887

- 20 00 I commenced at the $\frac{1}{4}$ sec corner bet sec 31 & 32 a post in mid of stone
- 80 38 Thence East through the center sec 32 var 20° E
- 20 00 Set temporary $\frac{1}{16}$ corner
- 80 38 Intersect East boundary 32 lks North of $\frac{1}{4}$ sec corner bet sec 31 & 32 which is a stone marked $\frac{1}{4}$
- 60 28 Thence $N 89^{\circ} 46' W$ on true line through center sec 32 var 20° E
- 80 38 Set post in mound of stone for $\frac{1}{16}$ corner the $\frac{1}{4}$ sec corner bet sec 31 & 32
- 39 32 Thence North var 20° E the corner to sec 29 = 30 = 31 & 32 a post
- 20 90 Thence East bet sec 29 & 32 var 20° E.
- 40 00 Set temporary $\frac{1}{8}$ corner found no $\frac{1}{4}$ sec corner
- 50 60 The corner to sec 28 = 29 = 32 & 33 a post in mound of stone
- 60 45 Thence West on line set post in mound of stone for $\frac{1}{8}$ corner
- 80 60 the corner to sec 29 = 30 = 31 & 32
- 39 72 Thence North bet sec 29 & 30 the $\frac{1}{4}$ sec corner bet sec 29 & 30 a stone in mid of stone
- 20 00 Thence East var 20° E set post in mound of stone for $\frac{1}{16}$ corner in center w $\frac{1}{2}$ sec 29
- 39 75 Thence South var 20° E the $\frac{1}{8}$ corner
- 39 40 Thence South var 20° E the $\frac{1}{16}$ corner in center w $\frac{1}{2}$ sec 32

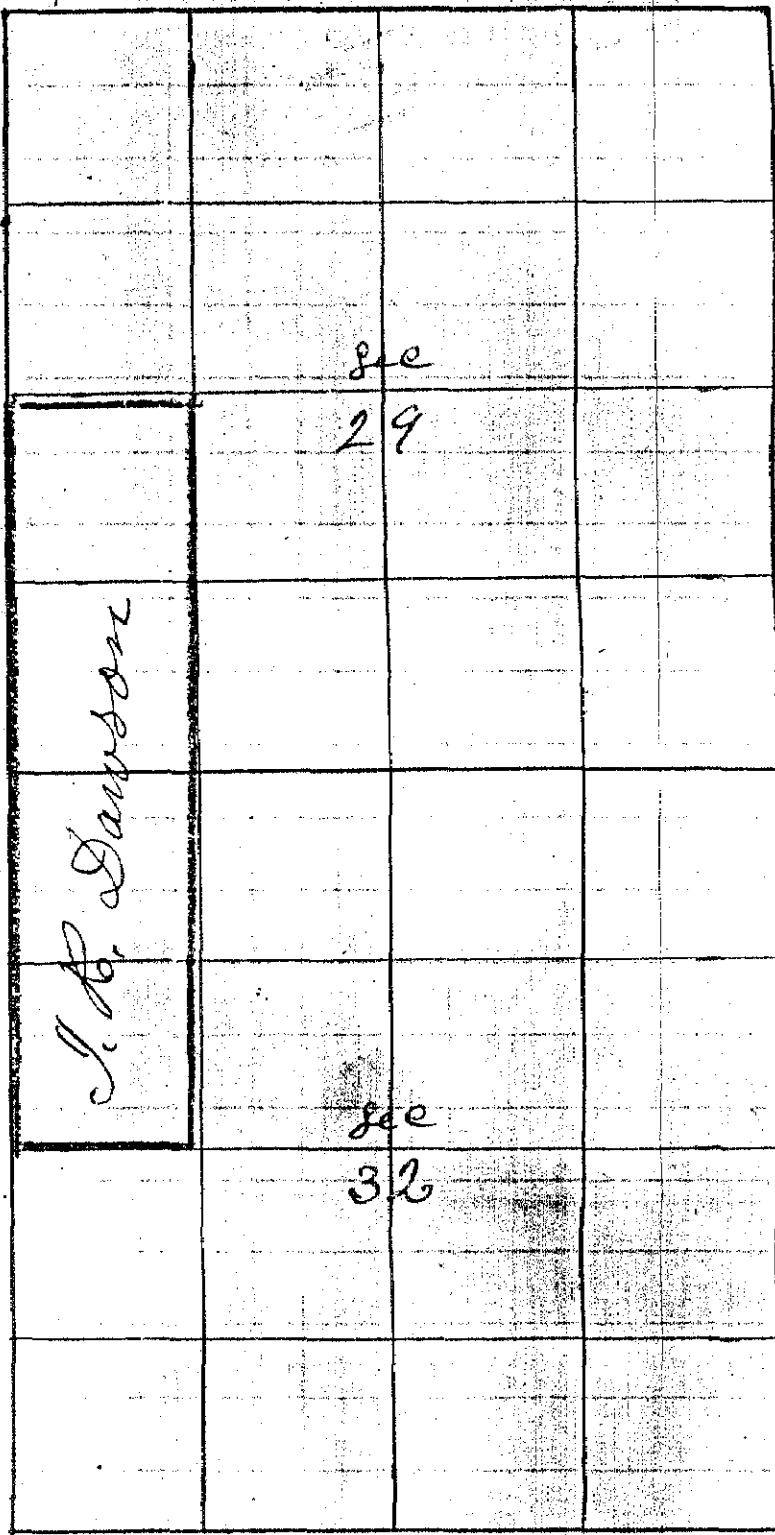

J. W. Kimbrell Deputy Co. Surveyor