


Township 4 South Range 38 East W.M. Union County, Oregon.

CHAINS LKS

Fredrick Braden Oct. 7 1887

I Commenced at the corner to Sec 1=12=6 & 7 on Range line bet Ranges 38 & 39 T 4 South which is a Post in Mid of Stone thence west bet Sec 1 & 12 var 20° E

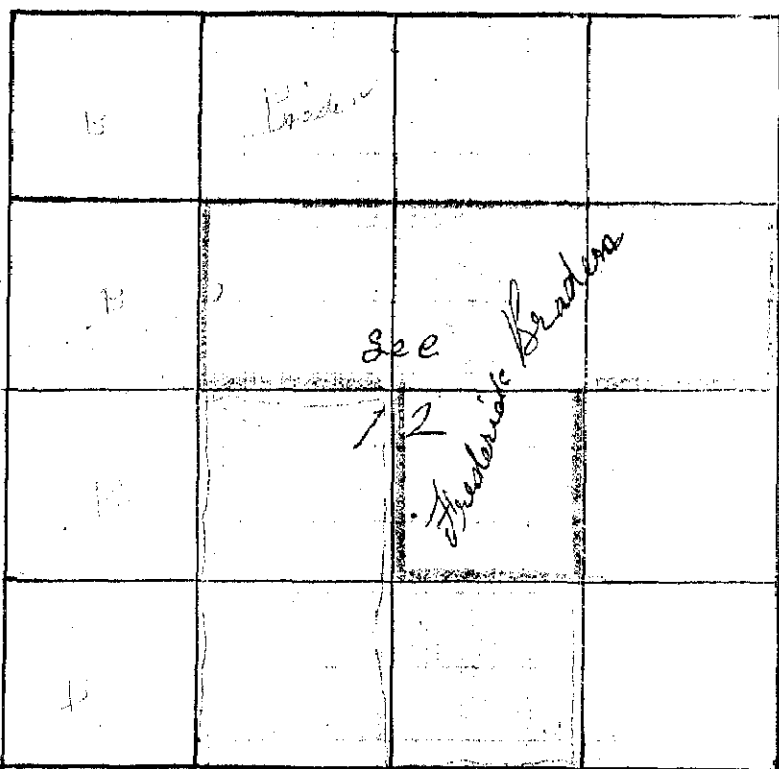

20 00 Set temporary 1/8 corner

39 87 found no 1/4 sec. corner

40 00 Set temporary 1/4 sec corner

60 00 Set temporary 1/8 corner

80 28 Intersect N & S line 50 lks North of corner to Sec 1=2=11 & 12 which is a Stone in Mid of Stone making an Excess of 47 lks over U S field Notes and a falling of 12 1/2 lks South and 11 3/4 lks West to each 1/4 of a mile

I therefore run N 89 17° East on true line

20 07 Set Post in Mound of Stone for 1/8 cor

40 14 Set Post in Mound of Stone for 1/4 sec corner

60 21 Set Post in Mound of Stone for 1/8 corner

80 28 The corner to Sec 1=12=6 & 7

Thence South on Range line bet Sec 7 & 12 var 20° E

20 00 Set temporary 1/8 corner

40 38 The 1/4 sec corner bet Sec 7 & 12 a Post in Mid of Earth Thence North on same var.

20 19 Drove Stake and built Mound of Stone for 1/8 cor.

40 38 The corner to Sec 1=12=6 & 7.

The 1/4 sec corner bet Sec 12 & 13 a Stone marked 1/4.

Thence North through Center Sec 12

40 00 Set temporary Center Sec 12 var 20° E.

60 00 Set temporary 1/16 corner

79 43 The 1/4 sec corner bet Sec 1 & 12

The 1/4 sec corner bet Sec 11 & 12

Thence East through Sec 12

var 20° E.

20 00 Set temporary 1/16 corner

38-88 I intersect N & S line 84 lks South of first Stake for center

60 00 Set temporary 1/16 corner

79 88 The 1/4 sec corner bet Sec 12 & 7

Thence West var 20° E.

20 50 Set Post in Mound of Earth for 1/16 corner

RECORD OF SURVEY

29
1887

Township 4 South

Range 38 East W 170

Union County, Oregon.

- | Cont | L.Rs. | Description |
|------|-------|-------------------------------------------------------------------------------|
| 111 | 50 | Set Post in mound of Stone for Center Sec 12 |
| 60 | 44 | Set Stone in mound of Stone for $\frac{1}{16}$ cone |
| 79 | 88 | The $\frac{1}{4}$ Sec corner bet Sec 11 & 12 |
| | | The $\frac{1}{16}$ corner in center W $\frac{1}{2}$ Sec 12 |
| | | Thence North through N $\frac{1}{4}$ Sec 12 |
| 20 | 50 | Set temporary $\frac{1}{16}$ cone |
| 40 | 22 | The $\frac{1}{8}$ corner on North Bdy N $\frac{1}{4}$ |
| | | Thence South on 20° E |
| 20 | 11 | Set Stone in mound of Stone for $\frac{1}{16}$ cone in center N $\frac{1}{4}$ |
| 40 | 22 | The $\frac{1}{16}$ cone in center W $\frac{1}{2}$ Sec 12 |
| | | The center Sec 12 |
| | | Thence North on 20° E |
| 20 | 50 | Set temporary $\frac{1}{16}$ cone |
| 40 | 28 | The $\frac{1}{4}$ Sec corner bet Sec 11 & 12 |
| | | Thence South |
| 20 | 14 | Set Stone in mound of Stone for center N $\frac{1}{2}$ Sec 12 |
| 40 | 28 | The center Sec 12 |

J. W. Kimbrell Deputy Co. Surveyor