No. 19

31

1887

Township 8 South Range 42 East W M Union County, Oregon.

Chains	Lks.	

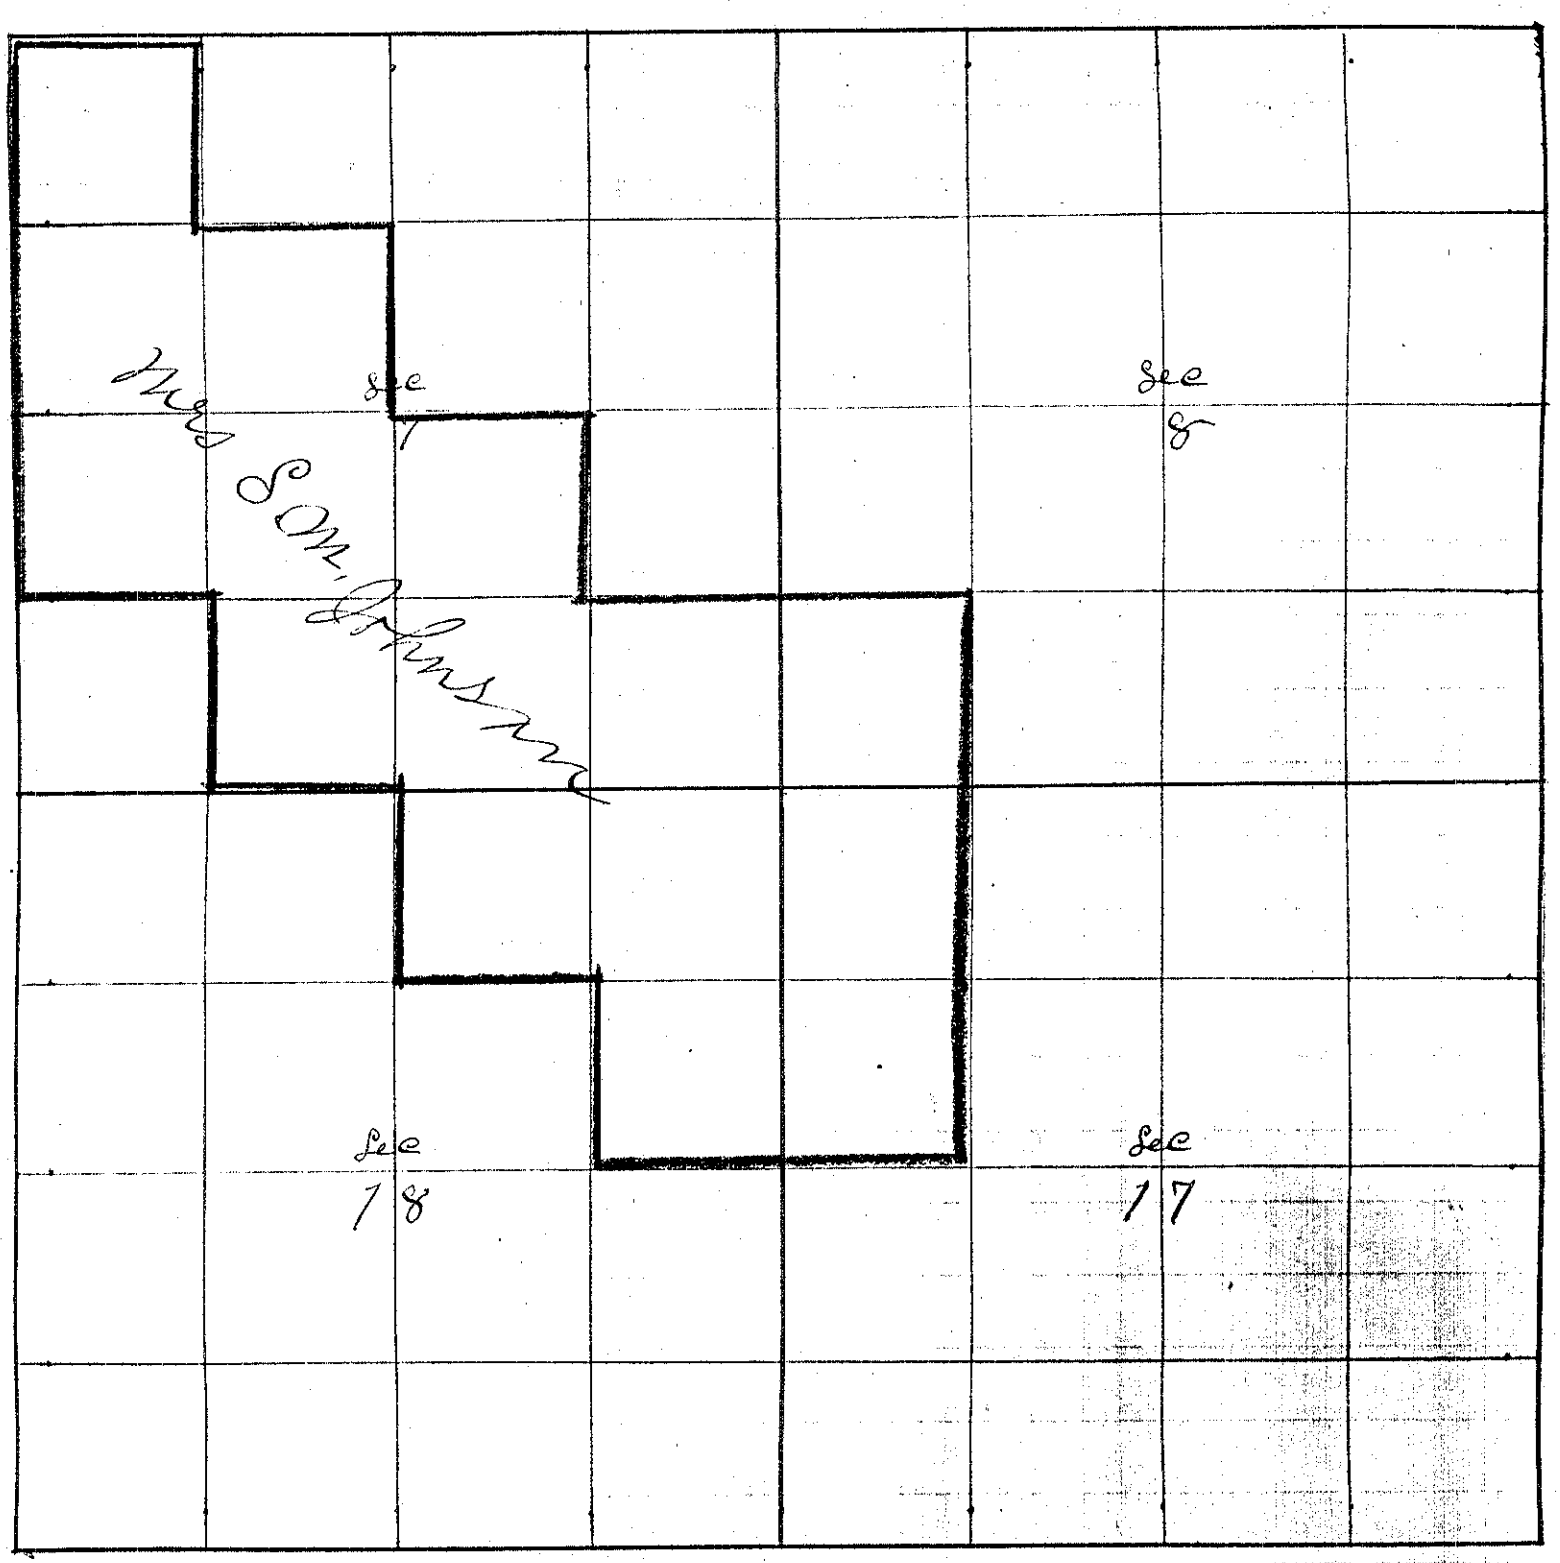

I Commenced at the Corner to Sec 7=8=17&18
a Post in Mound of Earth
Thence North var 20° E

20	00	Set Post for 1/8 corner
40	00	The 1/4 Sec Corner Set Sec 7 & 8 a Post in Mnd. of Earth

The Corner to Sec 7=8=17&18
Thence West var 20° E

17	14	Powder River 146 lks across Course S 10° E
20	00	Set Temporary 1/8 Corner
40	00	The 1/4 Sec corner Set Sec 18 & 19 Post in Mnd. of Earth

Thence West

20	00	Set Post for 1/8 corner
40	18	The Corner to Sec 7=18=12&13 Post in Mnd of Earth

Thence North var 20° 30' E

20	00	Set Post for 1/8 corner
40	00	The 1/4 Sec Corner Set Sec 7 & 12

Thence East Through Sec 7 Var 20° 15' E

5	50	Powder River 132 lks across Course S 25° E