


Township 2 South Range 39 East W M Union County, Oregon.

Chrisman and Spain

CHAINS. LRS.

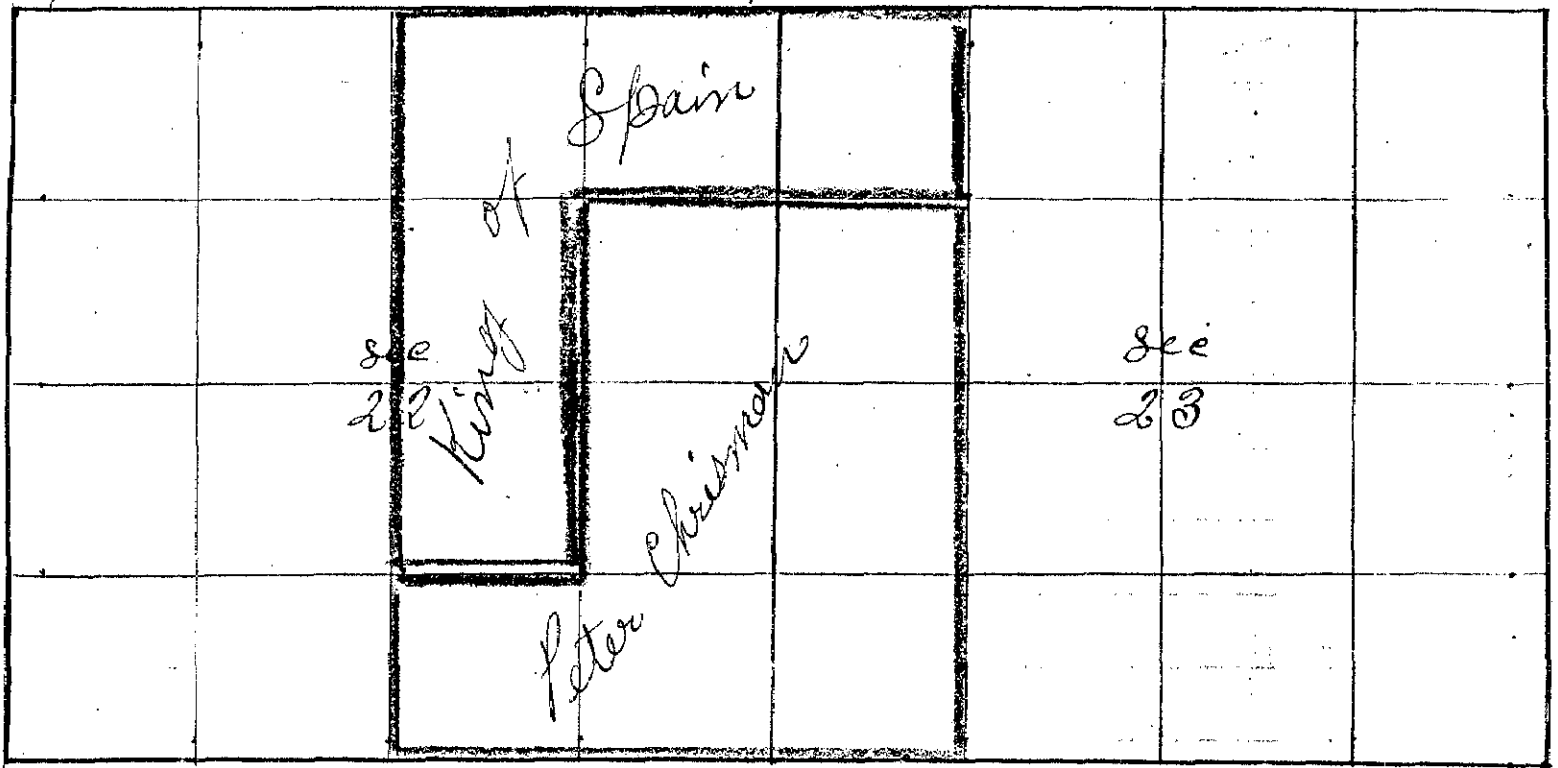

I Commenced at the 1/4 Sec corner bet Sec 14 & 15 as there was no known Original Government corners Standing to either of these two Secs, 22 & 23 and it being Messesary to Re-establish the Same I Proceeded to do so as per Instructions from the Hon. Commissioner of the General Land Office to U.S. Deputies is by Proportional Measurement to the Nearest known Existing corners

- Thence South bet Sec 14 & 15 var 20° E
- 40 00 Set Temporary corner to Sec 14 = 15 = 22 & 23
- Thence South bet Sec 22 & 23 var 20° E
- 20 00 Set Temporary 1/8 corner
- 40 00 Set Temporary 1/4 Sec corner
- 60 00 Set Temporary 1/8 corner
- 80 50 Set Temporary corner to Sec. 22 = 23 = 26 & 27
- Thence South bet Sec 26 & 27 var 19° 45' E
- 40 00 found no 1/4 Sec cor
- 800 00 found no corner to Sec 26 = 27 = 34 & 35 -
- Thence South bet Sec 34 & 35 var 20° E
- 40 00 found no 1/4 Sec cor
- 80 00 found no Sec corner but at 260 lcs further on 1/4 found the corner to Sec 2 = 3 = 34 & 35 on Sp line bet T 2 & 38 R 39 East making an excess of 260 lcs excess as per U.S. field Notes I therefore have a falling of 37 links South to each corner
- Thence North
- 1'61 48 Set Post for Temporary corner to Sec 22 = 23 = 26 & 27
- Thence North on Random line
- 20 18 1/2 Set Temporary 1/8 cor
- 40 37 Set Temporary 1/4 Sec cor
- 60 55 1/2 Set Temporary 1/8 corner

CHRISTIAN & SPAINO
80 74 Set Temporary Corner to Sec 14 = 15 = 22 & 23
Thence North

40 87 The 1/4 Sec corner bet Sec 14 & 15

I then proceeded to the corner to Sec 20 = 21 = 28 & 29
Thence East bet Sec 21 & 28 var 15° E

39 80 found no 1/4 Sec corner

79 60 found no Sec corner but set temporary corner to Sec 21 = 22 = 29 & 28
Thence East bet Sec 22 & 27

40 13 found no 1/4 Sec corner set temporary 1/4 Sec

80 20 Set temporary corner to Sec 22 = 23 = 26 & 27 Independent of 1st State
Thence East bet 23 & 26

39 77 found no 1/4 Sec corner set temporary 1/4 Sec

79 54 found no corner but set temporary corner to Sec 23 = 24 = 25 & 26
Thence East bet 24 & 25

39 77 found no 1/4 Sec corner

79 54 found no Sec corner but at 229 lbs further on I found the
corner to Sec 24 = 25 = 19 & 30 on Guide meridian line bet
Rangers 39 & 40 East I therefore have an excess of 225 lbs
as per U S Field Notes and the falling would be 8 1/2 lbs East to each 1/2 mile
Thence West

80 14 Set Post for Temporary corner to Sec 23 = 24 = 25 & 26
Thence West

40 05 1/2 Set temporary 1/4 Sec corner

80 11 Set Post in mound of Earth 1/25 lbs for corner to Sec 22 = 23 = 26 & 27
Thence West

40 41 Set stone for 1/4 Sec corner bet Sec 22 & 27

80 82 The corner to Sec 21 = 22 = 27 & 28

The 1/4 Sec corner bet Sec 13 & 14
Thence South var 20° E

20 50 Set temporary 1/8 corner

40 36 The corner to Sec 13 = 14 = 23 & 24 Post decayed Re-set Post, built and the
Thence North

20 18 Set Post in road to 1/8 corner

40 30 The 1/4 Sec corner bet Sec 13 & 14

The corner to Sec 13 = 14 = 23 & 24

Thence South var 20° E

40 50 found no 1/4 Sec corner set temporary 1/4 Sec

80 07 Set temporary corner Independent of 1st State

Township 2 South

Range 39 East

Union County, Oregon.

CHAINS. LKS.

Chrisman & Spain

Thence South found no corner for the next 2 miles until I reached the Township line bet Sp 2 & 3 S at the corner to Sec 1=2=35 & 36 at which point I have an excess of 218 lks over U S Field Notes I therefore have a falling of $36\frac{1}{3}$ lks South on each $\frac{1}{2}$ mile
Thence North

161 45 Set Post in Mound of Earth dug Pits & c for Corner to Sec 23=24=25 & 26
Thence North

40 $36\frac{1}{3}$ Set Post in Mound of Earth dug Pits & c for $\frac{1}{4}$ Sec Corner bet Sec 23 & 24
80 $72\frac{2}{3}$ The Corner to Sec 13=14=23 & 24
Thence West var 20° E

39 75 found no $\frac{1}{4}$ Sec. corner

79 50 Set Temporary Corner Independent of 1st Stake
Thence West

40 18 found no $\frac{1}{4}$ Sec corner

80 36 found no Sec corner but at 147 lks further the Corner to Sec 21=22=15 & 16 making an excess of 147 lks over U S Field Notes I therefore have a falling of $36\frac{2}{3}$ lks West to each $\frac{1}{2}$ mile
Thence East

40 54 Set Post in Mound of Earth for $\frac{1}{4}$ Sec Corner bet Sec 15 & 22

-81 08 Set Post in Mnd of Earth for corner to Sec 14=15=22 & 23
Thence East

200 5 $\frac{1}{2}$ Set Post for $\frac{1}{8}$ cor

40 11 Set Post for $\frac{1}{4}$ Sec corner

80 22 The corner to Sec 13=14=23 & 24

The $\frac{1}{4}$ Sec corner bet Sec 23 & 24

Thence West through Sec 23 var 20° E

40 00 Set Temporary center

60 00 Set Temporary $\frac{1}{16}$ corner

80 36 The $\frac{1}{4}$ Sec corner bet Sec 22 & 23

The $\frac{1}{4}$ Sec corner bet Sec 14 & 23

Thence South var $20^{\circ} 15'$ E

20 00 Set Temporary $\frac{1}{16}$ corner

40 00 Set Temporary center

80 50 The $\frac{1}{4}$ Sec corner bet Sec 23 & 24

Township 2 South

Range 39 East

Union County, Oregon.

Chrisman H. Spain
The 1/8 corner on South Bdy S W 1/4 Sec 23
Hence North

- 40 36 Intersect E & W line
- 60 54 Set Stone 6 x 10 x 24 inches for 1/16 corner
- 80 72 The 1/8 corner on North Bdy N W 1/4 Sec 23

The 1/4 Sec corner for Sec 22 & 23
Hence West var 20° E

- 20 50 Set Temporary 1/16 corner
- 40 50 Set Temporary Center Sec 22
- 81 34 Intersect West Boundary Sec 22 5 1/2 miles South of 1/4 Sec corner

The 1/4 Sec corner for Sec 22 & 27
Hence North var 20° E

- 20 50 Set Temporary 1/16 corner
- 40 33 Intersect E & W line 67 1/2 miles West of 1st State for Center
- 80 78 The 1/4 Sec corner for Sec 15 & 22

Hence South

- 60 53 Set Stone 6 x 10 x 20 for 1/16 corner
- 80 78 The 1/4 Sec corner for Sec 22 & 27

The 1/16 corner on West Bdy S E 1/4 Sec 22
Hence East

- 20 50 Set Temporary 1/16 corner
- 40 42 The 1/8 corner on East Bdy S E 1/4 Sec 22

Hence West

- 20 71 Set Stone for 1/16 corner in Center S E 1/4 Sec 22
- 40 42 The 1/16 corner in Center S E 1/4 Sec 22

J. W. Kimbrell Deputy County Surveyor