


Shaw Hutchinson Goodin Allen and Huff Bros. Nov. 12 1887

CHAINS. I.R.S.

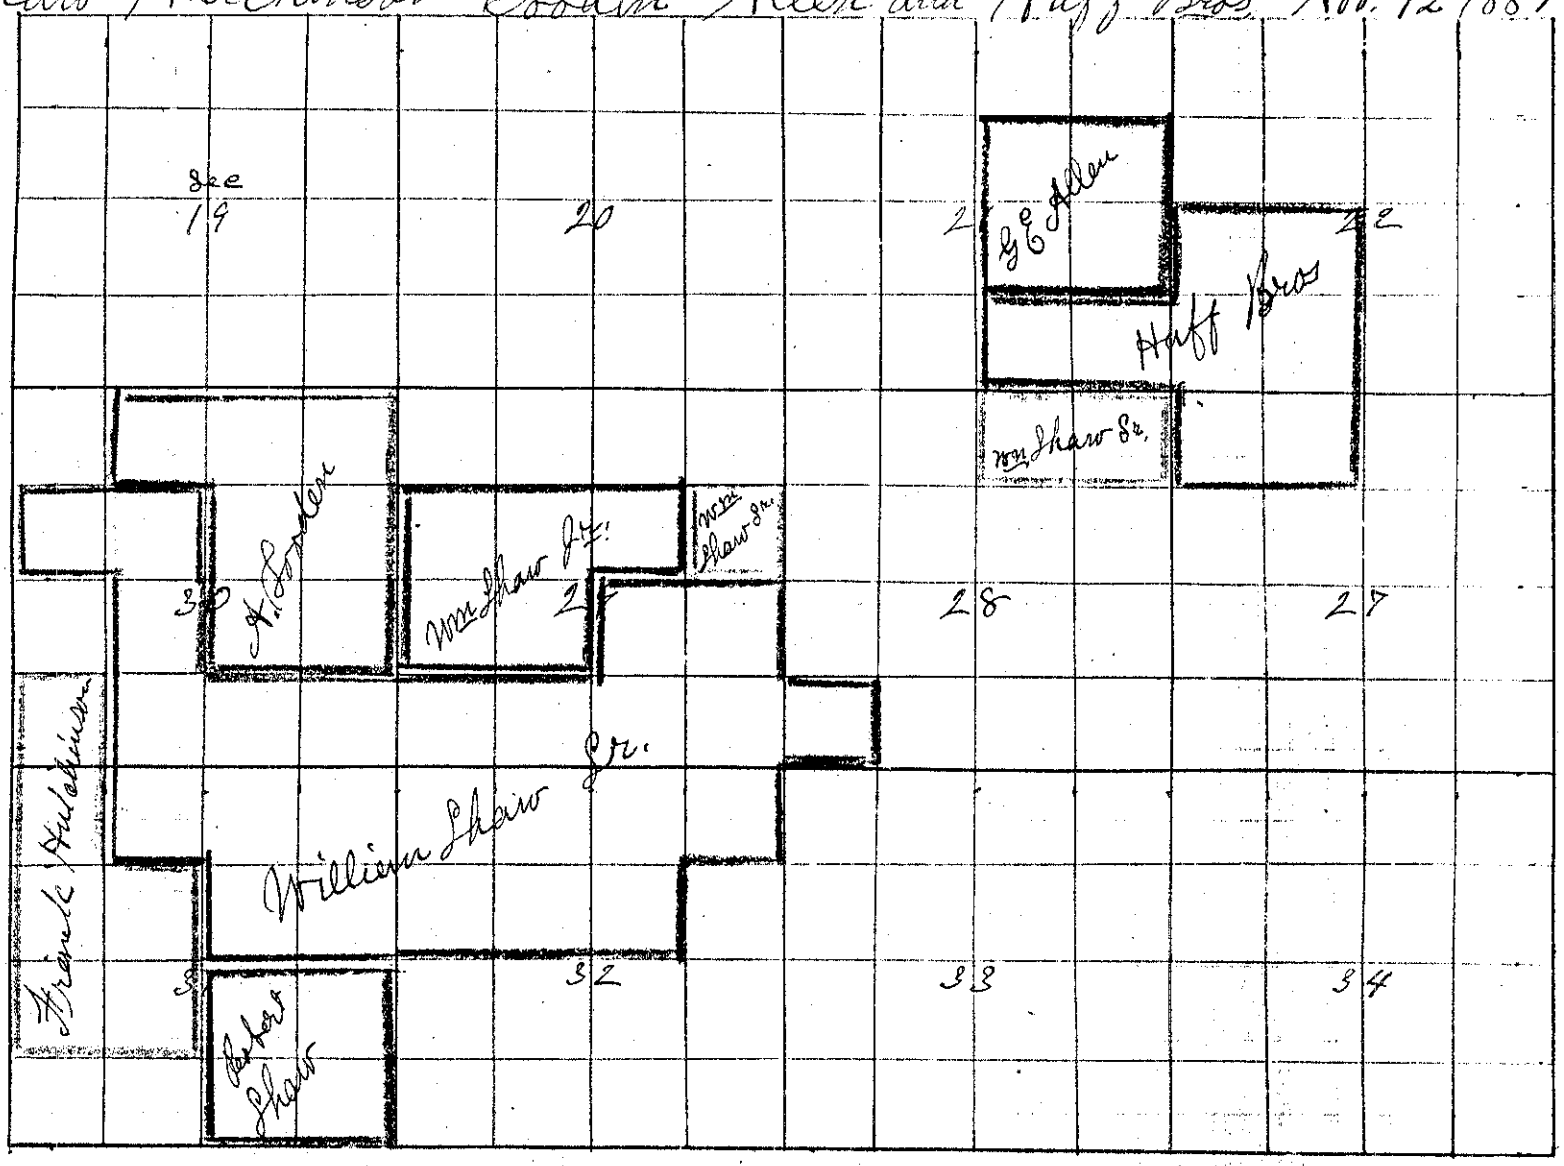

I Commenced at the $\frac{1}{4}$ Sec corner bet Secs ³¹ 22 & ³² 23
 which is a Post in mound of Earth Pile & c.
 Thence North bet Sec 27 & 32 20° E
 40 00 found no Sec corner Set Random Stake
 Thence North
 20 00 Set Temporary $\frac{1}{8}$ corner
 40 00 found no $\frac{1}{4}$ Sec corner Set Temporary $\frac{1}{4}$ Sec.
 60 00 Set Temporary $\frac{1}{8}$ corner
 80 79 the corner to Sec 19 = 20 = 29 & 30 ^{Post in end of Stone} Making an Excess
 of 79 Mts as per US Field notes. I therefore have a falling of
 $13\frac{1}{16}$ Mts North to Each $\frac{1}{4}$ of a mile
 Thence South
 20 13 Set Post for $\frac{1}{8}$ corner
~~40~~ 26 Set Post for $\frac{1}{4}$ Sec corner bet Sec 29 & 30
 60 40 Set Post for $\frac{1}{8}$ corner
 80 53 Set Post in ^{note} edge of Clover ^{2 miles?} Creek for corner to Sec 19 = 20 = 29 & 30
 Thence South
 40 20 the $\frac{1}{4}$ Sec corner bet Sec 31 & 32
 the corner to Sec 19 = 20 = 29 & 30
 Thence west var 20° E
 20 00 Set Temporary $\frac{1}{8}$ corner
 39 85 the $\frac{1}{4}$ Sec corner bet Sec 19 & 30 ^{Post in mound of Stone}
 Thence East on line
 19 92 1/2 Set Post in mound of Stone
 39 85 come to Sec 19 = 20 = 29 & 30

- 20 00 The 1/4 Sec corner bet Sec 19 & 30
Thence South Through Sec 30 var 20° E
- 20 00 Set temporary 1/16 corner
- 70 00 Set temporary Center Sec 30
- 60 50 Set temporary 1/16 corner
- 80 32 Intersect 20' line west of 1/4 Sec corner bet Sec 30 & 31
I therefore have a falling of 5 lks East to each 1/4 of a mile
Thence East var 19° 30' E
- 40 50 Set temporary Corner to Sec 29 = 30 = 31 & 32
Thence East var 10° E
- 40 23 The 1/4 Sec corner bet Sec 29 & 32
Thence west on line
- 40 14 Set Post in west Edge of Clow Creek
Thence west
- 40 08 The 1/4 Sec corner bet Sec 30 & 31
The 1/4 Sec corner bet Sec 29 & 30
Thence west Through Sec 30 var 20° 5' E
- 20 00 Set temporary 1/16 corner
- 40 00 Intersect N & S line at center Sec 3
- 60 50 Set temporary 1/16 corner
- 80 74 Intersect west Boundary at 1/4 Sec corner bet Sec 30 & 25
The 1/4 Sec corner bet Sec 19 & 30
Thence west var 20° E
- 20 00 Set temporary 1/8 corner
- 41 09 The Corner to Sec 19 = 30 = 24 & 25 -
Thence East
- 20 89 Set Post in mound of Stone
Thence south
- 20 08 Set Post in mound of Stone
- 40 13 The 1/16 cor in center of Sec 30
The 1/4 Sec corner bet Sec 30 & 31
Thence west var 20° 15' E
- 20 50 Set temporary 1/8 corner
- 40 60 The corner to Sec 30 = 31 = 25 & 36
Thence East
- 20 65 Set Post in mound of Stone for 1/8 corner
- 40 60 The 1/4 Sec cor bet Sec 30 & 31
The 1/4 Sec corner bet Sec 30 & 25 -
Thence South on Range line bet Sec Ranges 32 & 39 E
- 20 00 Set temporary 1/8 corner
- 40 22 The corner to Sec 30 = 31 = 25 & 36 Thence North
- 20 11 Set Post in mound of Stone
- 40 22 The 1/4 Sec corner bet Sec 30 & 25 -

CHAINS.	LKS.	
		The corner to Sec 30=31=25 & 36 Post in mound of Earth Thence South on Range line bet Sec 31 & 36.
40	20	found no 1/4 Sec corner
80	36	Intersect 36 the west of corner to Sec 31 & 36 T 58 R 38 & 39 E Thence North on range line
20	09	Set Post for 1/8 corner
40	18	Set Post for 1/4 Sec corner bet Sec 31 & 36
60	27	Set Post for 1/8 corner
80	36	The corner to Sec 30=31=25 & 36 The 1/4 Sec corner bet Sec 30 & 31 Thence South through Sec 31
20	00	Set Temporary 1/16 corner
40	00	Set Temporary Center Sec 31
80	36	The 1/4 Sec corner bet Sec 30 & 31 The 1/4 Sec corner bet Sec 31 & 32 Thence West var 20° E
40	70	Intersect N & S line 18 lks South of 1st Mer
80	50	Intersect West Side at 1/4 Sec corner bet Sec 31 & 32 Thence East
20	40	Set Post for 1/16 corner in center NW 1/4 Sec 31 Thence North
20	09	Set Post for 1/16 corner in center NW 1/4 Sec 31 The center Sec 31 Thence North
20	09	Set Post dig pits built mound of Earth & c
40	18	The 1/4 Sec corner bet Sec 30 & 31 The 1/4 Sec corner bet Sec 31 & 32 Thence East var 20° E
40	00	Set Temporary center Sec 32
60	00	Set Temporary 1/16 corner
80	24	The 1/4 Sec corner bet Sec 32 & 33 Thence West
20	06	Set Post for 1/16 corner in center E 1/2 Sec 32 The 1/4 Sec corner bet Sec 32 & 33 Thence North bet Sec 32 & 33 var 20° 5' E
20	00	Set Temporary 1/8 corner
40	00	found no Sec corner Set Temporary Cor to Sec 28=29=32 & 33 Thence North bet Sec 28 & 29 var 20 1/2° E
20	00	Set Temporary 1/8 corner
40	00	Set Temporary 1/4 Sec corner
60	00	Set Temporary 1/8 corner

8104 The corner to Sec 20=21=28 & 29 making 104 lks on US file notes
The falling therefore would be 17 lks North to each 1/4 mile
Thence South

2017 Set Post for 1/8 corner

4014 Set Post for 1/4 Sec corner to Sec 28 & 29

6051 Set Post for 1/8 corner

5058 Set Post for corner to Sec 28=29 32 & 33

Thence South

2017 Set Post for 1/8 corner

4015 The 1/4 Sec corner bet Sec 28 & 29

The 1/8 corner on East Bdy N E 1/4 Sec 32

Thence West - var 20° E

2007 Set Post for 1/16 corner in Center N E 1/4 Sec 32

The corner to Sec 28=29=32 & 33

Thence West var 21° E

4007 The 1/4 Sec corner bet Sec 29 & 32

Thence North through Sec 29 var 20° E

4032 Set Post for center Sec 29

6032 Set Post for 1/16 corner

8063 Intersect West Boundary 33 lks East of 1/4 Sec corner bet Sec 20 & 29

Thence on Line

2015 Set Post for 1/16 corner in center N 1/2 Sec 29

4031 Center Sec 29

Thence East var 20° E

4010 The 1/4 Sec corner bet Sec 28 & 29

Thence West

2005 Set Post for 1/16 corner

Thence North var 20° 10' E

2004 Set Post for 1/16 corner in center N E 1/4 Sec 29

The corner to Sec 20=21=28 & 29

Thence East bet Sec 21 & 28 var 20° E

4017 found no 1/4 Sec corner Set temporary 1/4 Sec

8112 The corner to Sec 21=22=27 & 28

Thence West on line

4056 Set Post in mound of Earth dug pits &c for 1/4 Sec corner

8112 The corner to Sec 20=21=28 & 29

The corner to Sec 21=22=27 & 28

Thence North var 21° E

4010 The 1/4 Sec corner bet Sec 21 & 22 Thence South

2005 Set Post for 1/8 corner

CHAINS	LINKS	
		The 1/4 Sec corner bet Sec 21 & 22
		Thence west through Sec 21 var 20° 30' E
40	55	Set Post for center Sec 21
80	95	The 1/4 Sec corner bet Sec 20 & 21
		The 1/4 Sec corner bet Sec 21 & 28
		Thence north var 20° E
20	00	Set temporary 1/6 corner
40	23	Intersect E & W line at 1 st stake for center
60	23	Set temporary 1/6 corner
80	73	The 1/4 Sec corner bet Sec 17 & 21
		Thence South
20	25	Set Stone in mid of Stone for 1/6 corner in Center 1/6 Sec 21
40	50	Set Post for 1/6 corner in Center Sec 21
60	62 1/2	Set Post for 1/6 corner in Center S 1/2 Sec 21
80	73	The 1/4 Sec corner bet Sec 21 & 28
		Thence South through Sec 28 var 20° E
20	00	Set temporary 1/6 corner
40	00	Set temporary center Sec 28
60	00	Set temporary 1/6 corner
80	15	The 1/4 Sec corner bet Sec 28 & 33
		The 1/4 Sec corner to Sec 28 = 29 = 32 & 33
		Thence East var 21° E
20	00	Set temporary 1/8 corner
40	00	Set temporary 1/4 Sec corner
80	44	The corner to Sec 27 = 28 = 33 & 34
		Thence west
40	22	Set Post for 1/4 Sec corner
60	33	Set Post for 1/8 corner
80	44	The corner to Sec 28 = 29 = 32 & 33
		The corner to Sec 27 = 28 = 33 & 34
		Thence North var 20° E
40	00	Set temporary 1/4 Sec corner
60	50	Set temporary 1/8 corner
79	92	The corner to Sec 21 = 22 = 27 & 28
		Thence South
19	98	Set Post for 1/8 corner dug 1/2 ft. putt round 3/4
39	96	Set stake for 1/4 Sec corner
		Thence west through Sec 28
40	38	The center Sec 28
60	38	Set temporary 1/6 corner
80	74	The 1/4 Sec corner bet Sec 28 & 29

RTIES TO 1/4 78/33
 THEN SETS 1/4 33/33
 what does this
 mean?

Township 5 South

Range 39 East

Union County, Oregon

Thence East on line

2015 Set Post for $\frac{1}{16}$ corner in center $\frac{1}{2}$ Sec 28
Thence South Var 20° E

2015 Set Post for $\frac{1}{16}$ corner in center $\frac{1}{2}$ Sec 28
Thence west

2014 The $\frac{1}{8}$ corner on West Bdy $\frac{1}{4}$ Sec 28
The $\frac{1}{4}$ Sec corner bet Sec 27 & 28
Thence East through Sec 27

4053 Set Temporary center Sec 27

8051 The $\frac{1}{4}$ Sec corner bet Sec 26 & 27

The $\frac{1}{4}$ Sec corner bet Sec 27 & 34

Thence North through Sec 27

4050 Intersect $\frac{1}{2}$ of W line

6050 Set Temporary $\frac{1}{16}$ corner

7985 The $\frac{1}{4}$ Sec corner bet Sec 22 & 27

Thence South Var 20° E

1992 $\frac{1}{2}$ Set Post for $\frac{1}{16}$ corner in center $\frac{1}{2}$ Sec 27

The $\frac{1}{4}$ Sec corner bet Sec 21 & 22

Thence north var 19° E

2050 Set Temporary $\frac{1}{8}$ cor

4032 The corner to Sec 21 = 22 = 18 & 16

Thence South

2016 The $\frac{1}{4}$ Sec corner bet Sec 21 & 22 in Mound of Stone for $\frac{1}{8}$ cor

John H. Hill & J. C. County Surveyor