


Township 7 South

Range 41 East N.M.

Union County, Oregon.

H.H. Briggs & Castle of Henry Colwell March the 24 1888

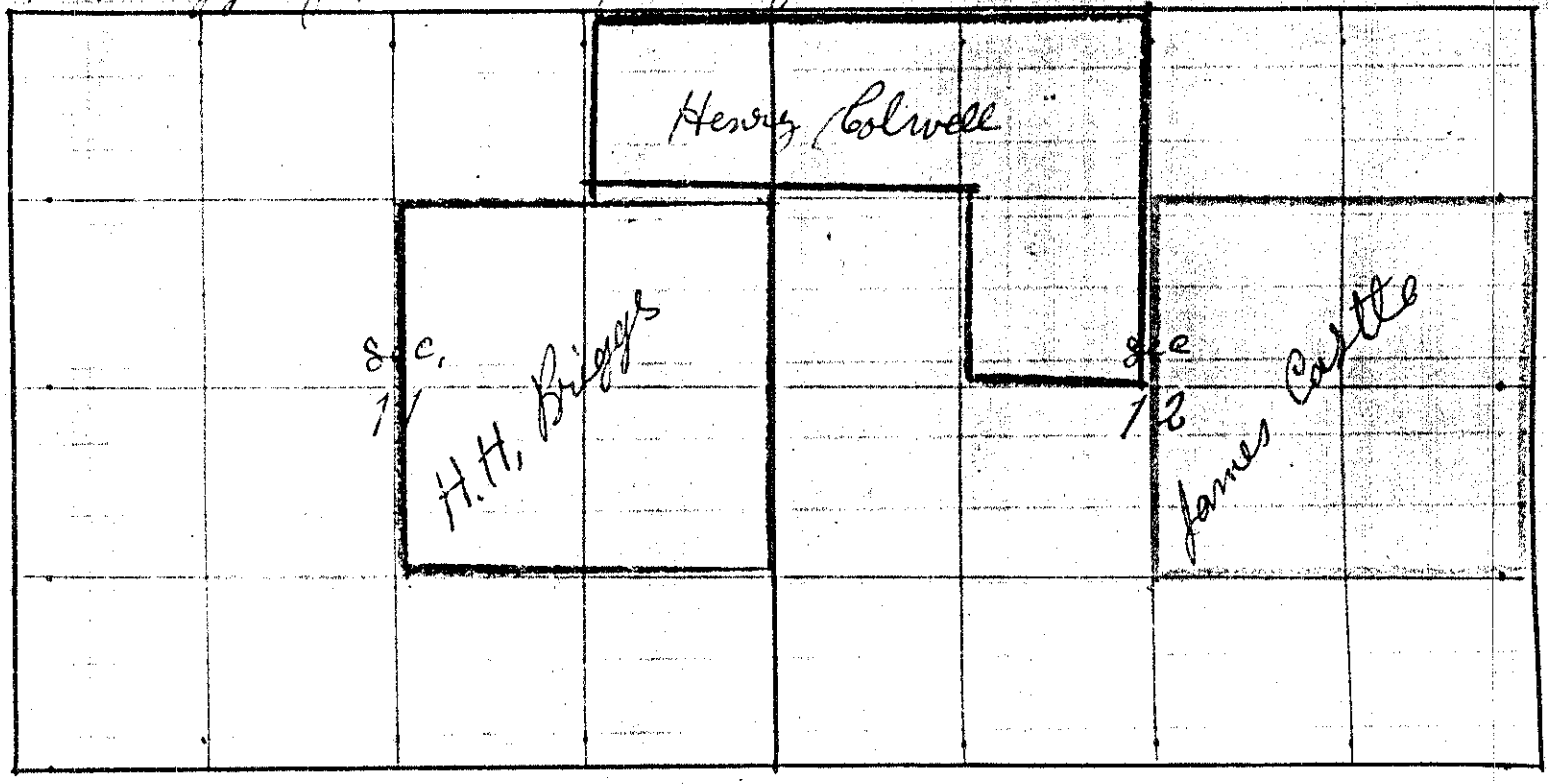

I Commenced at the corner to Sec 1=2=11 & 12

Hence South bet Sec 1 & 12 (var 20° E

50 15 Intersect E & W line 17 lks west of corner to Sec 11=12=13 & 14
Hence N 7° W on true line

20 03 Set Post for 1/8 corne

40 07 Set Post dug pits E & W and built mound for 1/4 Sec cor

60 11 Set Post dug pits of c for 1/8 cor

80 15 The corner to Sec 1=2=11 & 12

The corner to Sec 11=12=13 & 14

Hence West bet Sec 11 & 14 (var 20° E

39 60 Found no 1/4 Sec corner Set temporary 1/4 Sec

79 21 The corner to Sec 10=11=14 & 15

Hence East

Set Post dug pits N & S built mound of Earth for 1/4 Sec

Hence North (var 20° E

40 00 temporary 1/8 corner

40 02 temporary center

60 50 temporary 1/8 corner

80 11 The 1/4 Sec corner bet Sec 2 & 11

The 1/4 Sec corner bet Sec 11 & 12

Hence West Through Sec 11 (var 20° E

39 70 Intersect N & S line 5 lks North of 1st State

79 45 Intersect West Bdy Sec 11 at a point for 1/4 Sec corner bet Sec 10 & 11
determined by running a N & S line from

The corner to Sec 2=3=10 & 11

Hence South (var 21° E

80 24 The corner to Sec 10=11=14 & 15 Hence North

40 12 The point of Intersection for 1/4 Sec cor bet Sec 10 & 11