


Township 6 South

Range 38 East W M

Union County, Oregon.

Sarah E. Sharenhousen April 17 1888

CHAINS. LKS.

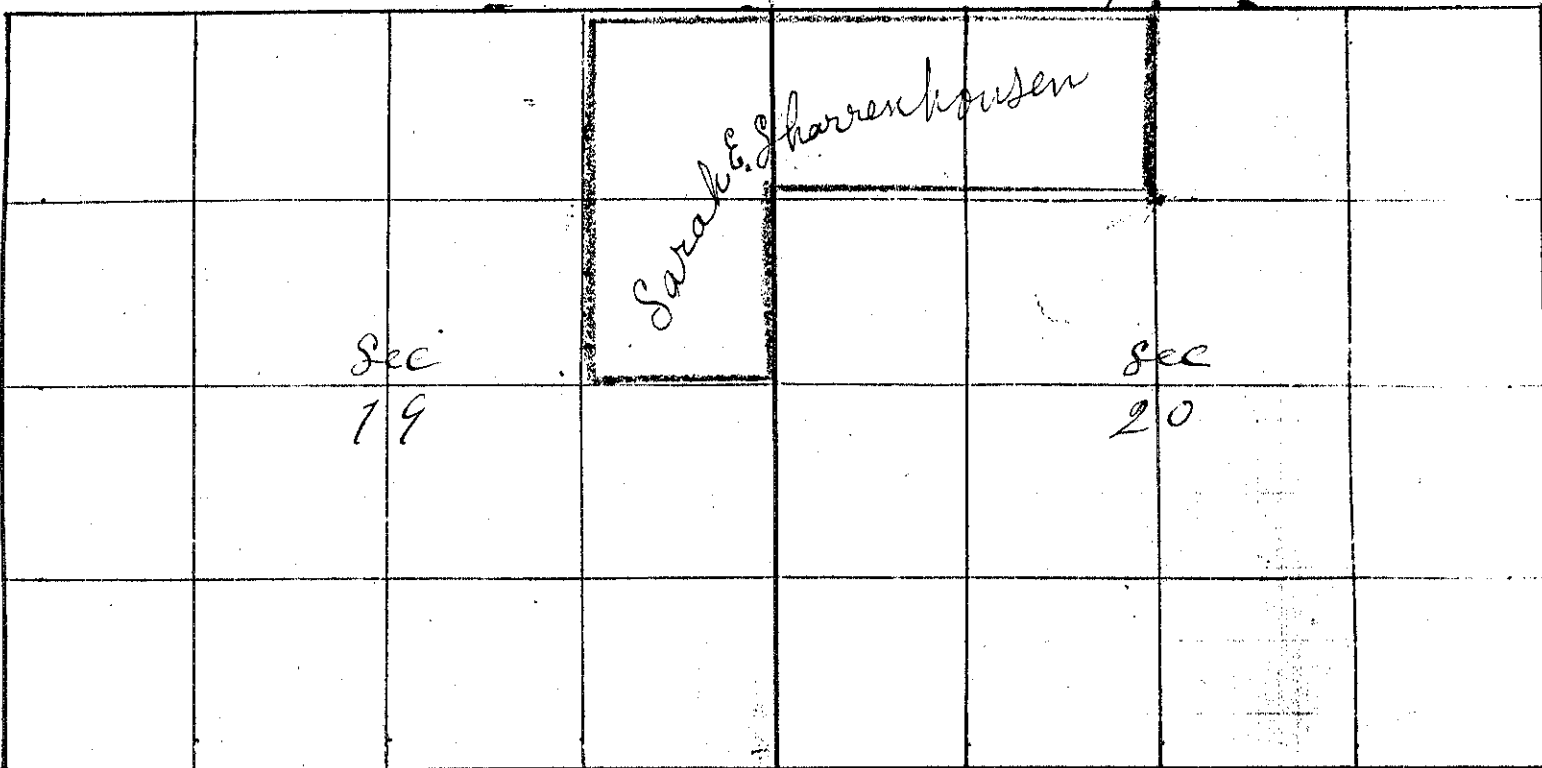

I Commenced at The 1/4 Sec corner bet Sec 17 & 20
 a Post in Mound of Rock
 Thence West var 20° E

20 00 Set Temporary 1/8 corner

40 23 Intersect N of S line 278 lks North of corner to Sec 17-18-19 & 20
 N 84° E on True line

20 11 1/2 Set Post for 1/8 corner from which
 a Fir 16 inches diameter lies N 82° 30' E 119 lks distant
 a Pine 14 " " " S 8° 45' W 130 " "

21 00 North Powder River 50 lks wide Course South

40 23 The 1/4 Sec corner bet Sec 17 & 20
 The corner to Sec 17-18-19 & 20
 Thence South var 20° E

40 32 The 1/4 Sec corner bet Sec 19 & 20
 Thence North

20 16 Set Post for 1/8 corner

40 82 The corner to Sec 17-18-19 & 20
 Thence West var 20° E

20 16 The 1/8 corner
 Thence South

39 60 Marked a Sawrack Tree 14 inches diameter.
 Thence East

20 00 To 1/4 Sec corner bet Sec 19 & 20
 The 1/4 Sec corner bet Sec 20 & 21 Thence North var 20° E

39 54 The corner to Sec 16-17-20 & 21 Thence South

19 77 Set Post in mound of Stone for 1/8 corner Thence West var 20° E

30 36 Set 1/8 corner on wet boundary N of Sec 20 Thence East

40 18 Set Stone 6x8x17 inch 10 inches in the ground for 1/8 corner from which
 a Pine 20 in diam bears S 71° 15' W 100 lks distant Thence west on line

20 09 Set Post from
 " 15 " " " N 12° 45' W 78 " "
 " 12 " " " S 37° W 8 lks W. Fairbairn Sept Co. Surveyors