


Township 4 South

Ranges 40 and 41 East W 16 Union County, Oregon.

G W & M P Ames and Wm H. Porter April 19 1888

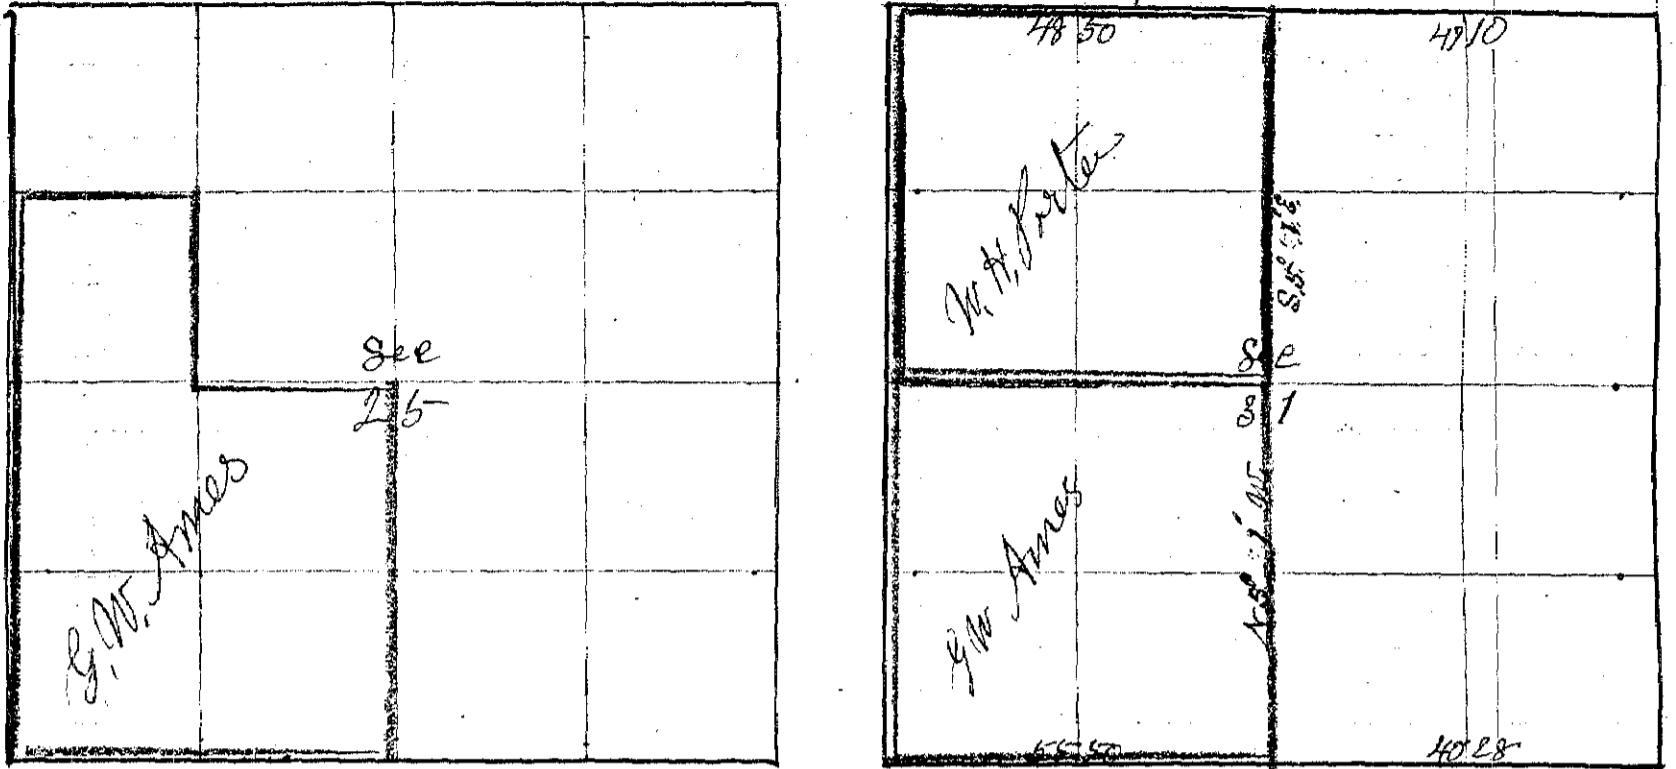

I Commenced at the corner to Sec. 30=31=25 & 36 on Range line bet Ranges 40 & 41 T 4 South a stone in mound of Stone
Thence East (var 19° 55' E

- 41 40 found no 1/4 Sec corner Set temporary 1/4 Sec Post
- 95 60 Intersect N & S line 46 lks North of corner to Sec 29=30=31 & 32
N. 87° 40' W on true line bet Sec 30 & 31
- 47 10 Set Post built mound of Stone for 1/4 Sec corner from which
a Pine 4 inches dia. bears N 6° 15' W 35 lks dist.
- " 12 " " " S 2° E 100 " "
- 95 60 The corner to Sec 30=31=25 & 36

The corner to Sec 5=6=31 & 32 a Stone in mid of Stone
Thence North bet Sec 31 & 32 var 20° E

- 41 27 The 1/4 Sec corner bet Sec 31 & 32 a stone in mound of Stone
- 79 92 The corner to Sec 29=30=31 & 32

The Corner to Sec 5=6=31 & 32

Thence West bet Sec 6 & 31 var 20° E

- 40 28 The 1/4 Sec corner bet Sec 6 & 31
- 95 78 The corner to Sec 1=6=31 & 36 a Stone in mid. of Stone
which is also the corner to T 34 & 35 S R 40 & 41 East

Thence North bet Sec 31 & 36 var 19° 45' E

- 40 50 found no 1/4 Sec corner Set temporary 1/4 Sec Post
- 79 60 The corner to Sec 30=31=25 & 36

Thence South on Range line.

- 39 80 Set Stone 6 x 10 x 18 in for 1/4 Sec cor in mound of Stone
The

RECORD OF SURVEY

Township 4 South

Range 40 & 41 East

Union County, Oregon.

CHAINS. LKS.

The 1/4 Sec corner bet Sec 30 & 31

Thence South through Sec 31 S 5° E var 20° E

40 00 Set temporary center Sec 31

80 00 Intersect E & W line 110 lks west of 1/4 Sec cor

Thence N 5° 1' W on true line

40 00 Set Post for center Sec 31

80 00 The 1/4 Sec corner bet Sec 30 & 31

The 1/4 Sec corner bet Sec 25 & 30 on Range line

Thence West through Sec 25 - var 20° E

40 00 Set Temporary center Sec 25 -

60 00 Set Temporary 1/16 corner West of this point is inaccessible on account of High Cliff of Rock

The 1/4 Sec cor bet Sec 25 & 36

Thence North through Sec 25 - var 20° E

41 53 Intersect E & W line 20 lks East of 1st Temporary Stake

61 53 Set Temporary 1/16 cor

81 53 Intersect E & W line but found no 1/4 Sec corner

I therefore proceeded to the corner to Sec 19 = 30 = 24 & 25 -

on Range line a stone in mound of Stone

Thence West bet Sec 24 & 25 - var 20° E

39 71 Set Temporary 1/4 Sec Post

79 42 found no Sec corner Set temporary Post

Thence West

40 10 found no 1/4 Sec cor

40 66 The 1/4 Sec corner bet Sec 23 & 26 a Stone in mound of Stone

Thence East

40 23 Set Stone 6 x 12 x 24 for corner to Sec 23 = 24 = 25 & 26

Thence East

39 84 Set Stone 6 x 10 x 20 in for 1/4 Sec corner

79 68 The corner to Sec 24 = 25 = 19 & 30

The corner to Sec 23 = 24 = 25 & 26 Thence South var 20° E

39 93 The 1/4 Sec corner bet Sec 25 & 26 a Stone in mound of Stone

Thence North

19 97 Set Stone in mound of Stone ^{to lks W} Thence East

20 00 Set Stone for 1/16 corner Thence South

19 96 Set Stone for 1/16 cor in center N. W. 1/4 Sec 25 -

J. W. Kempf Deputy