


Township 5 South Range 40 East W.M. Union County, Oregon.

S. A. Pursel J. L. Lee W Titus & Jas Haynes May 2nd 1888

CHAINS
LRS.

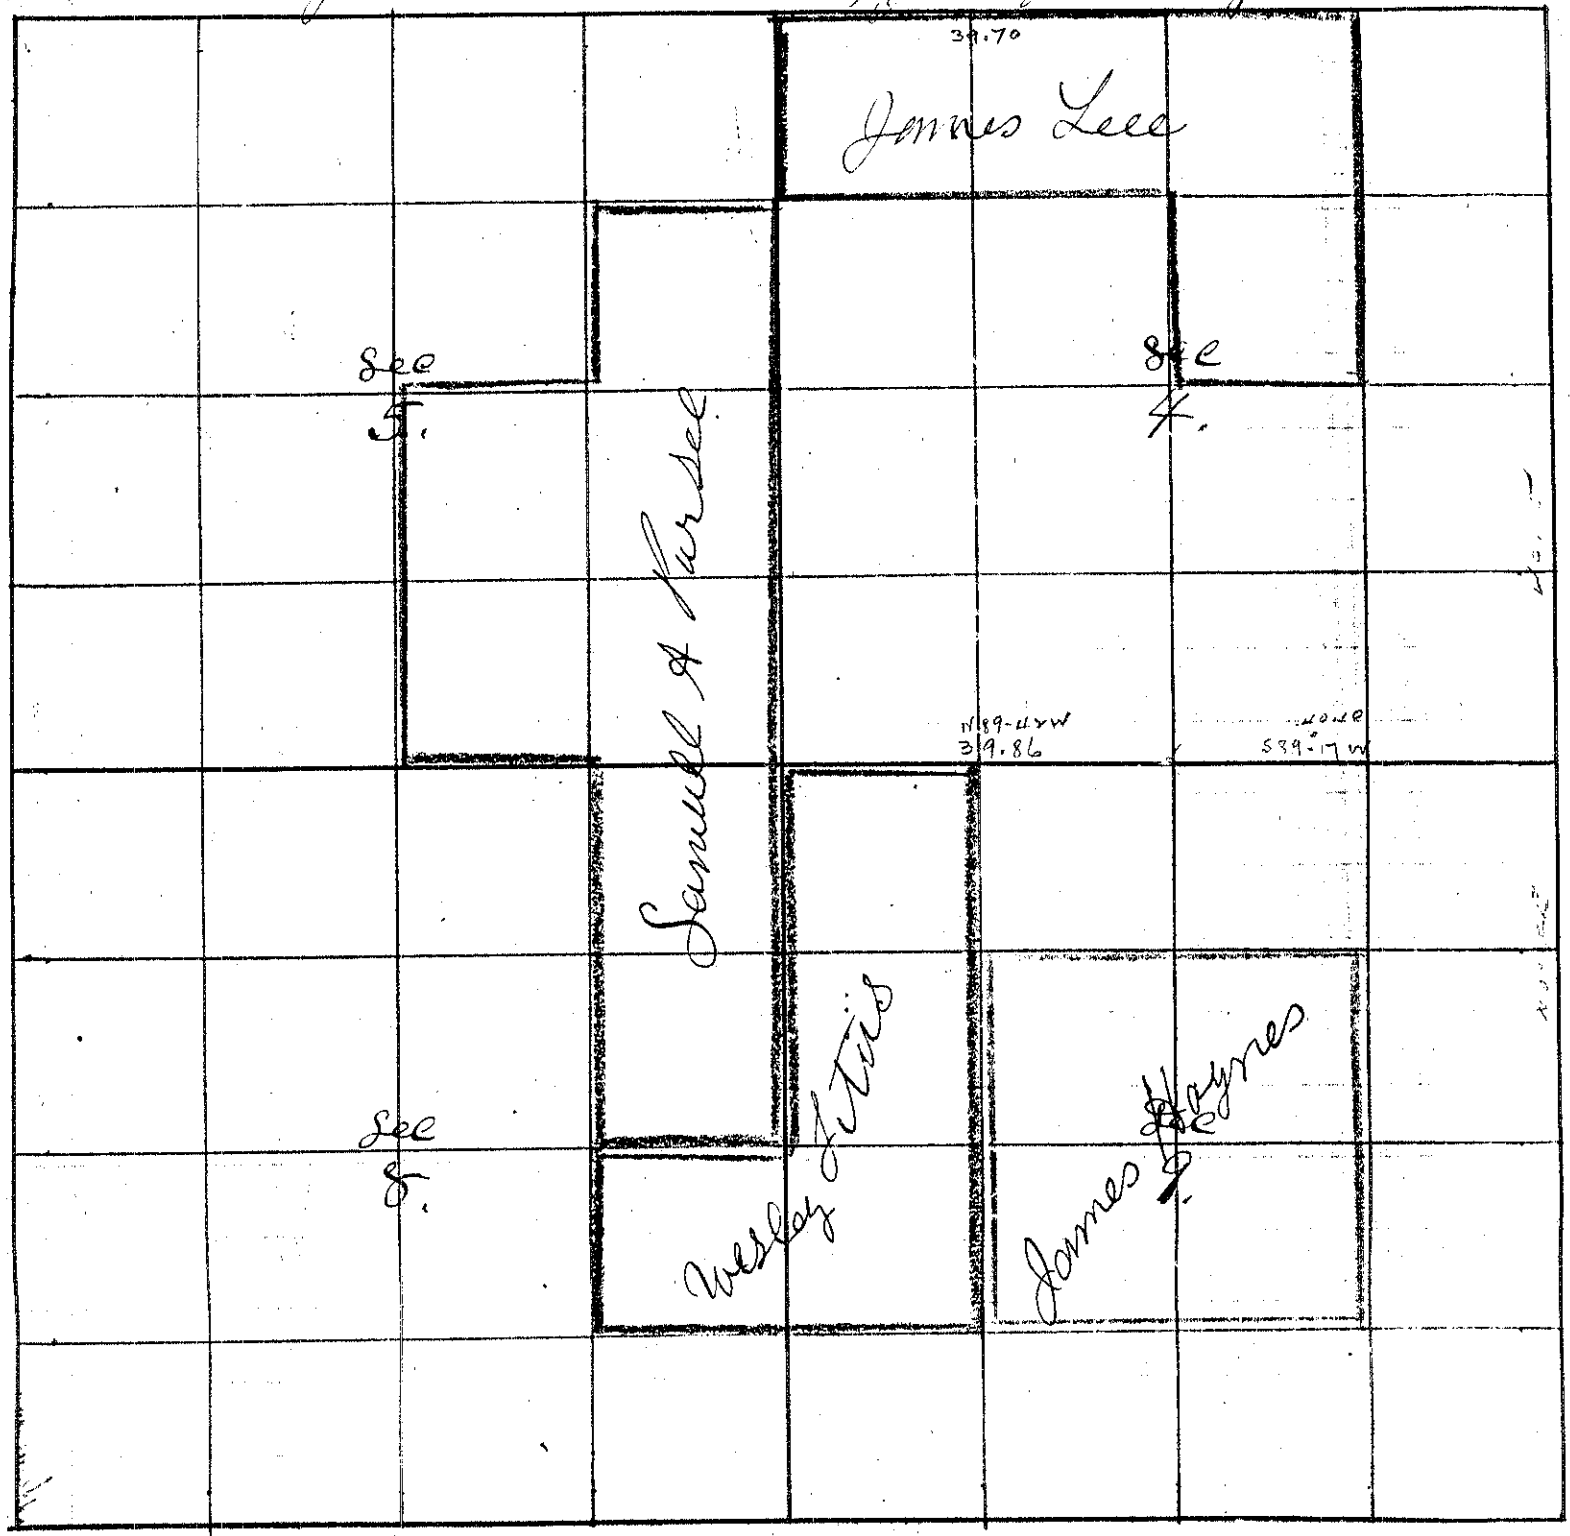

I Commenced at the corner to Sec 4=5=8 & 9 which is a Post in bed of Stone
Thence East Var 20° E

- 20 00 Set temporary 1/8 cor.
- 39 86 Intersect 20 lks north of 1/4 Sec cor bet Sec 4 & 9
Thence N 89° 42' W on true line
- 19 93 Set Post in Mound of Stone for 1/8 cor.
- 39 86 The corner to Sec 4=5=8 & 9
The 1/4 Sec cor bet Sec 4 & 9
Thence East Var 20° 15' E
- 20 00 Set temporary 1/8 cor
- 40 10 Intersect 50 lks South of corner to Sec 8=4=9 & 10
S 89° 17' W on true line
- 20 05 Set Post in Mound of Stone for 1/8 cor
- 40 10 The 1/4 Sec cor bet Sec 4 & 9
The corner to Sec 8=4=9 & 10
Thence South
- 40 15 Intersect 10 lks East of 1/4 Sec cor bet Sec 9 & 10
N 9° E on true line
- 20 07 Set Post in Mound of Stone for 1/8 cor

- 40 15 The 1/4 Sec cor bet Sec 9 & 10 Thence North 20° E
- 20 07 The corner to Sec 9=10=15 & 16 Thence North
- Set Post in mound of Stone for 1/8 cor

- 40 12 The Corner to Sec 9=10=15 & 16 Thence West 20° E
- Intersect 32 lks North of 1/4 Sec cor bet Sec 9 & 16
- Thence N $89^{\circ} 33'$ E on true line
- 20 56 Set Post for 1/8 cor

- 40 12 The 1/4 Sec corner bet Sec 9 & 16 Thence West $19^{\circ} 30'$ E
- Intersect N. H. S. line 7 lks South of corner to Sec 8=9=16 & 17
- $S 89^{\circ} 54'$ East on true line
- 20 00 Set Post for 1/8 corner

- 20 50 The corner to Sec 8=9=16 & 17 Thence North 20° E
- Set temporary 1/8 cor
- 40 50 found old 1/4 Sec cor Set temporary 1/4 Sec
- 00 50 Set temporary 1/8 cor
- 30 27 The corner to Sec 4=5=8 & 9
- Thence South on line
- 20 07 Set Post for 1/8 cor
- 40 14 Planted a Stone 6 x 12 x 22 in marked 1/4 on East face of 1/4 Sec 8 & 9
- 60 20 Set Post in mound of Stone for 1/8 corner -
- Thence West
- 20 50 Drove Stake for temporary 1/6 cor in crite S E 1/4 Sec 8

- The 1/4 Sec corner bet Sec 8 & 9
- Thence East through Sec 9 20° E
- 20 50 Set temporary 1/6 corner
- 40 50 Set temporary center Sec 9
- 30 50 Set temporary 1/6 corner
- 30 20 The 1/4 Sec cor bet Sec 9 & 10
- The 1/4 Sec cor bet Sec 4 & 9
- Thence South 20° E
- 20 50 Set temporary 1/6 cor
- 39 60 Intersect E & W line
- 59 60 Set temporary 1/6 cor
- 79 40 The 1/4 Sec cor bet Sec 9 & 16
- Thence North
- 19 90 Set Post for 1/6 cor crite S 1/2 Sec 9
- 39 80 Center Sec 9
- 59 60 Set Post for 1/6 cor in crite N 1/2 Sec 9 Thence West -
- 20 00 Set Post for 1/6 cor crite NW 1/4 Sec 9

CHAINS. LRS.

Here center S 1/2 Sec 9
Thence West

20 07 Set Post for 1/16 em in center S W 1/4 Sec 9

Here center N 1/2 Sec 9
Thence East

20 07 Set Post for 1/16 em in center N E 1/4 Sec 9

Thence South

19 93 Set Post for 1/16 em in center E 1/2 Sec 9

Thence South

20 07 Set Post in mound of Stone for 1/16 em in center S E 1/4 Sec 9

The corner to Sec 8 = 9 = 4 & 5

Thence West var 20° E

20 00 Set temporary 1/8 corner

40 17 The 1/4 Sec corner bet Sec 5 & 8 Thence East

20 08 1/2 Set Post for 1/8 em

40 17 The em to Sec 4 = 5 = 8 & 9

The 1/4 Sec corner bet Sec 5 & 8

Thence South through Sec 8 var 20° E

40 00 Set temporary center Sec 8

80 35 The 1/4 Sec em bet Sec 9 & 16

Thence East var 20° E

40 40 The corner to Sec 8 = 9 = 15 & 16 Thence West

20 20 Set Post for 1/8 em

The 1/4 Sec em bet Sec 8 & 9

Thence West through Sec 8 var 20° E

20 00 Set temporary 1/16 em

40 20 Set Post in mound of Stone for center Sec 8

Thence East

20 10 Set Post in mound of Stone for 1/16 em in center S 1/2 Sec 8

The 1/4 Sec corner bet Sec 5 & 8

Thence North through Sec 5 - var 20° E

40 00 Set temporary center Sec 5

80 83 The 1/4 Sec corner on North Boundary Sec 5 -

Thence South

40 41 Set Post in mound of Stone for center Sec 5 -

The 1/4 Sec corner bet Sec 5 & 32

Thence East bet Sec 5 & 32, var 20° E

40 00 found no corner Set temporary cor for Sec 4 = 5 = 8 & 35

Thence East

39 40 The 1/4 Sec corner bet Sec 4 & 33

Township 5 South

Range 40 East W.M.

Union County, Oregon.

CHAINS	LINKS	DESCRIPTION
39	70	Thence west on Township line Set Stone 6 x 10 x 23 for corner to Sec 4 = 5 = 32 & 33
		The corner to Sec 3 = 4 = 33 & 34 on Sp line Thence South per 20° E
40	45	found no 1/4 Sec corner
80	75	Intersect 4 lks East of corner to Sec 3 = 4 = 9 & 10 Thence North on line
40	15	Set Post in mound of Stone for 1/4 Sec on lot Sec 3 & 4 Thence west through Sec 4 per 20° E
20	50	Set temporary 1/6 on
40	50	Set temporary center Sec 4
74	97	Intersect at the West Boundary Sec 4 but found no 1/4 Sec corner and proceed to the corner to Sec 4 = 5 = 8 & 9 and run North Set Sec 4 & 5 per 20° E
40	50	Set temporary 1/4 Sec corner
80	27	The corner to Sec 4 = 5 = 32 & 33 Thence South
20	33	Set Post for 1/8 corner
40	31	Set Stone 6 x 8 x 24 in for 1/4 Sec on
80	27	The corner to Sec 4 = 5 = 8 & 9 The 1/4 Sec corner set Sec 4 & 5 - Thence west per 20° E
39	90	Then center Sec 5 Set Post in mound of Stone

W. Kimball Deputy County Surveyor