


Township 8 South Range 46 East W.M. Union County, Oregon.

Q. Gaylord A. K. Leep, J. N. Proffer, Chas Hainey & Jack Morrison June 21 1888

CHAINS LRS.

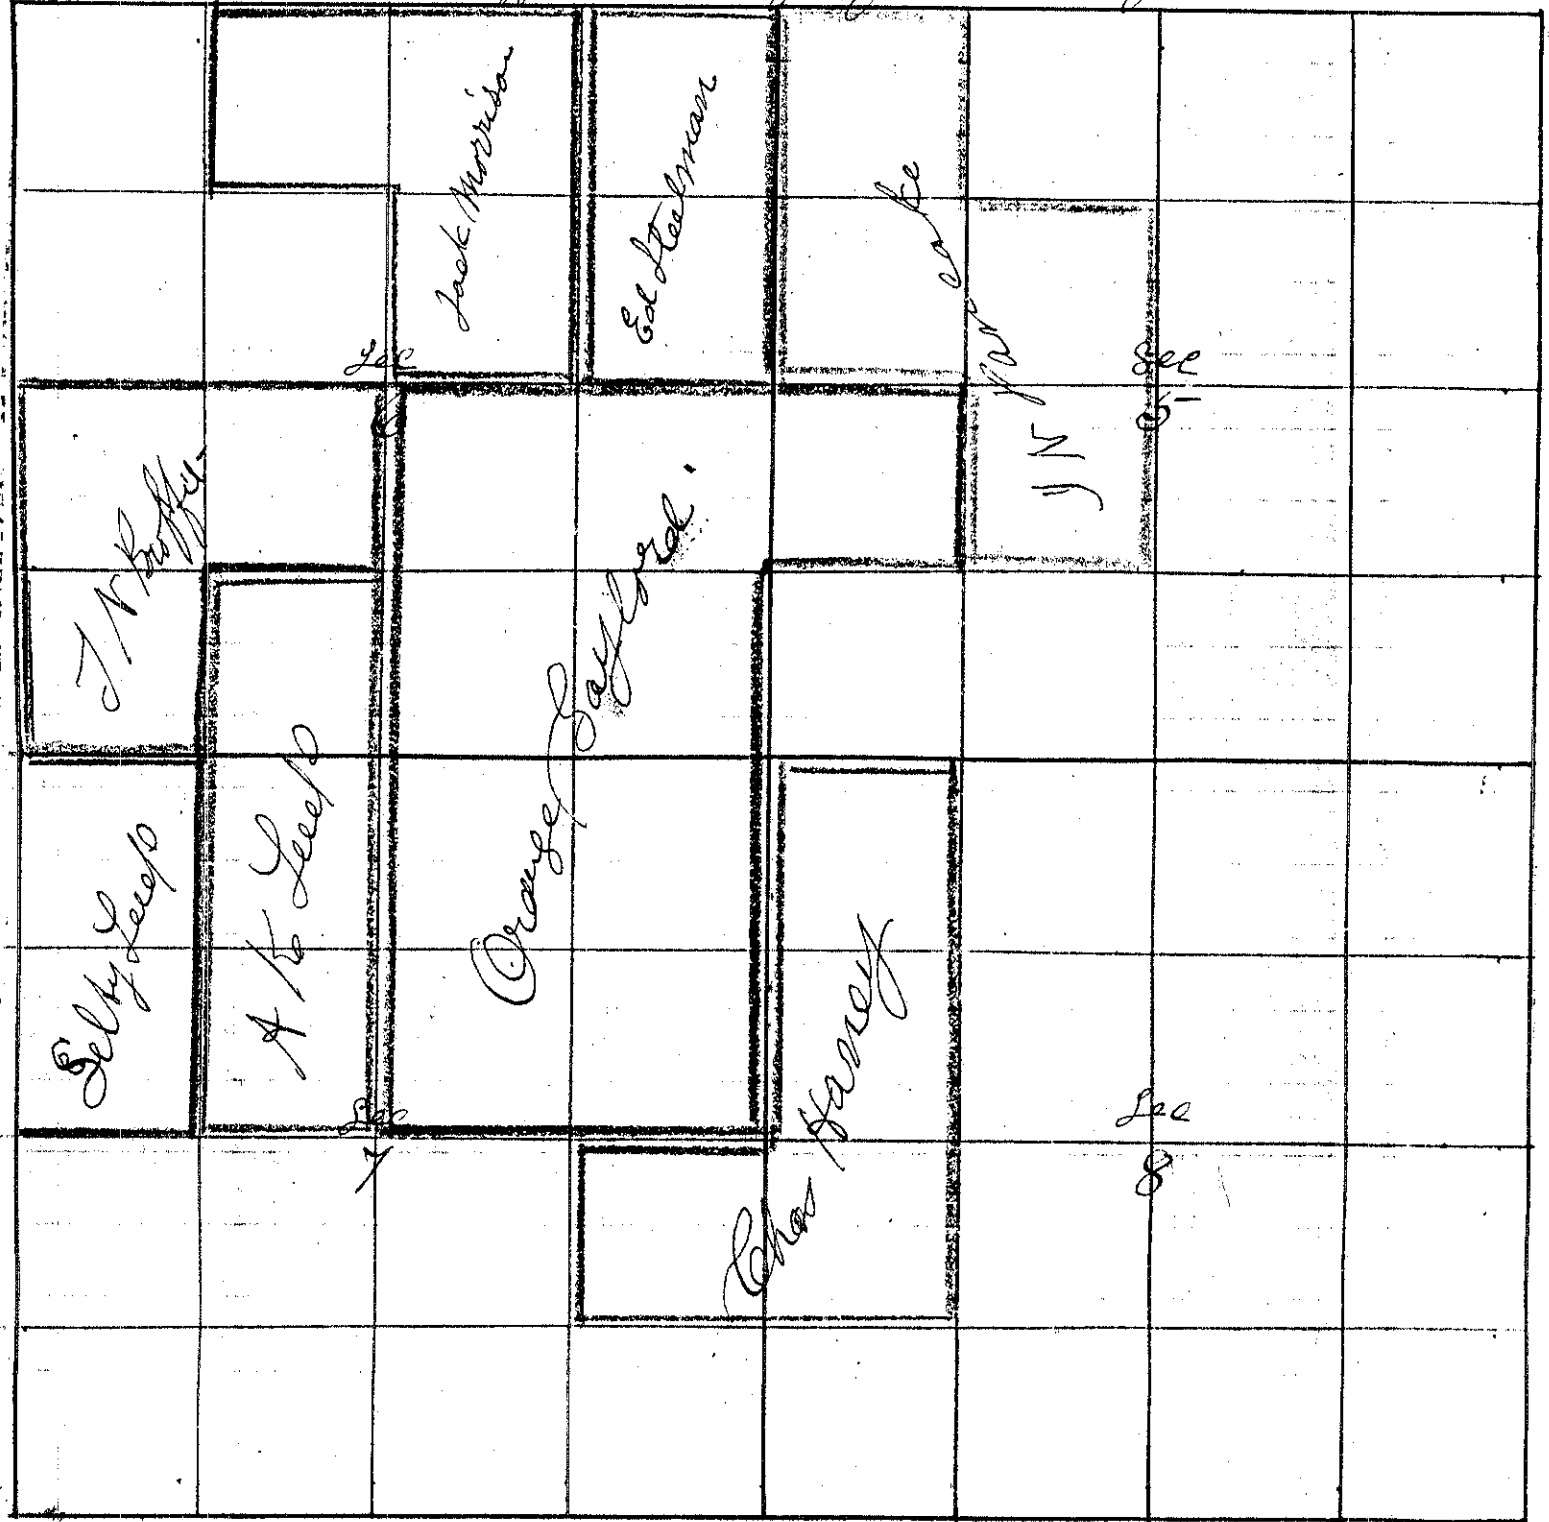

I commenced by Reestablishing the corner to Sec 6=7=12/13
 The Post being gone and the witness tree was gone but I
 found the old stump marked very plain B.T.

U.S. Field Notes. The corner to Sec 6=7=12/13
 a Post from which
 a Cottonwood 5 inch dia. brs. N 80° E 275 lks dist.

I planted a Post 4 feet long and 4 inch square Bull Manner
 dug pits N & S & NW & SW from Post from which I marked
 an asp 3 inch dia brs N 48° E 102 lks dist.
 an " 5 " " " S 24° W 77 " "

40 00 Thence South bet Sec 7 & 12 var 20° E
 80 36 found no 1/4 sec corner Set temporary 1/4 Sec
 The corner to Sec 7=12=13 & 13

40 18 Thence North on Range line
 80 36 Set Stone 6 x 7 = 23 inches for 1/4 sec cor. bet Sec 7 & 12
 The corner to Sec 6=7=12/13

40 00 Thence North bet Sec 1 & 6 var 20° E
 79 82 found no 1/4 sec corner Set temporary 1/4 sec
 Intersect 125 lks East of corner to Sec 6=7=12/13