


Township 5 South Range 40 East N.M. Union County, Oregon.

C. E. Roffins Aug 15 1888

CHAINS. LKS.

I commenced at the cor.
To Sec 2=3=10 & 11 a stone
from which
a Pine 16 inches dia. N 60° W 32 lks dist-
" 16 " " N 50° E 135 " "
a " 20 " " S 53° W 295 " "

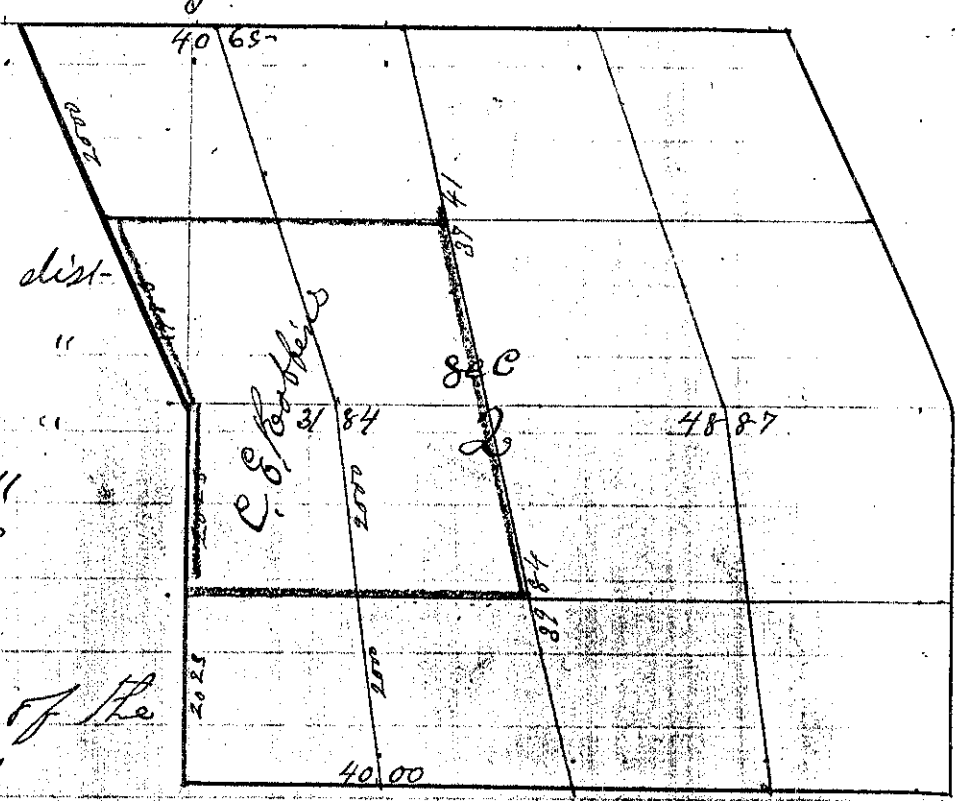

Thence East bet Sec 2 & 11
var 20° E

20 00 Set Temporary 1/8 corner
40 00 Intersect 100 lks South of the
1/4 Sec corner bet Sec 2 & 11

from which
a Pine 8 inches dia. N. 65° W. 100 lks distant
Thence S 88° 34' W on true line

20 00 Set Post for 1/8 corner
40 00 The corner to Sec 2=3=10 & 11

The 1/4 Sec corner bet Sec 2 & 11
Thence North 12° West
var 20° E

15 00 Road E & W
18 00 Catherine Creek 100 lks wide runs West
20 00 Set Temporary 1/16 corner on South side of track near N.W. cor.
of the Old Holbrook Mill
21 00 ascend South Slope of Ridge
40 00 Set Temporary Center Sec 2
77 25 Intersect North Boundary 50 lks East of 1/4 Sec cor. bet Sec 2 & 35 -
Thence S 72° 39' E on true line

The 1/4 Sec corner bet Sec 2 & 35 -
Thence West.

40 65 The corner to Sec 2=3=34 & 35 -
Thence S 22 1/2° E bet Sec 2 & 3
var 20° E

20 16 Set Temporary 1/8 corner
39 85 The 1/4 Sec corner bet Sec 2 & 3
Thence North 22 1/2° W

19 85 Set Post in Mound of Stone for 1/8 cor
39 85 The corner to Sec 2=3=34 & 35 -

Township 5 South

Range 40 East

Union County, Oregon.

CHAINS
LINKS

The 1/4 Sec corner bet Sec 2 & 3
Hence South var 20° E

20 00 Set temporary 1/8 corner

40 46 The corner to Sec 2-3-10 & 11
Hence North

20 23 Set Post in Mound of Stone for 1/8 corner

40 46 The 1/4 Sec corner bet Sec 2 & 3
Hence East through Sec 2
var 20° E

37 84 Intersect true N & S line 16 lks south of 1st state for center

30 71 The 1/4 Sec corner bet Sec 1 & 2
Hence West

48 87 Set Stone 6 x 8 x 24 in Mound of Stone for Center Sec 2

30 71 The 1/4 Sec corner bet Sec 2 & 3

The 1/8 corner on South Boundary SW 1/4 Sec 2
Hence North 9° W var 20° E

20 00 Set temporary 1/16 corner

40 00 The 1/16 corner point in center NW 1/4 Sec 2
Hence South

20 00 Set Stone in Mound of Stone for 1/16 corner in center SW 1/4 Sec 2

J. W. Kimbrell County Surveyor