

50
1888

RECORD OF SURVEY

No. 46

Township 8 South


Range 42 East W.M.

Union County, Oregon.

Jack Sturgill

Sept. the 2nd 1888

CHAINS. F.S.

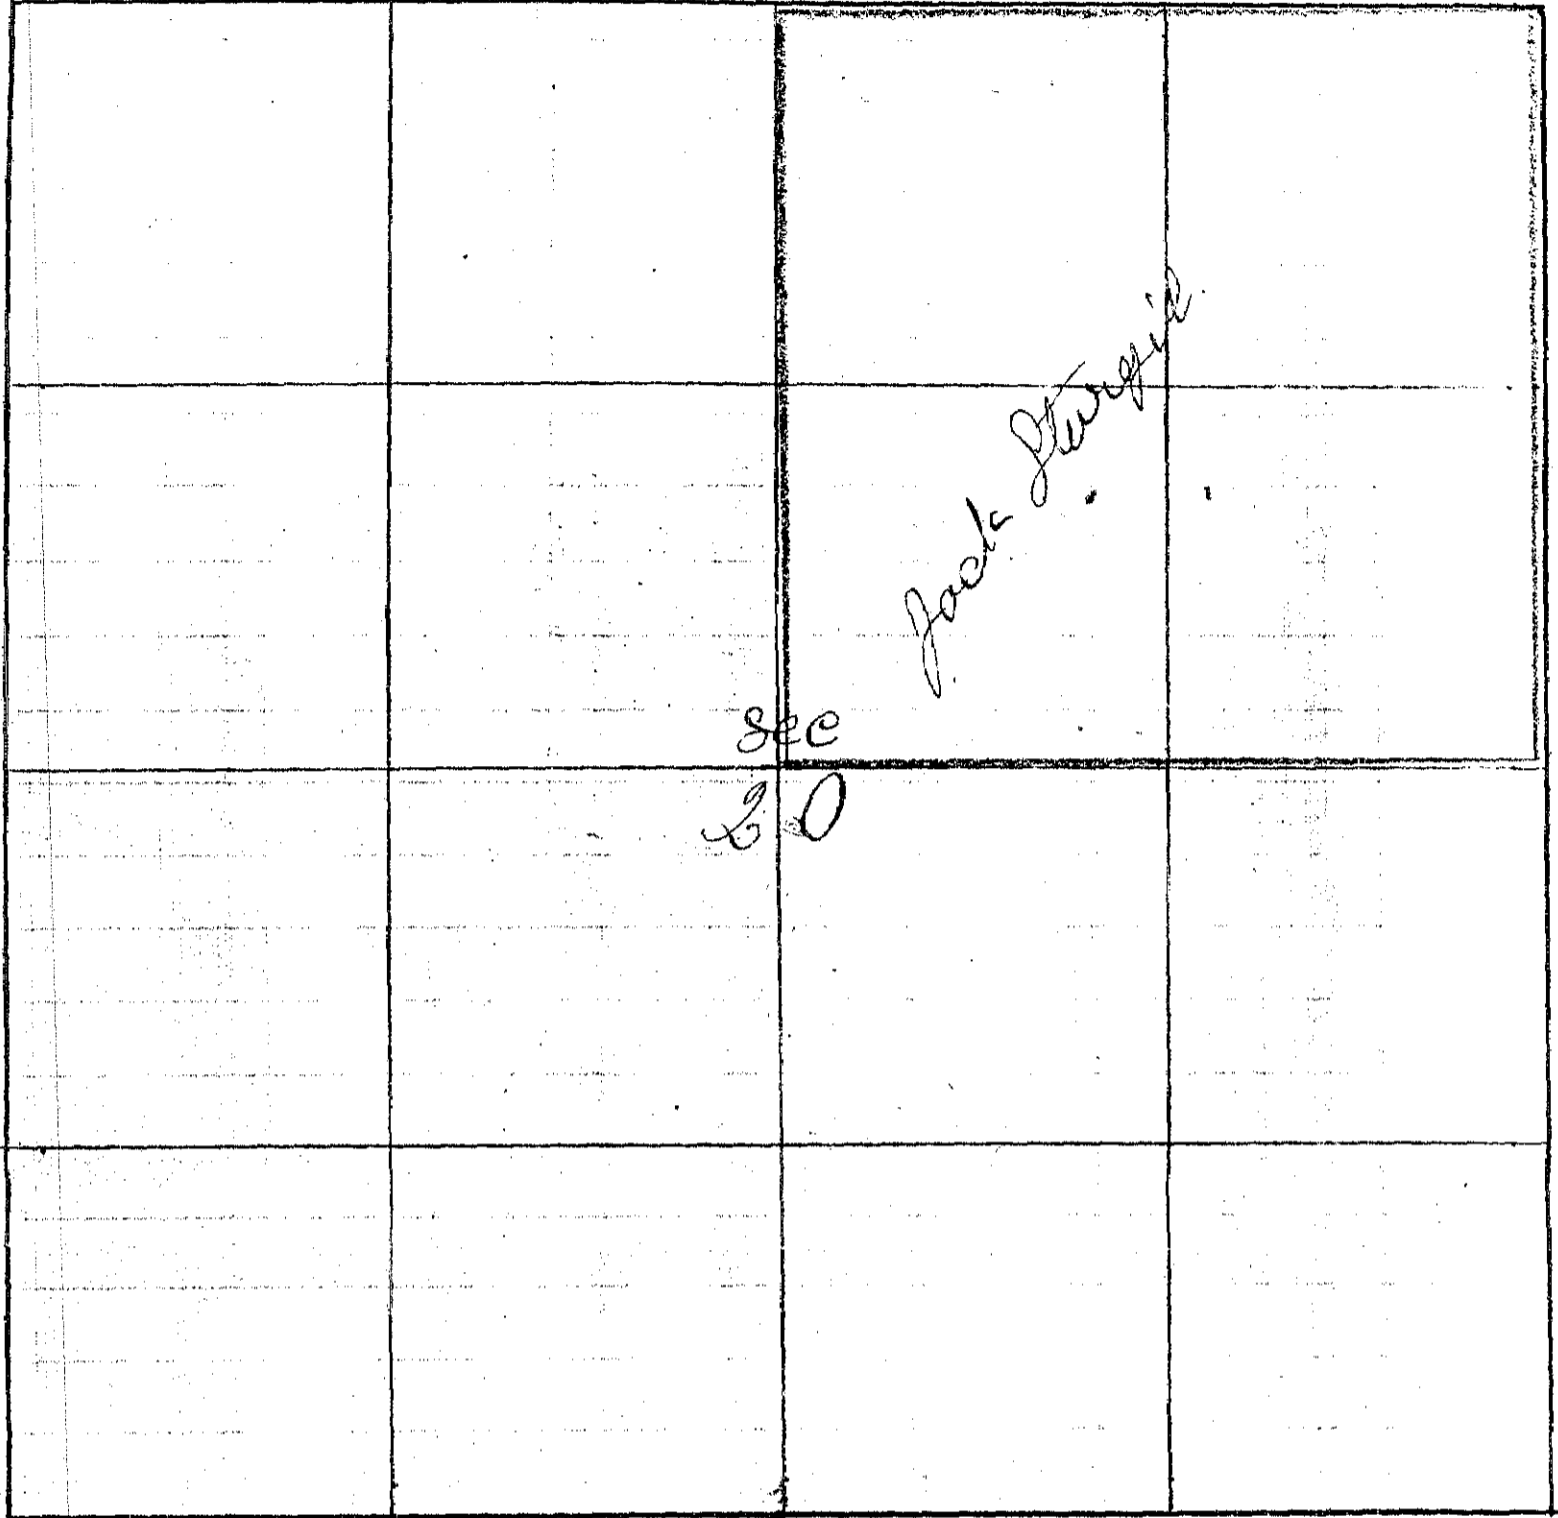

I Commenced at the 1/4 Sec Cor. bet Sec 17 & 20
 Thence South through Sec 20
 Var 20° E

40 00 Let Temporary Center Sec 20
 78 06 Intersect South Body Sec 20 68. W. East of 1/4 Sec Corner bet Sec 20 & 21
 Thence N 29° E on True line
 39 75 cuts

The 1/4 Sec Corner bet Sec 20 & 21
 Thence West through Sec 20
 Var 20° E

39 50 Intersect N.V. Line 100 W. North of 1st Gate at center

79 25 The 1/4 Sec corner bet Sec 19 & 20
 Thence East

39 63 Let Post for center Sec 20
 79 25 The 1/4 Sec Corner bet Sec 20 & 21

Witnessed at my Office