

RECORD OF SURVEY

No. 48

Township 3 South


Range 40 East W.M.

Union County, Oregon.

CHAINS. L.SS.

Mrs A. J. French Per L. B. Holmes agt. Sept 16 & 1888

I commenced at the $\frac{1}{8}$ corner on West Boundary N.W. $\frac{1}{4}$ Sec 31 on Guide Meridian previously set by me. a Post in Mid. of Earth
Thence North

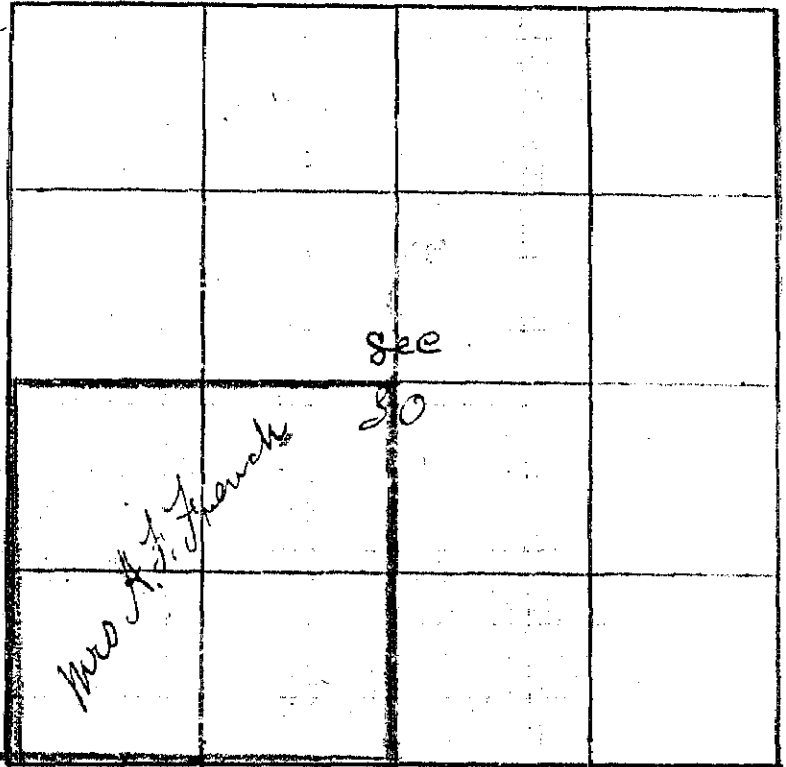

60 00 Set Temporary $\frac{1}{4}$ Sec corner and at

Var $20^{\circ} 15' E$

40 24 further on North the corner to Sec 19 = 30 = 24 & 25

Thence South on line

40 10 Set Stone $17 \times 6 \times 5$ inches for $\frac{1}{4}$ Sec corner bet Sec 30 & 25
Thence East through Sec 30
Var $20^{\circ} E$

20 00 Set Temporary $\frac{1}{16}$ corner

40 00 Set Temporary Center Sec 30

81 18 I intersected East Boundary Sec 30 but found no $\frac{1}{4}$ Sec corner
I then proceeded to the corner to Sec 19 = 20 = 29 & 30
which is a Post in Mound of Stone
Thence South bet Sec 29 & 30
Var $20^{\circ} E$

40 00 found no $\frac{1}{4}$ Sec corner Set Temporary $\frac{1}{4}$ Sec corner

80 40 I intersect 100 lks West of corner to Sec 29 = 30 = 31 & 32
Thence N $43^{\circ} W$ on true line

40 45 Set in Mound of Stone for $\frac{1}{4}$ Sec corner bet Sec 29 & 30
Thence West

40 59 Set Stone $6 \times 9 \times 18$ for Center Sec 30

60 88 Set Post for $\frac{1}{16}$ corner in Center W $\frac{1}{2}$ Sec 30

W. Kimball County Surveyor