

William W Gardner Oct. The 13<sup>th</sup> 1888

CHAINS. LES.

I Commenced at the Corner  
to Sec 25=26=35 & 36

Hence West bet Sec 26 & 35  
Var 20° 15' E

40 35 found no 1/4 Sec corner

80 70 found no Sec corner Set

Temporary corner to Sec 26=27=34 & 35-

Hence West bet Sec 27 & 34  
Var 20° E

Offset 50 lbs North on account of  
Hay Stack

Hence on Offset

1 00 Set back 50 lbs South on line

39 95 found no 1/4 Sec corner Set Temporary 1/4 Sec corner

80 13 Intersect N 1/2 Line 75 lbs North of the corner to Sec 27=28=33 & 34

Hence N 89° 28' E on true line


40 00 Set Post for 1/4 Sec corner bet Sec 27 & 34 in Slough or Mark

79 99 a Point in East Edge of Hutchinson Bros Hay Stack  
from which a witness Post bears E 10 lbs

a " " " E 24 "

a " " " N 30 "

a " " " N 50 "

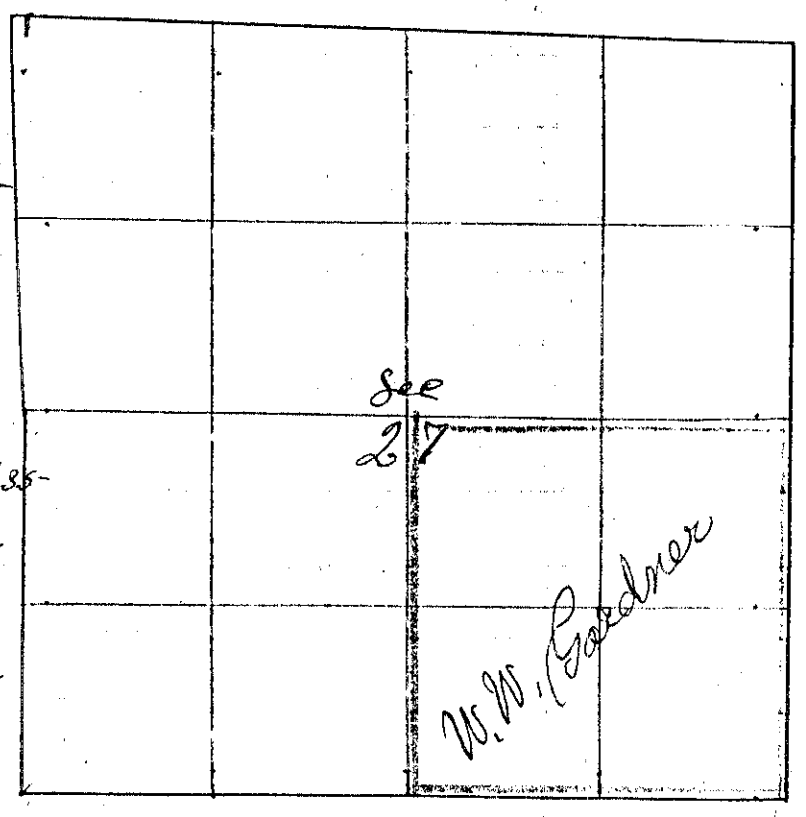

I Then Started at Light-Tree as per U.S. Field Notes  
on N 1/2 line bet T 6 & 7 S which is also bet Sec 4 & 33

Hence East bet Sec 4 & 33

Var 20° E

16 50 The 1/4 Sec corner bet Sec 4 & 33

Hence East

56 50 The corner to Sec 3=4=33 & 34 a Post in mound of Stone

Hence East bet Sec 3 & 34

40 50 found no 1/4 Sec corner Set Temporary 1/4 Sec corner

80 00 found no Sec corner

Hence East bet Sec 2 & 35-

40 42 The 1/4 Sec corner bet Sec 2 & 35-

The corner to Sec 22=23=26 & 27

a Post in mound of Stone

Hence S 21° E bet Sec 26 & 27 Var 20° E

40 50 found no 1/4 Sec corner Set Temporary 1/4 Sec corner

Township 6 South

Range 38 East

Union County, Oregon.

- 80 84 the corner to Sec 26=27=34 & 35 under Hay Stack  
Thence South
- 40 41 the 1/4 Sec corner bet Sec 34 & 35—  
Thence North
- 40 41 the corner to Sec 26=27=34 & 35— under Hulehinsens Hay Stack  
Thence  $N 2^{\circ} 00'$  bet Sec 26 & 27  
Var  $20^{\circ} E$
- 40 41 Set Stake under the ground & Stone marked 1/4 for 1/4 Sec corner bet Sec 26 & 27  
Thence West through Sec 27  
Var  $10^{\circ} E$
- 40 00 Set Temporary Center Sec 27
- 78 00 Intersect N & S line 60 lvs. West of 1/4 Sec corner bet Sec 27 & 28—  
The 1/4 Sec corner bet Sec 27 & 34.  
Thence  $N 1^{\circ} 20'$  Var  $20^{\circ} E$
- 40 20 Intersect True E & W line 15 lvs East of first Stake for Cent
- 82 70 Intersect North Boundary 90 lvs East of the 1/4 Sec cor bet Sec 22 & 27  
Thence  $S 2^{\circ} 18' E$  on true line
- 82 70 Set Stone 20 x 18 x 14 inches for Center Sec 27

J. W. Kimbrell County Surveyor