


Township 1 South Range 39 East W. M. Union County, Oregon.

Ed. Garies Oct the 1888

CHAINS
LIES.

I Commenced at the Corner
to Sec 20=21=28 & 29

Hence west to Sec 20 & 29
Bearing 20° E

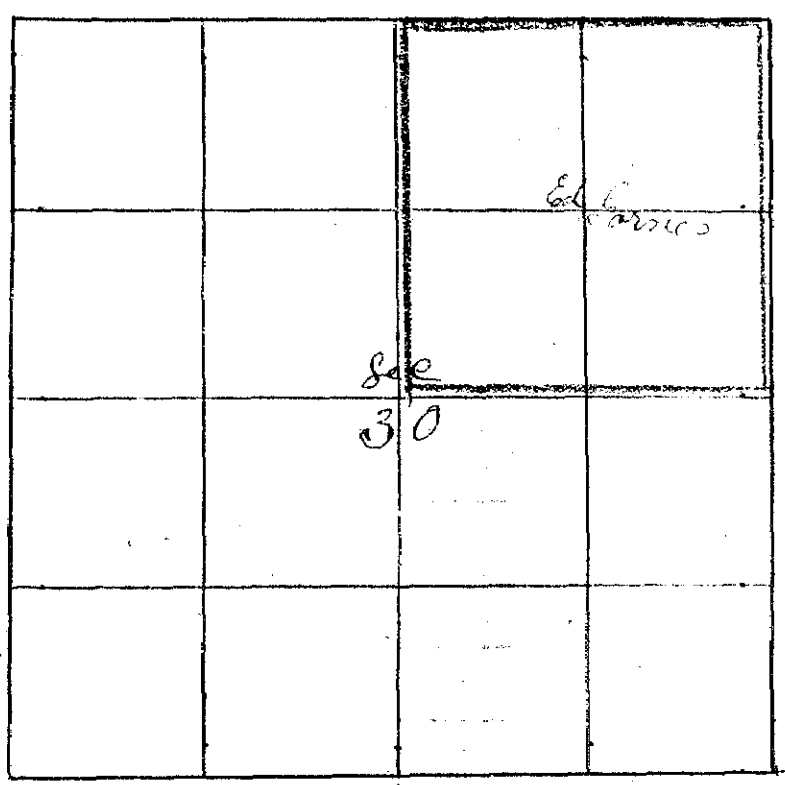

591 Grand Board River 347 ft across
Course N 20° East

3975 found no 1/4 Sec corner

5462 Set Temporary 1/8 corner

7950 found no Sec corner Set Temporary
Corner to Sec 19=20=29 & 30

Hence west to Sec 19 & 30
Bearing 20° E

4050 found no 1/4 Sec corner Set Temporary 1/4 Sec corner

8117 Intersect West Boundary at the Corner to Sec 19=30=24 & 25

Post decayed Set Stone 6x8x20 for corner to Sec 19=30=24 & 25
Hence East

3968 Set Stone 6x10x27 for 1/4 Sec corner to Sec 19 & 30

8017 Set Stone 5x7x12 for corner to Sec 19=20=29 & 30

Hence East

2077 Set Stone 6x9x14 for 1/8 corner

8048 The corner to Sec 20=21=28 & 29

The corner to Sec 19=20=29 & 30

Hence South to Sec 29 & 30 Bearing 20° E

4050 found no 1/4 Sec corner Set Temporary 1/4 Sec corner

8052 The corner to Sec 29=30=31 & 32

Hence North

4026 Set Stone 6x9x20 for 1/4 Sec corner to Sec 29 & 30

8052 The corner to Sec 19=20=29 & 30

The 1/4 Sec corner to Sec 29 & 30

Hence west through Sec 30
Bearing 20° E

4050 Set Temporary center Sec 30

8028 Intersect West Boundary found no 1/4 Sec corner
and Set Temporary 1/4 Sec corner

and Proceed to the corner to Sec 30=31=25 & 36
on Range line and run North

4012 Intersect Temporary 1/4 Sec Post

8024 The corner to Sec 19=30=24 & 25

Township 1 South

Range 39 East

Union County, Oregon.

- The corner to Sec 29=30=31 & 32
 Thence west bet Sec 30 & 31
 var 20° E
- 33 a Stone marked $\frac{1}{4}$ said to be set by M Austin Co Surveyor
 but as I have no Record of his or any other County Surveyors work
 am unable to recognize corner and I therefore Extended
 My line
- 33 I set Temporary $\frac{1}{4}$ Sec Corner
- 33 I intersect west Boundary at corner to Sec 30=31=25 & 26
 Thence East on line
- 41 $\frac{1}{2}$ Set a Stake for initial $\frac{1}{4}$ Sec corner 34 $\frac{1}{2}$ lks west of the above
 mentioned Stone marked $\frac{1}{4}$ by M. Austin
 Thence North through Sec 30
 var 20° E
- 22 Intersect True E & W line 55 lks west of first Stake at c. 21
- 40 Intersect at the $\frac{1}{4}$ Sec corner bet Sec 19 & 20
 Thence South
- 21 Set Stone 6 x 8 x 22 inches for Center Sec 30

J. W. Kimball County Surveyor