

RECORD OF SURVEY
No. 60

Township 3 South Range 36 East W.M., Union County, Oregon.

D. H. Ferguson


Dec. 12th 1888

CHAINS. LKS.

I commenced at
the 1/4 Sec corner
bet Sec 13 & 14
thence west

through Sec 14
var 20° E

40 00 Set temporary center
to Sec 14

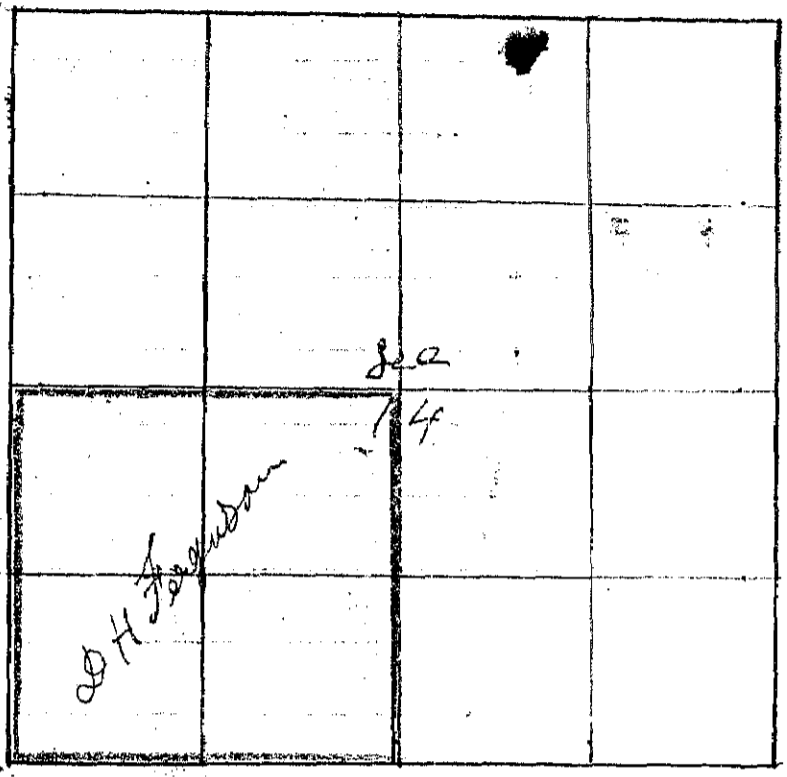

The 1/4 Sec corner
bet Sec 17 & 14

thence south through Sec 14
var 21° E

20 00 Set temporary 1/16 corner

40 00 Set temporary center Sec 14

82 18 I started 138 lks west of the 1/4 Sec
corner bet Sec 14 & 13

from which

a Pine 15 inches dia brs S 2° E 66 lks dist.

" 21 " " " N 15° W 122 " "

thence N 59° W on same line
var 20° E

41 09 Set Post in Mound of Stone for
Center Sec 14

61 63 Set Post for 1/16 corner in center N 1/2 Sec 14

J. W. Kimball County Surveyor