

Township 2 South

Range 37 East W.M.

Union County, Oregon.

Porter Ripley

Dec. 13<sup>th</sup> 1888

I Commenced at the 1/4 Sec corner  
bet Sec 31 & 32

Thence South bet Sec 31 & 32 var 20° E

6 75 Grande Round River 172 lks across runs East

20 00 Set Temporary 1/8 corner


40 10 Intersect 15 lks East of the corner to Sec 31-32-54-6

Thence North 13° E on true line

20 00 Set Post var 15° 30' E

20 05 Set Post for 1/8 corner

40 10 The 1/4 Sec corner bet Sec 31 & 32

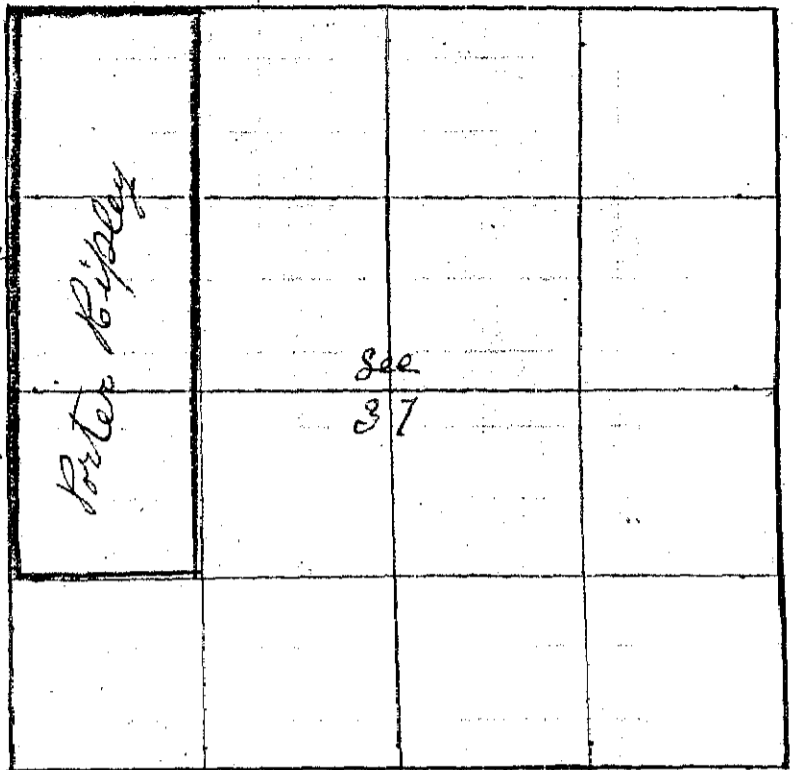

The corner to Sec 5-6-31 & 32

Thence West bet Sec 6 & 31

var 15° 30' E

4 50 var 19° 30' E

20 00 Set Temporary 1/8 corner

30 00 right Bank of Grande Rounde River Course N 85° E

33 40 left Bank of Grande Rounde River " N 85° E

39 94 The 1/4 Sec corner bet Sec 6 & 31

from which

a Cottonwood 15 inches dia bet N 75° E 94 lks dist.

41 00 left Bank of Grande Rounde River Course S 85° E

46 75 Right Bank of Grande Rounde River Course S 85° E

80 59 Intersect 11 South of corner to Sec 1-6-31 & 31

Thence S 84° 56' E on true line

20 50 Set Post for 1/8 corner

from which

a fir 8 inches dia bet S 42° E, 8 lks dist.

" 4 " " " N 59° W 6 1/2 " "

60 62 Set Post for 1/8 corner

from which

a Pine 4 inch dia bet N 5 1/4° W 7 lks dist.

" 11 " " " S 5 1/2° E 16 " "

80 59 The corner to Sec 5-6-31 & 32

The 1/8 corner on East Boundary S E 1/4 Sec 31

Thence West through S 1/2 Sec 31

12 50 Grande Round river 160 lks across Course North 5° E

81 25 Intersect West Boundary Sec 31 at the 1/8 corner

60 95 Set Post for 1/8 corner Thence East in center S E 1/4 Sec 31

J.W. Tombrill County Surveyor