


Jessie Imbler Dec 17 1888

CHAINS LKS.

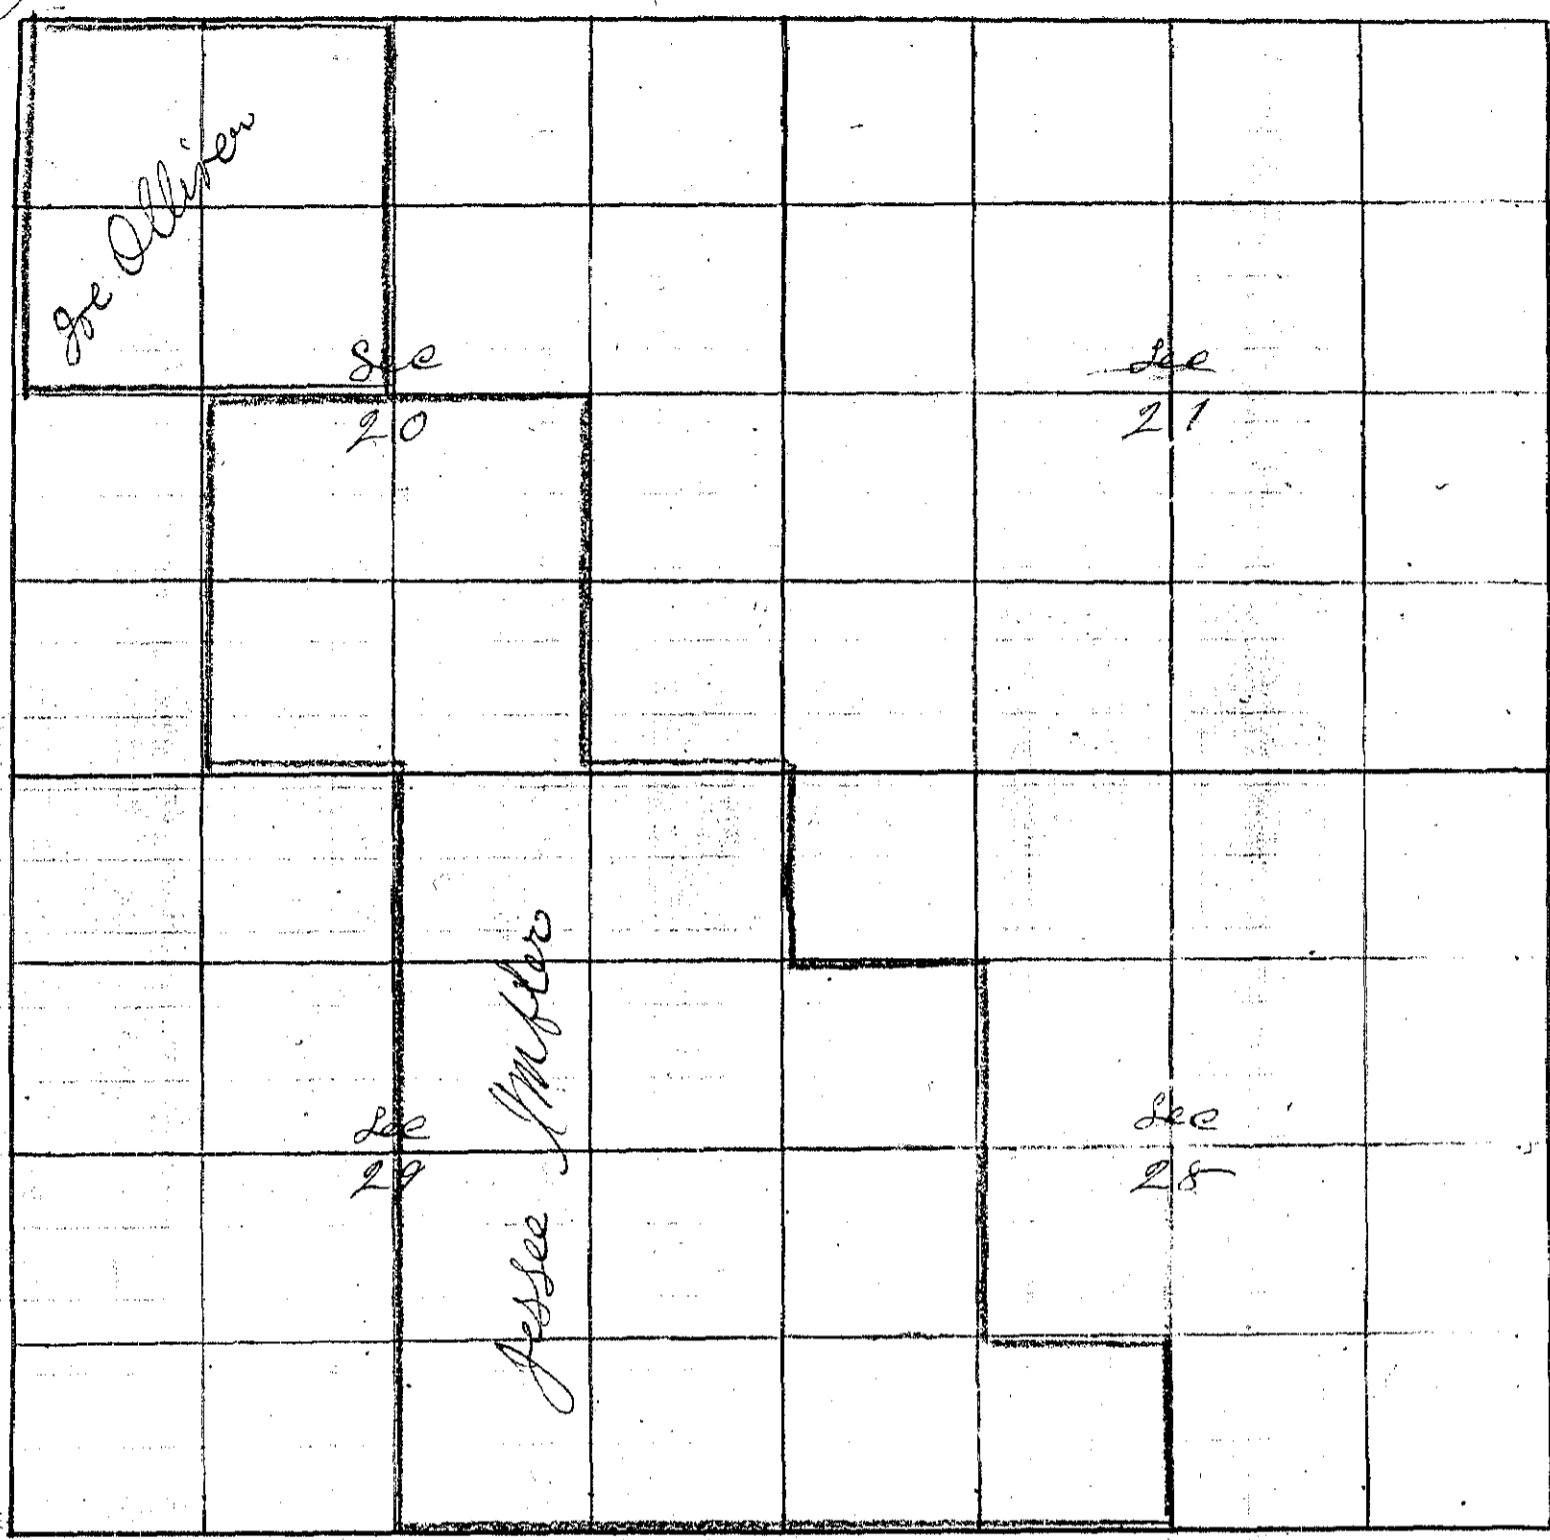

I Commenced at the 26=27=34 & 35  
 which is a Post in Mound of Stone  
 On West Slope of Mountain on East Side of Grand Board River  
 Thence West to Sec 27 & 34

Var 20° S

Descend Steep Mountain Side

79 74 The Corner to Sec 27=28=33 & 34

Thence West to Sec 28 & 33

39 04 Grande Board River 189 lks across course N 40° W

40 93 Set Temporary 1/4 Sec Corner

80 00 Set Temporary Corner to Sec 28=29=32 & 33

Thence West-

Offset 500 lks South

Thence West on Offset-

20 00 Set Back 500 lks North on line

40 05 Set Temporary 1/4 Sec Corner

81 55 Intersect the corner  
to Sec 29=30=31 & 32

Hence East bet Sec 29 & 32

43 42 Set Stone 6 x 8 x 16 for 1/4 Sec Corner bet Sec 29 & 32

50 84 Set Stone 10 x 12 x 18 for corner to Sec 28 = 29 = 32 & 33

Hence East bet Sec 28 & 33

40 12 Set Stone 6 x 9 x 18 for 1/4 Sec corner bet Sec 28 & 33  
on left Bank of Grande Round River

The Corner to Sec 4 = 5 = 32 & 33

Hence North bet Sec 32 & 33

Var 20° E

40 59 found no 1/4 Sec corner

50 18 Intersect East & West line at corner to Sec 28 = 29 = 32 & 33

Hence North bet Sec 28 & 29

Var 20° E

1 80 Grande Round River 163 lks across Course West

40 00 Set Temporary 1/4 Sec corner

59 62 Grande Round River 185 lks across Course East

68 70 " " " 185 " " " West

80 18 Intersect 30 lks East of corner to Sec 20 = 21 = 28 & 29

Hence South 13' E on True line

40 09 Set Wheel of Mower for 1/4 Sec corner bet Sec 28 & 29

80 18 The corner to Sec 28 = 29 = 32 & 33

The Corner to Sec 20 = 21 = 28 & 29

Hence North bet Sec 20 & 21

Var 20° E

6 92 Grande Round River 321 lks across Course N 45° E

40 00 found no 1/4 Sec corner Set Temporary 1/4 Sec corner

50 56 The corner to Sec 16 = 17 = 20 & 21

Hence South

40 28 Set Post in Mound of Earth 1/2 E & 1/2 W for 1/4 Sec corner bet Sec 20 & 21

80 50 The corner to Sec 20 = 21 = 28 & 29

The corner to Sec 5 = 6 = 7 & 8

Hence South

19 90 Willow Creek 25 lks across runs East

39 70 rail fence E & W

40 60 fence E & W

80 20 rail fence E & W

Hence South

80 00 found no corners to Sec 17 = 18 = 19 & 20

CHAINS. LKS.

80 52 The corner to Sec 19=20=29 & 30  
from which I run North on line  
bet Sec 19 & 20 var 20° E

40 25 Set Stone 6 x 9 x 16 for 1/4 Sec corner bet Sec 19 & 20

80 50 Set Stone 8 x 9 x 20 inch for corner to Sec 17=18=19 & 20  
thence East bet Sec 17 & 20  
var 20° E

39 85 Set Temporary 1/4 Sec corner

79 70 found no corner Set Temporary corner to Sec 16=17=20 & 21

39 57 found no 1/4 Sec corner

79 14 found no corner to Sec 15=16=21 & 22  
thence East

11 00 Grande Round River 250 lks across course N 10° W

42 25 Intersect the 1/4 Sec corner bet Sec 15 & 22  
thence West allowing 32 lks excess  
to back 1/2 mile over U.S. field note  
to corner to Sec 16=17=20 & 21  
thence West

40 17 Set Stone 6 x 8 x 18 for 1/4 Sec corner bet Sec 17 & 20

80 34 The corner to Sec 17=18=19 & 20

The corner to Sec 19=20=29 & 30  
thence East bet Sec 20 & 29  
var 20° E

20 11 The 1/8 corner on South Boundary SW 1/4 Sec 20

40 00 Set Temporary 1/4 Sec corner

60 00 Set Temporary 1/8 corner

71 00 Grande Round River 347 lks across under Halls  
Bridge course of River N. 20° E

80 38 To the corner to Sec 20=21=28 & 29  
thence West

20 09 Set Stone 6 x 10 x 20 inch for 1/8 corner

40 18 Set Stone 6 x 9 x 22 in for 1/4 Sec corner bet Sec 20 & 29

60 27 The 1/8 corner

80 38 The corner to Sec 19=20=29 & 30  
The 1/4 Sec corner bet Sec 19 & 20 thence East

80 20 The 1/4 Sec corner bet Sec 20 & 21 thence West

20 05 Set Stone for 1/16 corner

40 10 Set Stone for center Sec 20

60 15 Set Stone for 1/16 corner

80 20 The 1/4 Sec corner bet Sec 19 & 20

40 22 The center Sec 20  
80 45 The 1/4 Sec corner bet Sec 20 & 29  
W. Kimball County Survey 5