

Township 2 South


Range 39 East W.M.

Union County, Oregon.

CHAINS. LKS.

James Moss

Dec. The 28<sup>th</sup> 1888

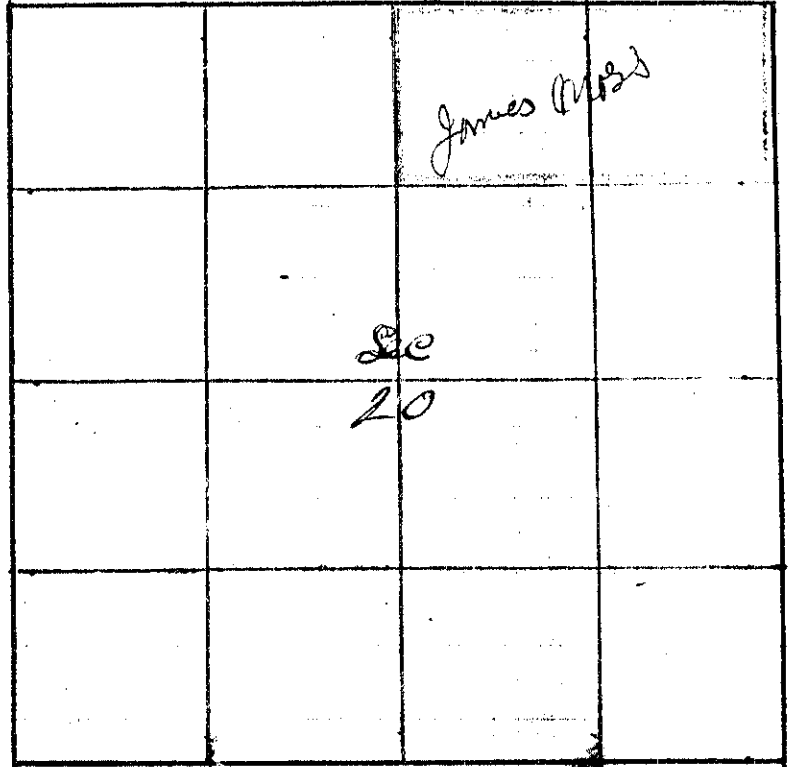

I Commenced at the corner  
 Fr Sec 16 = 17 = 20 & 21  
 Thence South set Sec 20 & 21  
 for 20° E

20 00 Set Temporary 1/4 corner

40 00 Set Temporary 1/4 Sec corner

80 16 The corner to Sec 20 = 21 = 28 & 21

Thence North

40 08 Set Stone 9 x 6 x 20 for the 1/4 Sec corner set Sec 20 & 21

60 12 Set Stone 6 x 8 x 23 for 1/4 corner on East side NE 1/4 Sec 20

80 16 The corner to Sec 16 = 17 = 20 & 21

The corner to Sec 20 = 21 = 28 & 29

Thence West set Sec 20 & 29  
for 25° E

40 02 1/2 Set Temporary 1/4 Sec corner

80 05 Set Temporary corner to Sec 19 = 20 = 29 & 30

Thence West set Sec 19 & 30

40 00 Set Temporary 1/4 Sec corner

78 02 Intersect West Boundary

Thence East

38 16 Set Stone 6 x 9 x 18 for 1/4 Sec corner set Sec 19 & 30

78 45 The corner to Sec 19 = 20 = 29 & 30

Thence East

40 31 Set Post for 1/4 Sec corner set Sec 20 & 29

80 63 The corner to Sec 20 = 21 = 28 & 29

The corner to Sec 17 = 18 = 19 & 20

Thence South set Sec 19 & 20

for 19° 05' E

40 00 Set Temporary 1/4 Sec corner

80 00 Set Temporary corner to Sec 19 = 20 = 29 & 30

Thence South set Sec 29 & 30

for 18° 45' E

40 00 Set Temporary 1/4 Sec corner

80 00 Set Temporary corner to Sec 29 = 30 = 31 & 32

Thence South set Sec 31 & 32

for 19° 35' E

- 41 06 The  $\frac{1}{4}$  Sec Corner bet Sec 31 & 32  
making an Excess of 106 lbs as per U.S. Field Notes  
Thence North var  $19^{\circ} 30' E$ .
- 40 21 Set Post for Temporary corner to Sec 29 = 30 = 31 & 32  
Thence North bet Sec 29 & 30 var  $18^{\circ} 45' E$
- 40 21 Set Stake for  $\frac{1}{4}$  Sec Corner
- 80 42 Set Post for Corner to Sec 19 = 20 = 29 & 30  
Thence North bet Sec 19 & 20  
var  $19^{\circ} E$
- 40 21 Set Stake for  $\frac{1}{4}$  Sec Corner bet Sec 19 & 20
- 80 42 The corner to Sec 17 = 18 = 19 & 20
- The  $\frac{1}{4}$  Sec corner bet Sec 20 & 29  
Thence North through Sec 20
- 33 50 Set Temporary fractional corner
- 40 05 Set Temporary center Sec 20.
- 60 22 Set Temporary  $\frac{1}{16}$  corner
- 80 32 The  $\frac{1}{4}$  Sec corner bet Sec 17 & 20  
Thence South
- 20 08 Set Stone 8 x 8 x 18 for  $\frac{1}{16}$  corner in center  $\frac{1}{2}$  Sec 20
- 40 16 The center Sec 20
- 50 26 Set Stone 6 x 9 x 22 for fractional corner bet Oliver & Loyde
- The  $\frac{1}{4}$  Sec corner bet Sec 19 & 20  
Thence East through Sec 20
- 40 31 Intersect N & S line at center Sec 20
- 80 78 The  $\frac{1}{4}$  Sec corner bet Sec 20 & 21

## Note

The Point for corner to Sec 19 = 20 = 29 & 30 which I determined by proportional measurement from known corner to known corner E & W N & S, is in dispute by some of the settlers as to the point East and West and think they can prove the original location to be about 120 lbs west. But as I have retraced the whole distance E & W from Range line to Range line and find the excess to be the same as it is bet Sec 20 & 29 and 19 & 30 57 lbs to each mile over the U.S. Field Notes showing conclusively that the chaining was done about the same throughout the Township.

W. H. Kimbell County Surveyor