


Township 2 South Range 39 East W.M. Union County, Oregon.

Wm. Sailing

Dec 29th 1888

CHAINS. LRS.

I commenced at the 1/4
Sec corner bet Sec 29 & 30
thence west through
Sec 30 to 20° E

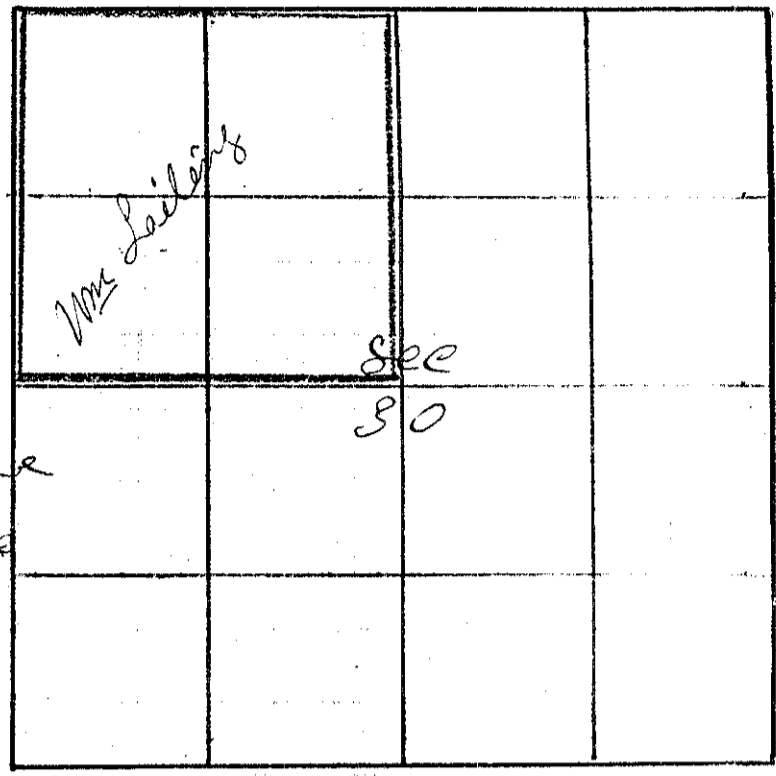

40 00

Set Temporary Center Sec 30

77 76

Intersect West Boundary at 1/4 Sec corner
bet Sec 30 & 25 on Range
line bet Ranges 38 & 39

The corner to Sec 30 = 31 = 25 & 36
thence East bet Sec 30 & 31

38 75

Set Temporary 1/4 Sec corner

78 75

Set Temporary corner to Sec 29 = 30 = 31 & 32
thence East

79 06

The corner to Sec 28 = 29 = 32 & 33
making a deficiency of 82 lks in the 2 miles.
I therefore run west
allowing 20 & 21 lks deficiency on each 1/2 mile

79 43

Set Temporary corner to Sec 29 = 30 = 31 & 32
thence West

40 79

Set Stake for 1/4 Sec corner bet Sec 30 & 31
thence North

40 21

Intersect True E & W line

80 34

Intersect North Boundary Sec 30 at the 1/4 Sec corner bet
thence South through Sec 30

40 18

Set 6 + 10, + 28 sides for center Sec 30

J.W. Kimball County Surveyor