


W.A. Boughnawo

March the 8 1889

CHAINS. LKS.

I Commenced at the 1/4 Sec. Corner bet Sec 15 & 22. Which is a Post in Mound of Earth Pits &c

Thence west bet Sec 15 & 22  
Var 20° E

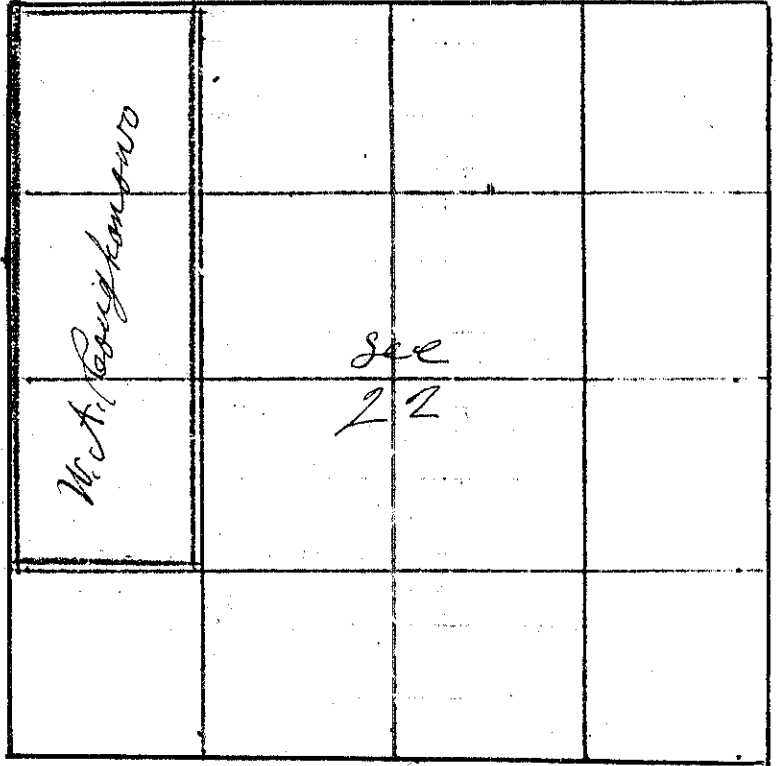

20 00 Let temporary 1/8 corner

39 91 Intersect 25 lks South of the corner to Sec 15-16-21 & 22

Thence S 89° 39' E on same line bet Sec 15 & 22

19 45 Let Post for 1/8 corner on North Boundary N. W. 1/4 Sec 22

27 56 County Road N 15° W S 15° E

39 91 The 1/4 Sec corner bet Sec 15 & 22

The corner to Sec 21-22-27 & 28

Thence North bet Sec 21 & 22

Var 20° E

40 08 Intersect 17 lks East of the 1/4 Sec corner bet Sec 21 & 22

Thence S 15° E on same line

20 04 Let Post for 1/8 corner

40 08 The corner to Sec 21-22-27 & 28

The corner to Sec 22-23-26 & 27

Thence west bet Sec 22 & 27

Var 18° 30' E

44 00 Offset 203 lks South North Powder River 122 lks across North

52 00 Let Back 203 " North to line

60 00 Let Temporary 1/8 corner

79 26 Intersect 92 lks North of corner to Sec 21-22-27 & 28

Thence N 89° 21' E on same line

19 8 1/2 Let Post for 1/8 corner

79 92 Thence North through center W 1/2 Sec 22

79 92 The 1/8 corner on North Boundary N. W. 1/4 Sec 22

Thence South through center W 1/2 Sec 22

59 94 Let Post for 1/8 corner in center S. W. 1/4 Sec 22

Thence west

19 8 4 The 1/8 corner on west Boundary S. W. 1/4 Sec 22

W.A. Boughnawo County Surveyor