

Township 4 South

Range 40 East


Union County, Oregon.

CHAINS
LKS.

For Union County Oregon

April the 3rd 1889

I commenced at the corner to
Sec 18 = 19 = 13 & 24 on Said
Meridian bet Ranges 39 & 40 East
Thence East bet Sec 18 & 19
Offset 250 links South to Street
Thence on offset East var 20° E

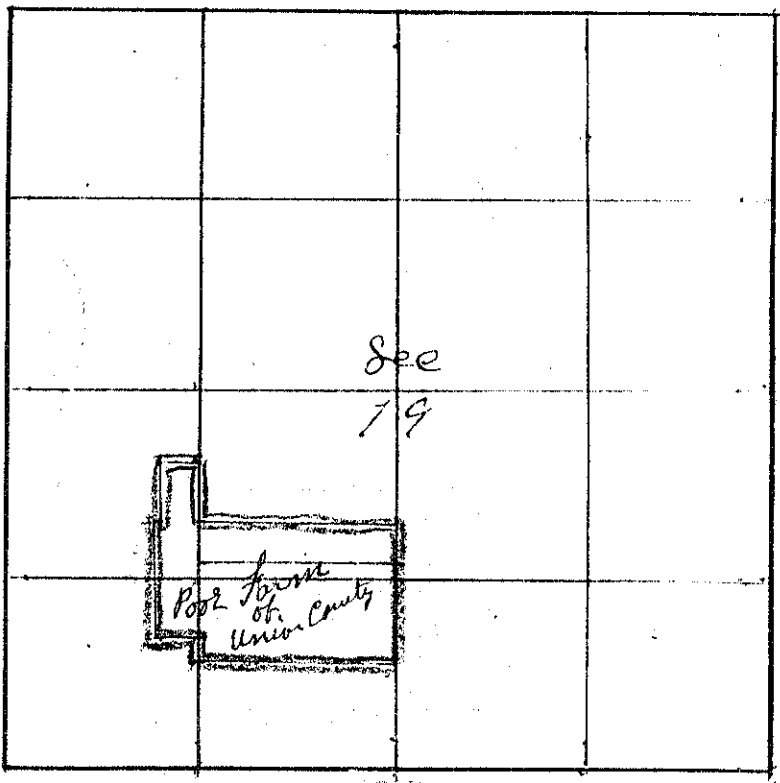

20 00 Set Temporary 1/2 corner
40 00 found no 1/4 Sec corner
80 00 found no Sec corner
Thence East bet Sec 17 & 20
var 20° E

40 37 Intersect 26 lks South of the 1/4 Sec corner bet Sec 17 & 20
Making an Excess of 18 lks as per U.S. Field Notes
The falling would be therefore
3 lks East and 4 1/2 lks North to each 1/4 mile
Thence S 89° 53' W on same line

100 28 Set an Iron Bolt 1/2 inches in diameter and 8 inches long
in Center of Grade at North End of Bridge
over Catherine Creek

The Corner to Sec 18 = 19 = 13 & 24
Thence South on Said Meridian
bet Sec 19 & 24
var 20 15' E

80 25 The Corner to Sec 19 = 30 = 24 & 25
Thence East bet Sec 19 & 30
var 25° E

19 80 Set Temporary 1/2 corner
40 03 Intersect 35 lks South of 1/4 Sec corner bet Sec. 19 & 30
Thence S 89° 30' W on same line

20 10 Set Stone 7 x 10 x 12 for 1/2 corner on South boundary S W 1/4 Sec 1,
Thence North through Center W Sec 19
var 20° E

80 32 The 1/2 corner on North boundary NW 1/4 Sec 19
Thence South through center W Sec 19

40 25 Set Stone 22 x 8 x 6 for center W Sec 19
Thence South 52 1/4 feet Set Stone 3 x 6 x 30 Thence West 208 1/2 feet Set
Stone 5 x 7 x 12 Thence South 417 feet Set Stone 7 x 7 x 18 inches
Thence West 45 feet Set Stone 4 x 10 x 18 Thence South 348 1/2 feet Set
Stone 5 x 9 x 24 Thence East 253 1/2 feet Set Stone 4 x 6 x 20 inches

Township

Range

Union County, Oregon.

Hence North 34 1/2 feet set Stone 4 x 5 x 18 inches Hence North
417 feet To Place of Beginning in Lobbs charts from yard

also commencing at a point - 250 Yards North
of the S E Corner of the S W 1/4 of Section 19
Set a Stone 8 x 6 x 24 Hence North
var 20° E

- 10 00 Set Stone 8 x 12 x 18 inches
Hence North
- 5 00 Set Stone 7 x 11 x 21 inches
Hence west
- 20 17 Set Stone 3 x 12 x 24 inches
Hence South
- 5 00 Set Stone 8 x 7 x 18 inches
Hence South
- 10 00 Set Stone 8 x 10 x 22 inches
Hence East
- 20 22 To Place of Beginning -

J. W. Kimball County Surveyor