


Township 3 South Range 38 East W.M. Union County, Oregon.

CHAINS. LKS.

Summer and Baker Per. Miller Bros. June the 12<sup>th</sup> 1889

I Commenced at the corner  
To Sec 5-6-31 & 32 on the  
T<sub>10</sub> line bet of 2, 3, 3S.  
Thence west on T<sub>10</sub> line to Sec 6 & 31  
Varo 20° E

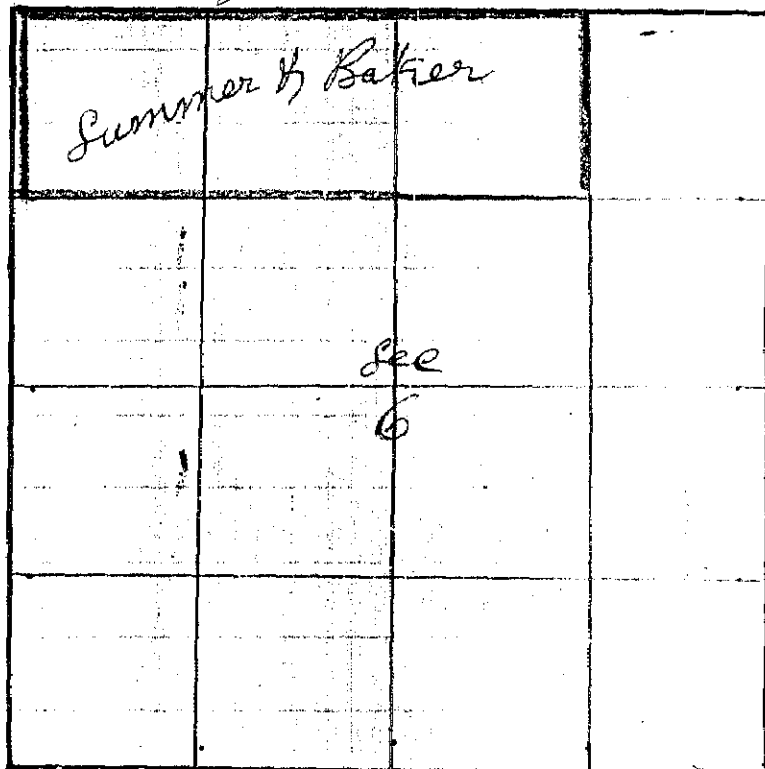

10 09 fence N 1/2 S

20 00 Set Temporary 1/8 corner

20 05 fence N 1/2 S

25 25 creek 25 lks ~~across~~ course S E

40 00 found no 1/4 Sec corner

Set Temporary 1/4 Sec corner

51 00 Rail Road S 41° E N 41° W

60 00 Set Temporary 1/8 corner

77 32 The corner to Sec 1-6-31 & 36 which is also the  
corner to T<sub>2</sub> & 3 S Ranges 37 & 38 East-  
stone 6x10x22 from which

a Pine 24 inches dia. bearing N 65° E 182 lks dist

" 24 " " " S 55° E 465 " " cut down and recage

marked " 5 " " " S 51° E 370 " "

Thence East

17 20 Set Post for 1/8 corner

37 24 Set Stone 6x12x25 for 1/4 Sec corner bet Sec 6 & 31

57 28 Set Stone 6x8x29 for 1/8 corner

77 32 The corner to Sec 5-6-31 & 32

Thence South bet Sec 5 & 6

19 45 U.S. field notes Set Temporary 1/8 corner

39 50 The 1/4 Sec corner bet Sec 5 & 6

Thence North

20 22 1/2 Set Post for 1/8 corner

39 50 The corner to Sec 5-6-31 & 32

The 1/4 Sec corner bet Sec 6 & 31

Thence South through Sec 6

Varo 20° E

10 00 Rail Road S E & N W

19 77 Set Temporary 1/8 corner

39 68 Set Temporary center Sec 6

80 00 Interest 69 lks West of 1/4 Sec corner bet Sec 6 & 17

Township 3 South

Range 38 East

Union County, Oregon.

CHAINS  
LRS.

The corner to Sec 1-6-31 & 36  
thence South bet Sec 1 & 6  
Var 20° E

20 50 Set Temporary 1/2 corner  
40 16 Intersect 37 lks East of the 1/4 Sec corner bet Sec 1 & 6  
from which  
a Pine 24 inches dia. frs S 85° E 168 lks dist  
thence North 32" E on true line

20 28 Set Post for 1/8 corner  
40 16 The corner to Sec 1-6-31 & 36

The 1/4 Sec corner bet Sec 5 & 6  
thence West through Sec 6 Var 20° E

7 20 Rail Road S E & N W  
14 35 creek S E

20 50 Set Temporary 1/16 corner  
35 23 wire fence N & S  
40 24 Intersect true N & S line

The 1/8 corner on East Boundary N E 1/4 Sec 6  
thence West through N 1/2 Sec 6 Var 20° E

9 65 creek 10 lks across course South  
20 50 Set Temporary 1/16 corner  
29 25 Rail Road N W & S E  
33 42 Picket fence N & S A. Langloff's Orchard and Garden  
39 87 Picket fence N W & S E same Garden & Orchard  
40 14 Intersect true N & S line

78 59 The 1/8 corner on West Boundary N W 1/4 Sec 6  
thence East through center N 1/2 Sec 6

38 59 Set Stone 6 x 10 x 28 for 1/16 corner in center N 1/2 Sec 6  
58 66 The center N E 1/4 Sec 6.

78 59 The 1/8 corner on East Boundary N E 1/4 Sec 6

The 1/16 corner in center E 1/2 Sec 6  
thence North through E 1/2 Sec 6

39 68 Intersect 19 lks East of 1/8 corner on North Bdy N E 1/4 Sec 6  
thence S 16" E on true line

19 84 Set Stone 6 x 9 x 17 for 1/16 corner in center N E 1/4 Sec 6

W. L. ...