

RECORD OF SURVEY

1889

No 83

Township 3 South

Range 38 & 39 E W.M.

Union County, Oregon.

Mrs Mahaffey

June 23 1884

"Commenced at The Corner  
to Sec 13 = 24 = 18 & 19  
on Range line between  
Ranges 38 & 39 E

40 10


Thence North bet Sec 18 & 18  
The 1/4 Sec corner bet Sec 13 & 18  
Thence South bet Sec 13 & 18  
Cor 20° E

40 10

The Corner to Sec 13 = 24 = 18 & 19  
Thence South  
bet Sec 24 & 19  
on Range line bet Sec Ranges  
38 & 39 East

40 21

The 1/4 Sec corner bet Sec  
24 & 19

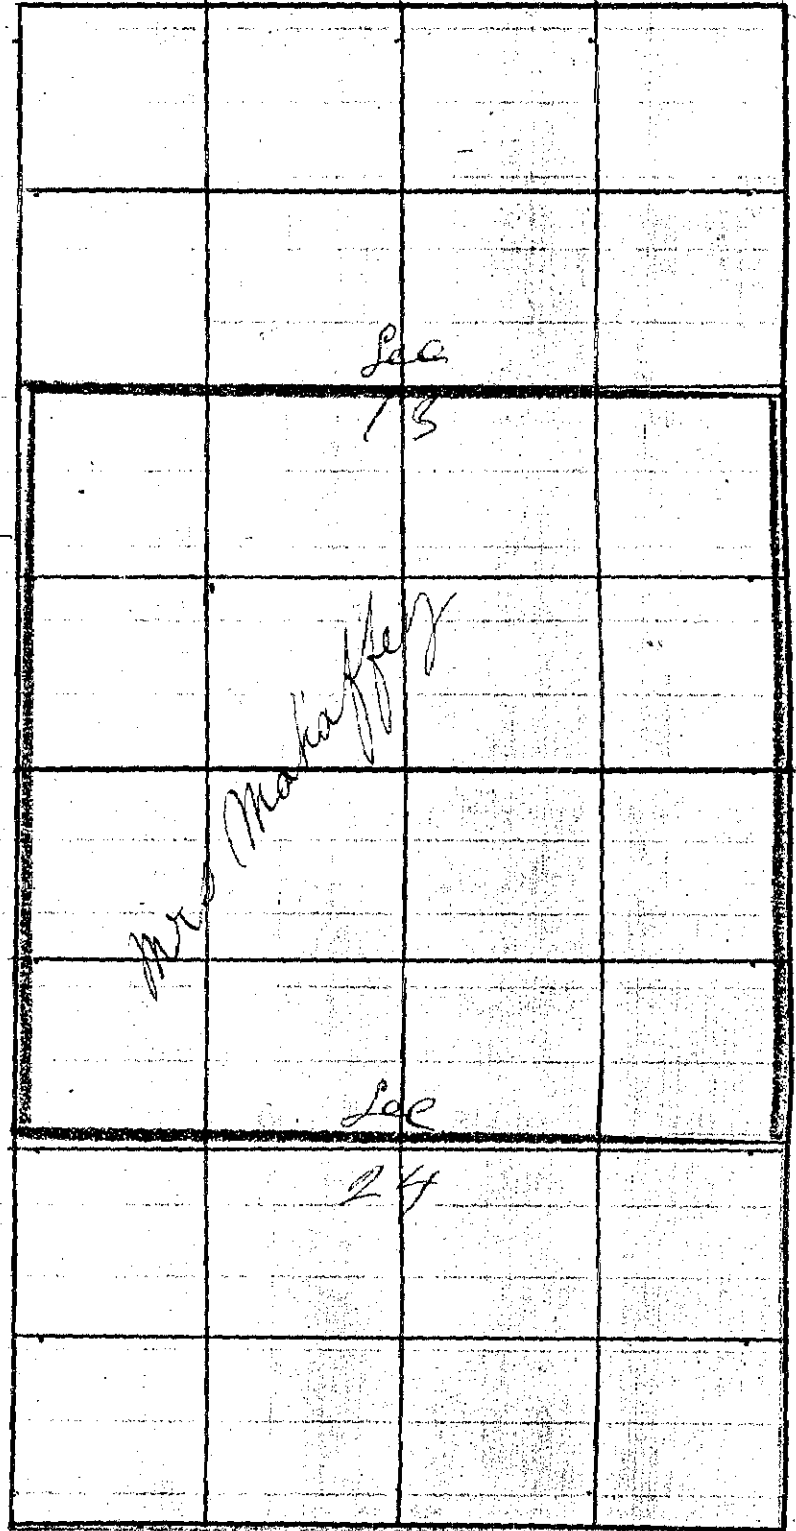

J. W. Smithell County Surveyor